IREDELL COUNTY HEALTH DEPARTMENT

Authorization to Construct

STATESVILLE 704-878-5305 MOORESVILLE 704-664-5281

IMPROVEMENT PERMIT / ~~CERTIFICATE OF COMPLETION~~ / OPERATION PERMIT / EXISTING SYSTEM INSPECTION

PROPERTY DESCRIPTION NO. 22434 DATE 12/27/95 TAX MAP NO. 2E 12 A 15 Watershed: ☒ Yes ☐ No

OWNER OR CONTRACTOR John Winland Homes PHONE: Business 522-9200 ~~Home~~ 4625-69-0770

ADDRESS 8325-D Research Blvd. Charlotte NC. 28115

LOCATION Bray Sch TR Bay Harbour TL Lake Mist Dr. TL Bay Port Ln. 2nd lot on (L)

SUBDIVISION Harbour BLOCK / SECTION 1 MB LOT 15 LOT AREA .53A SITE CLASS. PS DESIGN FLOW 480 L.T.A.R. .3

Septic Tank: 1000 Gallons; STB 794 Date 11/28/95

Pump Tank: _____ Gallons; PT _____ Date _____

Pump Make: _____ Model _____ Serial No. _____

Nitrification Field: No Fields 1 Square Feet 1600 Linear Feet 400 (533)

No Lines 6 Trench Width 36" Max Trench Bottom Depth 36" Gravel Depth N/A

☒ New System ☐ Repair System Type: I, II, (III) IV, V, VI

System Description: GRAV - INFILTRATOR

Repair System Description: PANEL

Maintenance Agreement Required: ☐ Yes ☒ No

☒ House/Mod. Home ☐ Mobile Home ☐ Business ☐ Other

No. Bedrooms 4 No. Bathrooms 4 No. Employees _____


☐ Slab ☒ Crawl Space ☐ Basement w/plumbing ☐ Basement wo/plumbing

Water Supply: ☐ Individual ☒ Community ☐ Public


Comments: ☒ 400 feet gravity INFILTRATOR SAND REQUIRED TO BACKFILL TO TOP OF LOUVERS

Comments: 111 Bayport Ln.

INITIAL SITE SKETCH

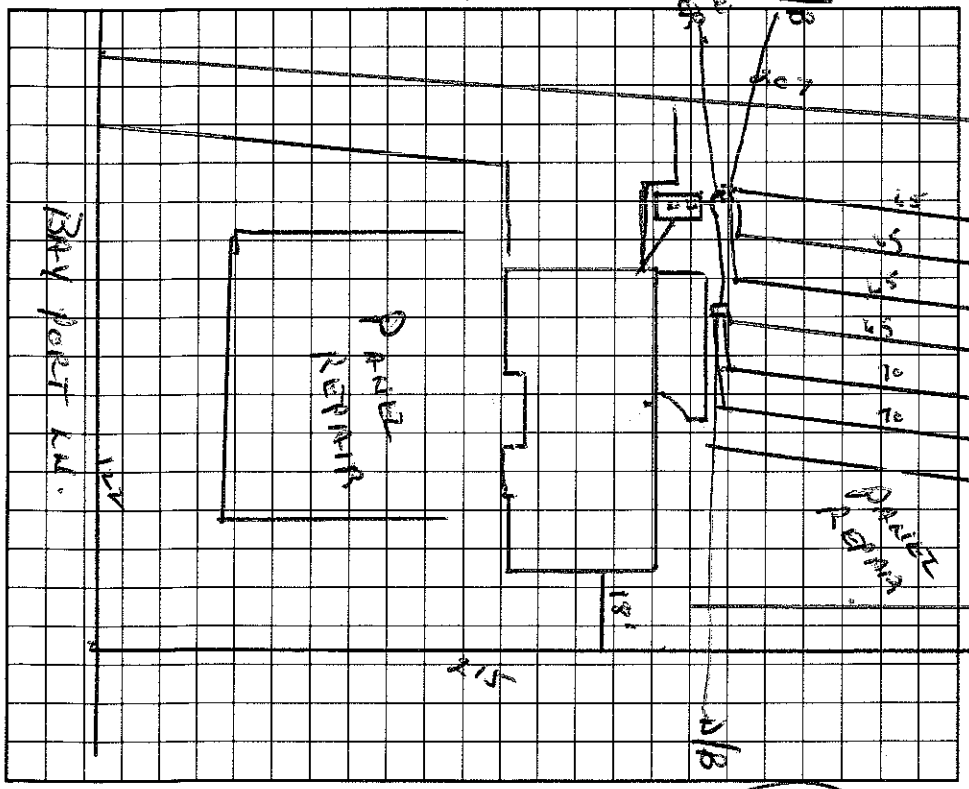

AS BUILT SKETCH

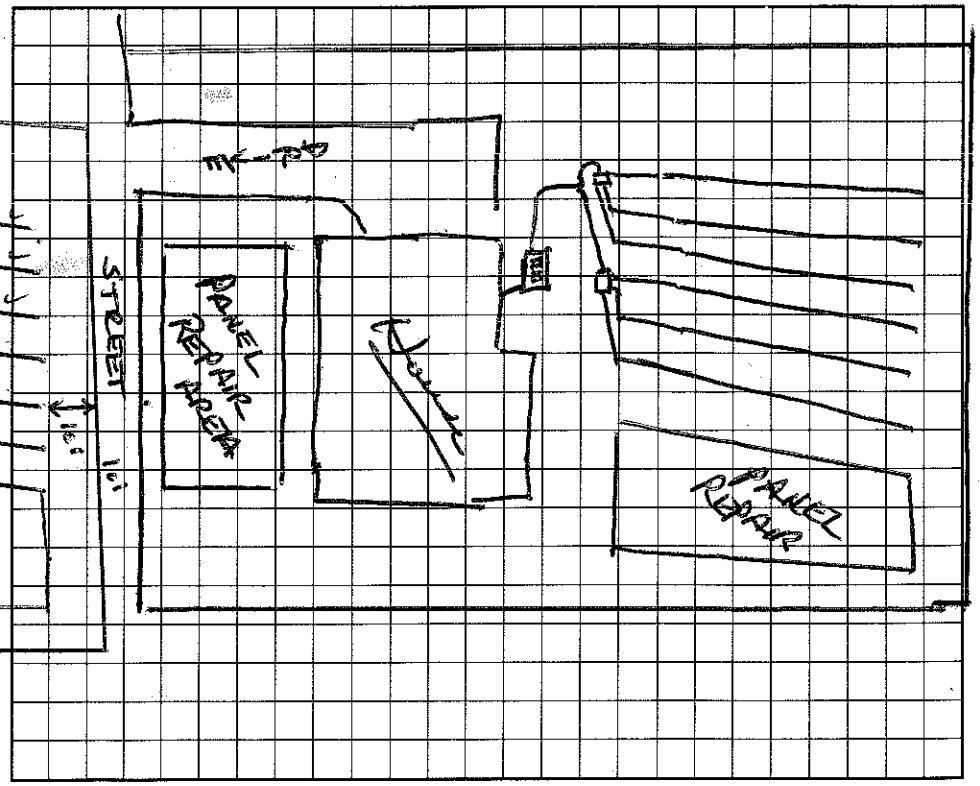

I understand that this permit can be suspended or revoked if any false information is supplied toward securing the permit/any unauthorized changes are made to the site/any unauthorized changes are made in the installation of the system.

Signed: Tammy C. Franklin, CPSS Agent

Improvement Permit by: Authorization to Construct Wesley Sparks RS date 12/27/95

Existing System Inspection by: Authorization to Construct Wesley Sparks RS date 12/22/95

Installed by: R MacLeod

Certificate of Completion by: _____ date _____

Operation Permit by: Wesley Sparks RS. date 6/25/96

HEALTH DEPT. COPY: WHITE INSPECTION COPY (FINAL): GREEN OWNER COPY (FINAL): YELLOW INSPECTION COPY (INITIAL): PINK OWNER COPY (INITIAL): GOLD