IREDELL COUNTY HEALTH DEPARTMENT

STATESVILLE 704-878-5305 MOORESVILLE 704-664-5281

IMPROVEMENT PERMIT / ~~CERTIFICATE OF COMPLETION~~ / OPERATION PERMIT / EXISTING SYSTEM INSPECTION

Application to Construct

PROPERTY DESCRIPTION NO. 23164 DATE 3/15/96 TAX MAP NO. 4625-69-0985 Watershed: X Yes ☐ No

OWNER OR CONTRACTOR John Wieland Homes PHONE: Business 522-9200 Home

ADDRESS 8325 A Arrowridge Blvd. Charlotte, NC 28273

LOCATION R corner of Lake Mist and Jonquil Ct.

SUBDIVISION The Harbour BLOCK / SECTION 1 LOT 13 LOT AREA 21780 SITE CLASS. PS DESIGN FLOW 360 L.T.A.R. .35

Septic Tank: 1000 Gallons; STB 794 Date 5/14/96

Pump Tank: ____ Gallons; PT ____ Date ____

Pump Make: ____ Model ____ Serial No. ____

Nitrification Field: No Fields 1 Square Feet 1028 Linear Feet 200

No Lines 4 Trench Width 36" Max Trench Bottom Depth 36" Gravel Depth 6" STONE

X New System ☐ Repair System Type: I II III IV V

System Description: Gravity PPBS 16" Stone

Repair System Description: ____

Maintenance Agreement Required: ☐ Yes X No

X House/Mod. Home No. Bedrooms 3

☐ Mobile Home No. Bathrooms 2.5

☐ Business No. Employees ____

☐ Other ____


☐ Slab X Crawl Space ☐ Basement w/plumbing ☐ Basement wo/plumbing

Water Supply: ☐ Individual X Community ☐ Public

Comments: * 6" Sand backfill required around panels

Comments: Installed as shown on Auth Const.

INITIAL SITE SKETCH

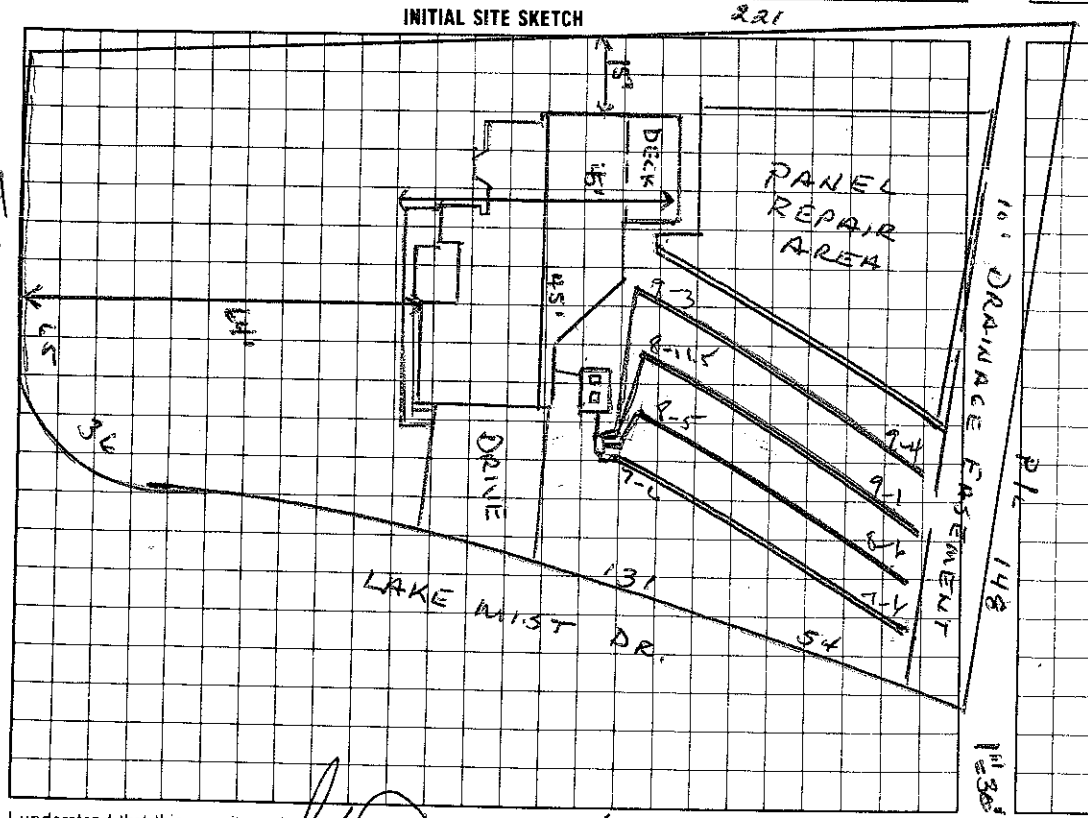

AS BUILT SKETCH

I understand that this permit can be suspended or revoked if any false information is supplied toward securing the permit/any unauthorized changes are made to the site/any unauthorized changes are made in the installation of the system.

Authorization to Construct valid 5 years.

Signed: X

Improvement Permit by: Wesley Sparks RS date 3/18/96

Existing System Inspection by: Trent Wesley Sparks RS date 3/18/96

Installed by: Macleod

Certificate of Completion by: ____ date ____

Operation Permit by: Wesley Sparks RS. date 10/25/96

HEALTH DEPT. COPY: WHITE INSPECTION COPY (FINAL): GREEN OWNER COPY (FINAL): YELLOW INSPECTION COPY (INITIAL): PINK OWNER COPY (INITIAL): GOLD