IREDELL COUNTY HEALTH DEPARTMENT

STATESVILLE 704-878-5305 MOORESVILLE 704-664-5281

IMPROVEMENT PERMIT / CERTIFICATE OF COMPLETION / OPERATION PERMIT / EXISTING SYSTEM INSPECTION

PROPERTY DESCRIPTION NO. 21629 DATE 7/26/95 TAX MAP NO. 2E 12 A 12 Watershed: [X] Yes [ ] No

OWNER OR CONTRACTOR John Wieland Homes PHONE: Business 522-9200 ~~Home~~ 4625-69-1970

ADDRESS 8325-D Crownridge Blvd. Charlotte NC.

LOCATION Brawley Sch. TR Harbour 1st (L) Lakehurst, (L) Jonquil 2nd lot on (R)

SUBDIVISION Harbour BLOCK / SECTION 1 LOT 12 LOT AREA SITE CLASS. PS DESIGN FLOW 480 L.T.A.R. .3

Septic Tank: 1000 Gallons; STB 794 Date 9/27/95

Pump Tank: Gallons; PT Date

Pump Make: Model Serial No.

Nitrification Field: No Fields 1 Square Feet 1600 Linear Feet ~~400~~ (533)

No Lines 5 Trench Width 36" Max Trench Bottom Depth 36 Gravel Depth N/A

[X] New System [ ] Repair System Type: I, II, (III) IV, V, VI

System Description: GRAV- INFILTRATOR

Repair System Description: PRES PANEL

Maintenance Agreement Required: [ ] Yes [ ] No

[X] House/Mod. Home No. Bedrooms 4

[ ] Mobile Home No. Bathrooms 2.5

[ ] Business No. Employees

[ ] Other


[ ] Slab [X] Crawl Space [ ] Basement w/plumbing [ ] Basement wo/plumbing

Water Supply: [ ] Individual [X] Community [ ] Public

Comments: + 25% reduction for infiltrator
Contours important

Comments:

INITIAL SITE SKETCH

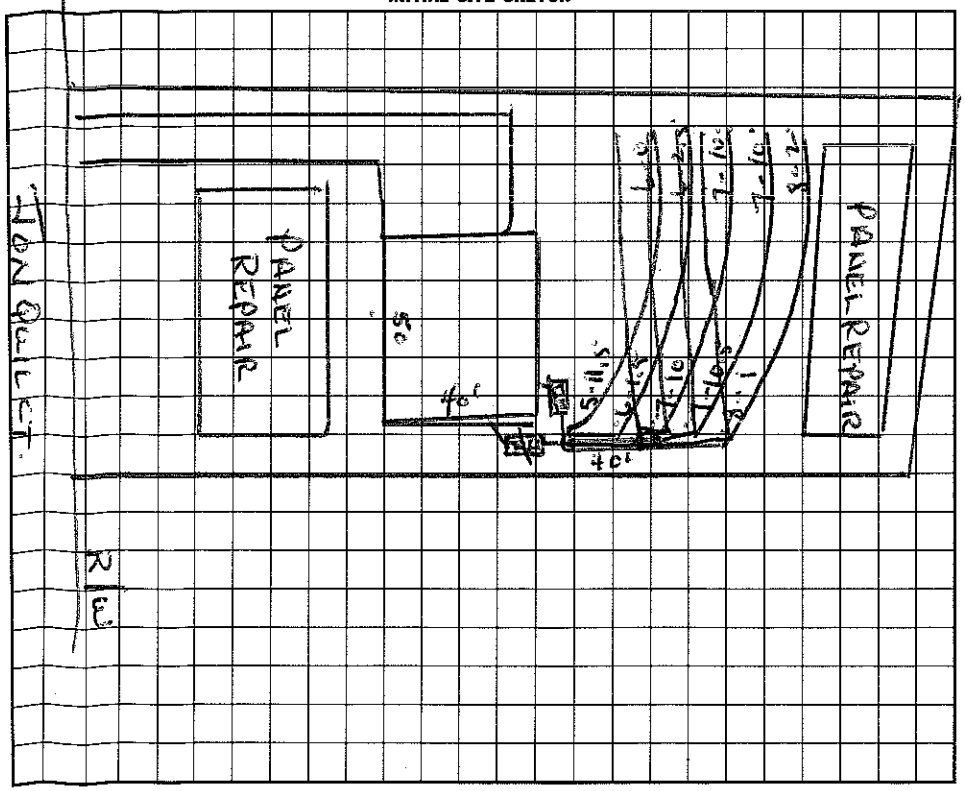

AS BUILT SKETCH

I understand that this permit can be suspended or revoked if any false information is supplied toward securing the permit/any unauthorized changes are made to the site/any unauthorized changes are made in the installation of the system. Improvement Permit is valid for 60 months from date of issuance.

Signed:

Improvement Permit by: Wesley Sparks RS. date 7/26/95

Existing System Inspection by: date

Installed by: MacLeod Const Co.

Certificate of Completion by: Wesley Sparks RS. date 1/5/96

Operation Permit by: Wesley Sparks RS. date 1/5/96

HEALTH DEPT. COPY: WHITE INSPECTION COPY (FINAL): GREEN OWNER COPY (FINAL): YELLOW INSPECTION COPY (INITIAL): PINK OWNER COPY (INITIAL): GOLD