IREDELL COUNTY HEALTH DEPARTMENT

Authorization to Construct

370-6114 - Debra Dobbins

STATESVILLE 704-878-5305 MOORESVILLE 704-664-5281

IMPROVEMENT PERMIT / ~~CERTIFICATE OF COMPLETION~~ / OPERATION PERMIT / EXISTING SYSTEM INSPECTION

PROPERTY DESCRIPTION NO. 23165 DATE 3/14/96 TAX MAP NO. 2F 12 A 17 4625692549 Watershed: X Yes ☐ No

OWNER OR CONTRACTOR John Wieland Homes PHONE: Business 522-9200 Home

ADDRESS 8325 D Arrowridge Blvd. Charlotte, NC. 28723

LOCATION Brawley Sch TR Bay Harbour TL Lake Mist TL Bay Portion, 4th lot on (L)

SUBDIVISION The Harbour BLOCK / SECTION 1 LOT 17 LOT AREA 21780 SITE CLASS PS DESIGN FLOW 360 L.T.A.R. .3

Septic Tank: 1000 Gallons; STB 794 Date 9/26/96
Pump Tank: 1000 Gallons; PT R7 Date 9/31/96
Pump Make: LIBERTY Model Serial No.
Nitrification Field: No Fields 1 Square Feet 1200 Linear Feet ~~300~~
No Lines 3 Trench Width 36" Max Trench Bottom Depth 36" Gravel Depth 6" SAND

X New System ☐ Repair System Type: I, II, III, IV, V, VI
System Description: X Chambered Plastic
Repair System Description: PPBS 16"
Maintenance Agreement Required: ☐ Yes X No

X House/Mod. Home No. Bedrooms 3
☐ Mobile Home No. Bathrooms 2.5
☐ Business No. Employees
☐ Other


☐ Slab X Crawl Space ☐ Basement w/plumbing ☐ Basement wo/plumbing

Water Supply:
☐ Individual
X Community
☐ Public


Comments: Pressure Manifold to Chambered Plastic Follow contours - Sand backfill to top of louvers on chambers.

Comments: 11/1/96 Pressure check - electrical check still pending

INITIAL SITE SKETCH

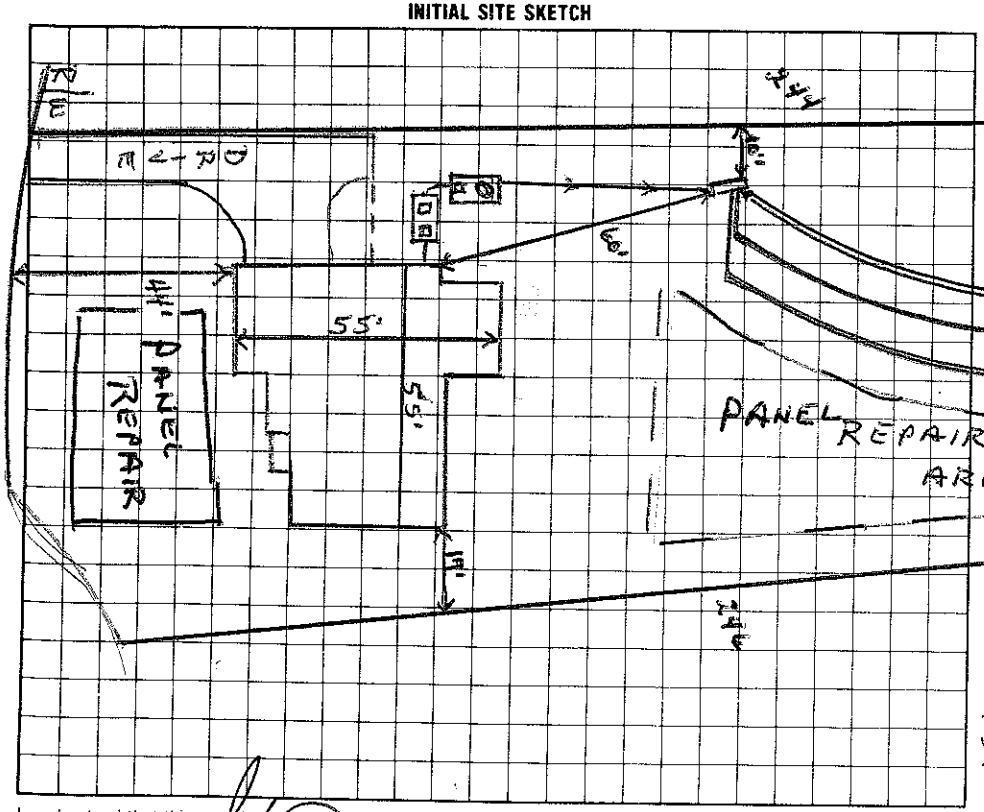

AS BUILT SKETCH

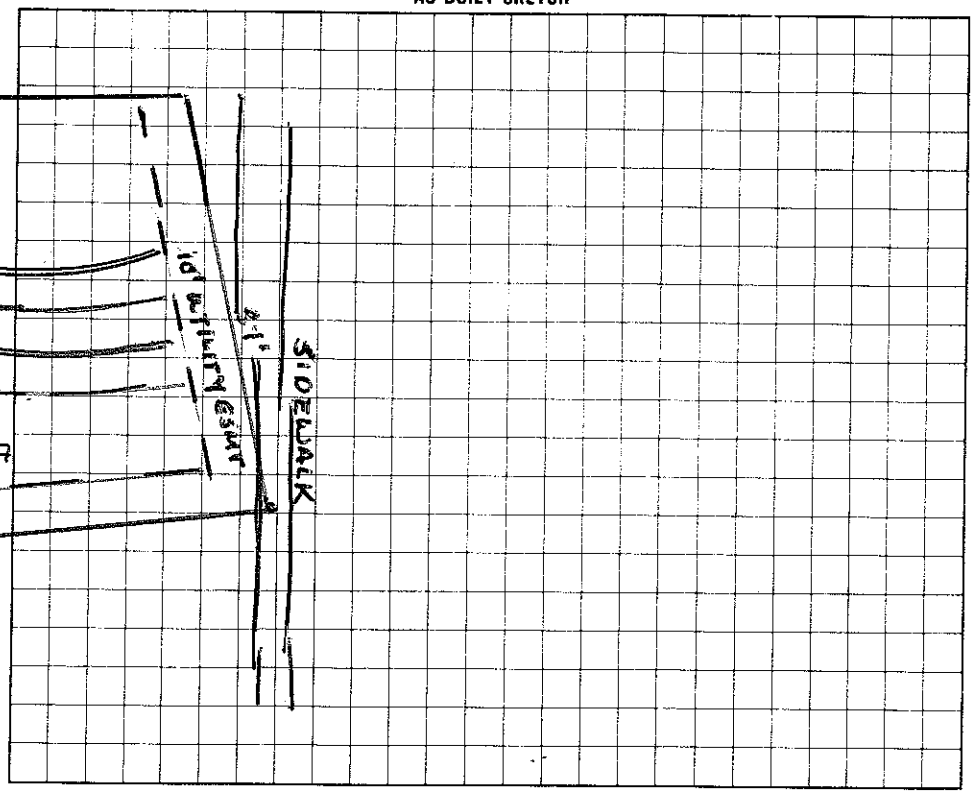

I understand that this permit can be suspended or revoked if any false information is supplied toward securing the permit/any unauthorized changes are made to the site/any unauthorized changes are made in the installation of the system.

Authorization to Construct valid for 5 years.

Signed: X

Improvement Permit by: Wesley Sparks RS. date 3/14/96

~~Existing System Inspection~~ Authorization to Construct by: Wesley Sparks RS. date 3/14/96

Installed by: MacLeod Const. Co.

Certificate of Completion by: date

Operation Permit by: Wesley Sparks RS. date 11/21/96

HEALTH DEPT. COPY: WHITE INSPECTION COPY (FINAL): GREEN OWNER COPY (FINAL): YELLOW INSPECTION COPY (INITIAL): PINK OWNER COPY (INITIAL): GOLD