IREDELL COUNTY HEALTH DEPARTMENT

Authorization to Construct

STATESVILLE 704-878-5305 | MOORESVILLE 704-664-5281

IMPROVEMENT PERMIT / ~~CERTIFICATE OF COMPLETION~~ / OPERATION PERMIT / EXISTING SYSTEM INSPECTION

PROPERTY DESCRIPTION NO. 23165 DATE 3/14/96 TAX MAP NO. 2F 12A 17 4625692549 Watershed: X Yes ☐ No

OWNER OR CONTRACTOR John Wieland Homes PHONE: Business 522-9200 Home

ADDRESS 8325-D Brownridge Blvd. Charlotte, NC. 28723

LOCATION Brawley Sch TR Bay Harbour TL Lake Mist TL Bay Portion, 4th lot on (L)

SUBDIVISION The Harbour BLOCK / SECTION 1 LOT 17 LOT AREA 21780 SITE CLASS PS DESIGN FLOW 360 L.T.A.R. .3

Septic Tank: 1000 Gallons; STB 794 Date 9/20/96

Pump Tank: 1000 Gallons; PT 87 Date 9/31/96

Pump Make: LIBERTY Model Serial No.

Nitrification Field: No Fields 1 Square Feet 1200 Linear Feet 300

No Lines 3 Trench Width 36" Max Trench Bottom Depth 36" Gravel Depth 6" STONE

X New System ☐ Repair System Type: I. II. III. IV. V. VI

System Description: X Chambered Plastic

Repair System Description: PPBS 16"

Maintenance Agreement Required: ☐ Yes X No

X House/Mod. Home ☐ Mobile Home ☐ Business ☐ Other

No. Bedrooms 3 No. Bathrooms 2.5 No. Employees


Water Supply: ☐ Individual X Community ☐ Public

X Slab X Crawl Space ☐ Basement w/plumbing ☐ Basement wo/plumbing


Comments: Pressure Manifold to Chambered Plastic Follow contours - Sand backfill to top of louvers on chambers.

Comments: 11/1/96 Pressure check - electrical check still pending

INITIAL SITE SKETCH

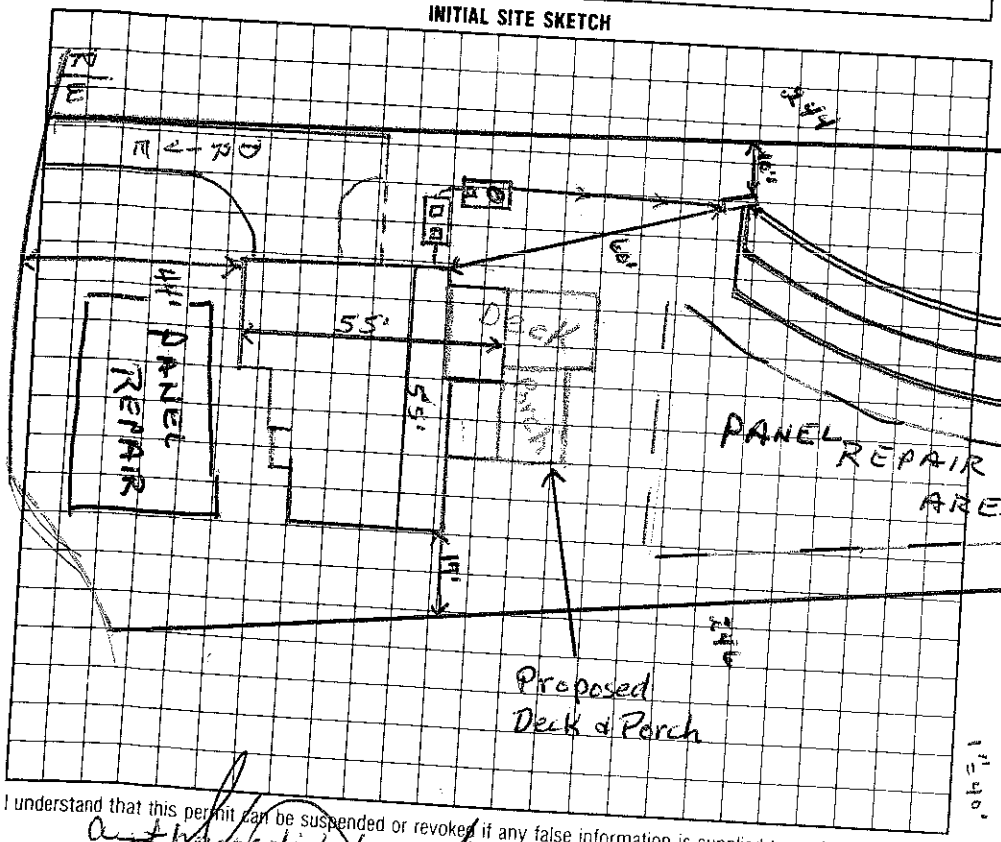

AS BUILT SKETCH

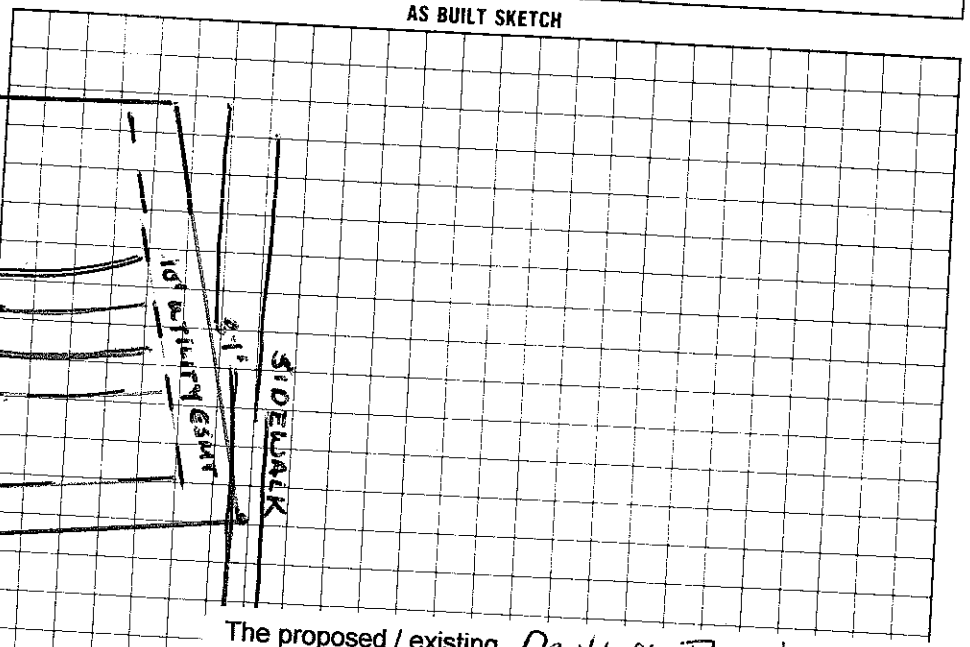

The proposed / existing Deck & Porch addition does not appear to impact the existing septic system.

**NOTE: Shall be min. 5' from septic tanks & field

Andrea Mussell R.S.

Date: 2-28-13

ICHD-Environmental Health Division

I understand that this permit can be suspended or revoked if any false information is supplied toward securing the permit/any unauthorized changes are made to the site/any unauthorized changes are made in the installation of the system

Signed: X Authorization to Construct valid for 5 years.

Improvement Permit by: Wesley Sparks R.S. date 3/14/96

~~Existing System Inspection~~ by: Construct Wesley Sparks R.S. date 3/14/96

Installed by: MacLeod Const. Co.

Certificate of Completion by: date

Operation Permit by: Wesley Sparks R.S. date 11/21/96

HEALTH DEPT. COPY: WHITE | INSPECTION COPY (FINAL): GREEN | OWNER COPY (FINAL): YELLOW | INSPECTION COPY (INITIAL): PINK | OWNER COPY (INITIAL): GOLD