IREDELL COUNTY HEALTH DEPARTMENT

STATESVILLE 704-878-5305 MOORESVILLE 704-664-5284

IMPROVEMENT PERMIT / CERTIFICATE OF COMPLETION / OPERATION PERMIT / EXISTING SYSTEM INSPECTION

PROPERTY DESCRIPTION NO. 21630 DATE 7/26/95 TAX MAP NO. 2F-12-A-11 Watershed: [X] Yes [ ] No

OWNER OR CONTRACTOR John Wieland Homes PHONE: Business 522-9200 ~~Home~~ 4625-69-2875

ADDRESS 8305 Jo Brunswick Blvd. Charlotte, NC.

LOCATION Brawley TR HARBOUR TR Lake Mist TL Jonquil Ct. 3rd on (R)

SUBDIVISION HARBOUR BLOCK / SECTION 1 LOT 11 LOT AREA 1 20/ac FT2 SITE CLASS. P5 DESIGN FLOW 480 L.T.A.R. .3

Septic Tank: 1000 Gallons; STB 794 Date 12/12/95

Pump Tank: _____ Gallons; PT _____ Date _____

Pump Make: _____ Model _____ Serial No. _____

Nitrification Field: No Fields 5 Square Feet 1600 Linear Feet ~~460~~ (533)

No Lines _____ Trench Width _____ Max Trench Bottom Depth _____ Gravel Depth _____

[X] New System [ ] Repair System Type: I, II, (III), IV, V, VI

System Description: Low - Pressure Infiltrator

Repair System Description: _____

Maintenance Agreement Required: [ ] Yes [X] No

[X] House/Mod. Home No. Bedrooms 4

[ ] Mobile Home No. Bathrooms 2.5

[ ] Business No. Employees _____

[ ] Other _____


[ ] Slab [X] Crawl Space [ ] Basement w/plumbing [ ] Basement wo/plumbing

Water Supply: [ ] Individual [X] Community [ ] Public


Comments: + 25% reduction for Infiltrator

Comments:

INITIAL SITE SKETCH

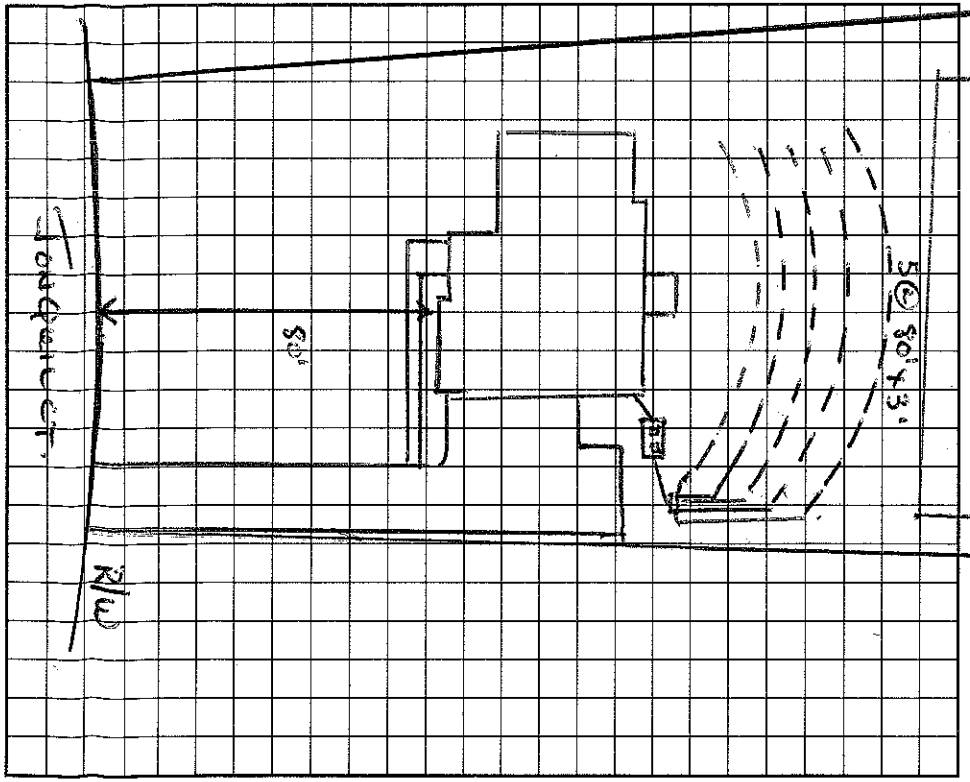

AS BUILT SKETCH

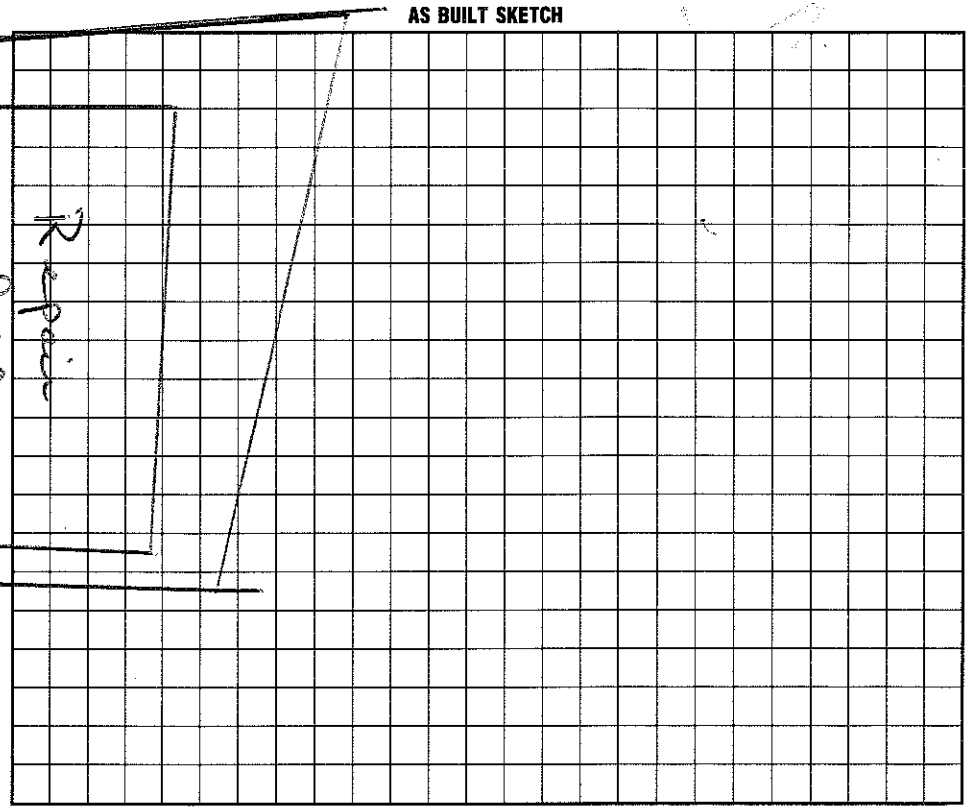

I understand that this permit can be suspended or revoked if any false information is supplied toward securing the permit/any unauthorized changes are made to the site/any unauthorized changes are made in the installation of the system. Improvement Permit is ~~valid~~ for 60 months from date of issuance.

Signed: _____

Improvement Permit by: Wesley Sparks RS. date 7/26/95

Existing System Inspection by: _____ date _____

Installed by: RL Macleod Co.

Certificate of Completion by: Wesley Sparks RS. date 2/26/96

Operation Permit by: Wesley Sparks RS. date 2/26/96

HEALTH DEPT. COPY: WHITE INSPECTION COPY (FINAL): GREEN OWNER COPY (FINAL): YELLOW INSPECTION COPY (INITIAL): PINK OWNER COPY (INITIAL): GOLD