IREDELL COUNTY HEALTH DEPARTMENT

STATESVILLE 704-878-5305 MOORESVILLE 704-664-5281

5/29/97 2 pm

IMPROVEMENT PERMIT / CERTIFICATE OF COMPLETION / OPERATION PERMIT / EXISTING SYSTEM INSPECTION

PROPERTY DESCRIPTION NO. 21908 DATE 4/28/95 TAX MAP NO. 2F 12 A 10 Watershed: [X] Yes [ ] No

OWNER OR CONTRACTOR John Wieland Homes PHONE: Business 522-9200 ~~Home~~ 1625-69-3779

ADDRESS 8325 D Arrowridge Blvd. Char. NC. 28273

LOCATION Jonquil Ct, Brevard TR Bay Harbour, TL on Lake Mist TL on Jonquil Ct., lot on (R)

SUBDIVISION Harbour BLOCK / SECTION 1 LOT 10 LOT AREA .83 ac SITE CLASS. PS DESIGN FLOW 480 L.T.A.R. .3

Septic Tank: 1200 Gallons; STB 794 Date 10/10/95
Pump Tank: _____ Gallons; PT _____ Date _____
Pump Make: _____ Model _____ Serial No. _____
Nitrification Field: No Fields 1 Square Feet 1600 Linear Feet 400 *
No Lines 4 Trench Width 36" Max Trench Bottom Depth 32" Gravel Depth N/A

[X] New System [ ] Repair System Type: I, II, [III], IV, V, VI
System Description: Drop Box - chamber trench
Repair System Description: Same
Maintenance Agreement Required: [X] Yes [ ] No


[X] House/Mod. Home No. Bedrooms 4
[ ] Mobile Home No. Bathrooms 2.5
[ ] Business No. Employees ____
[ ] Other _____
[ ] Slab [X] Crawl Space [ ] Basement w/plumbing [ ] Basement wo/plumbing

Water Supply:
[ ] Individual
[X] Community
[ ] Public


Comments: * Trinity chamber trench

Comments:

INITIAL SITE SKETCH

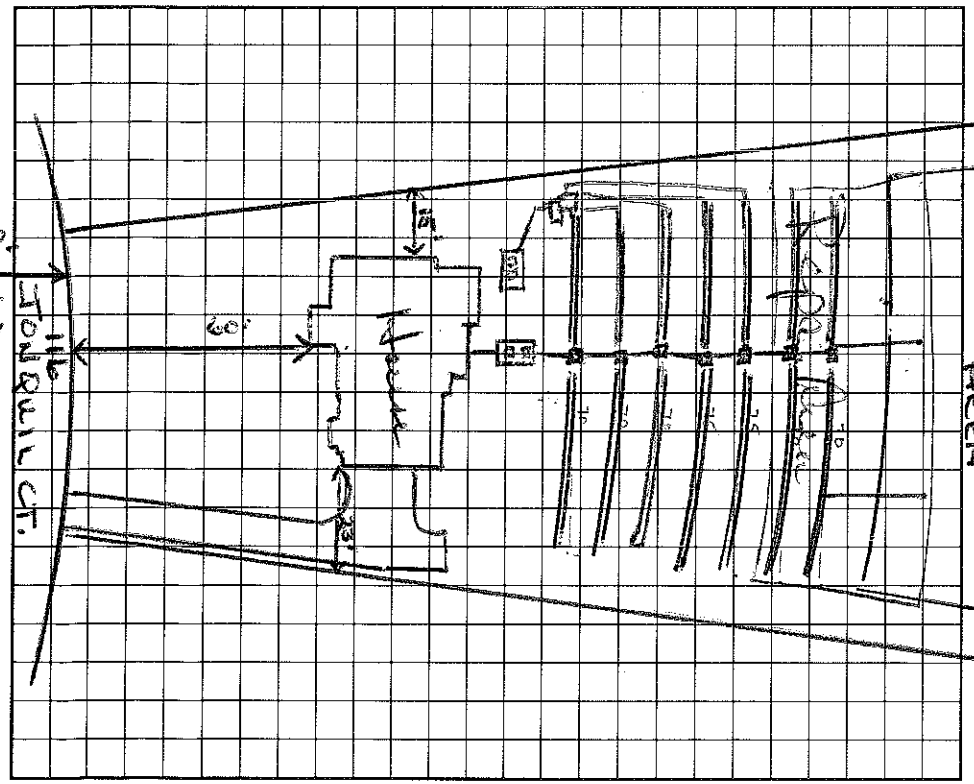

AS BUILT SKETCH

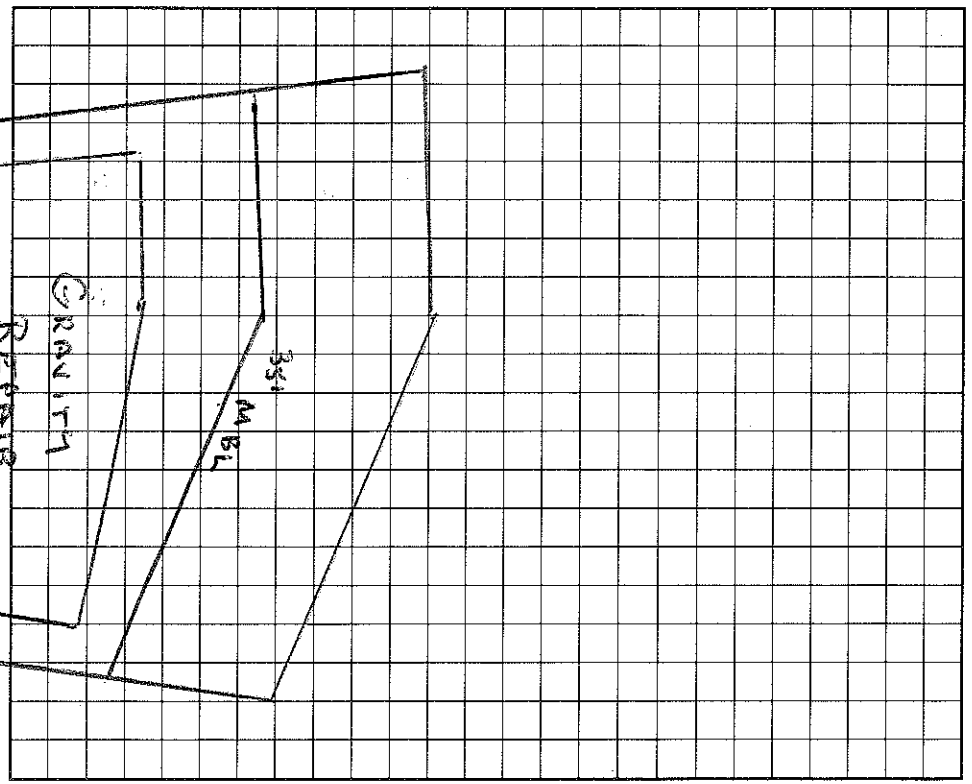

I understand that this permit can be suspended or revoked if any false information is supplied toward securing the permit/any unauthorized changes are made to the site/any unauthorized changes are made in the installation of the system.

Signed: _____

Improvement Permit by: Wesley Sparks R.S. date 8/28/95

Existing System Inspection by: _____ date _____

Installed by: R L Macleod

Certificate of Completion by: Wesley Sparks R.S. date 12/27/95

Operation Permit by: Wesley Sparks R.S. date 12/27/95

HEALTH DEPT. COPY: WHITE INSPECTION COPY (FINAL): GREEN OWNER COPY (FINAL): YELLOW INSPECTION COPY (INITIAL): PINK OWNER COPY (INITIAL): GOLD