IREDELL COUNTY HEALTH DEPARTMENT

Lin Herrington Construct

STATESVILLE 704-878-5305 MOORESVILLE 704-664-5281

IMPROVEMENT PERMIT / ~~CERTIFICATE OF COMPLETION~~ / OPERATION PERMIT / EXISTING SYSTEM INSPECTION

PROPERTY DESCRIPTION NO. 21724 DATE 5/2/96 TAX MAP NO. 2F 12 A 19 Watershed: [X] Yes [ ] No

OWNER OR CONTRACTOR John Wieland Homes PHONE: Business 522-9200 Home 4625 69 5415

ADDRESS 8325 Arrowridge Blvd. Char. NC. 28273

LOCATION Brawley Sch. TR Bay Harbour, TL Lake Mist, TL Bay Port Ln. cul-de-sac on (L)

SUBDIVISION The Harbour BLOCK / SECTION 1 LOT 19 LOT AREA 29,000 ft² SITE CLASS. PS DESIGN FLOW 600 L.T.A.R. .3

Septic Tank: 1500 Gallons; STB 797 Date 3/20/96
Pump Tank: 1500 Gallons; PT 141 Date 4/17/96
Pump Make: ____ Model ____ Serial No. ____
Nitrification Field: No Fields 1 Square Feet 2000 Linear Feet 560X
No Lines 7 Trench Width 36" Max Trench Bottom Depth 36" Gravel Depth N/A

[X] New System [ ] Repair System Type: I, II, (III), IV, V, VI
System Description: ch Plastic - Pressure
Repair System Description: Same
Maintenance Agreement Required: [X] Yes [ ] No


[X] House/Mod. Home No. Bedrooms 5
[ ] Mobile Home No. Bathrooms 4
[ ] Business No. Employees ____
[ ] Other ____
[ ] Slab [ ] Crawl Space [X] Basement w/plumbing [ ] Basement wo/plumbing

Water Supply: [ ] Individual [X] Community [ ] Public


Comments: X Changed to 5 bedrooms per owner's request.

Comments:

INITIAL SITE SKETCH

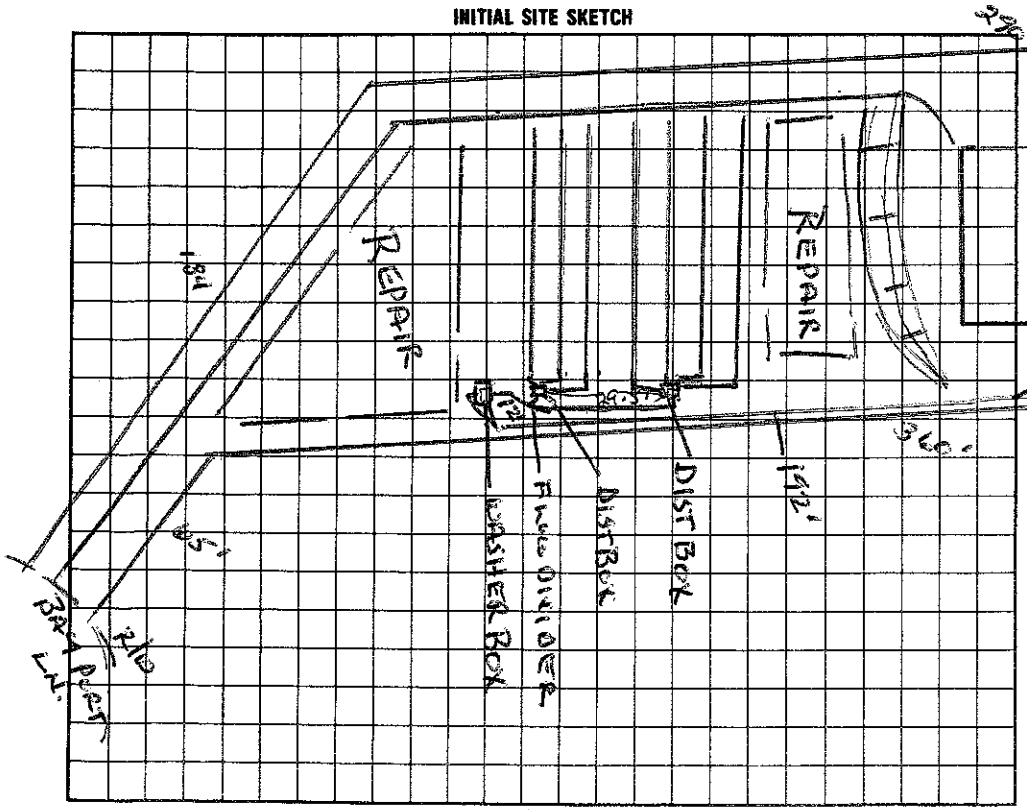

AS BUILT SKETCH

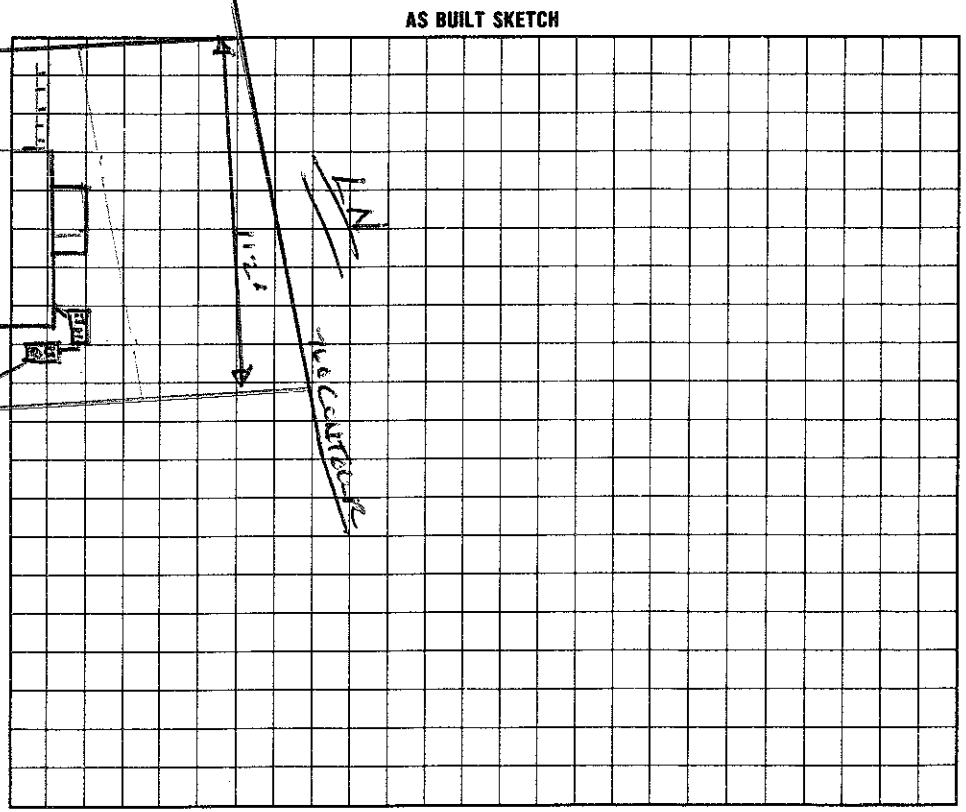

I understand that this permit can be suspended or revoked if any false information is supplied toward securing the permit/any unauthorized changes are made to the site/any unauthorized changes are made in the installation of the system.

Signed: ____

Improvement Permit by: ____ date ____

Existing System Inspection by: ____ date ____

Installed by: RL MacLeod

Certificate of Completion by: ____ date ____

Operation Permit by: C. Bob Team Effort date 5/22/96

HEALTH DEPT. COPY: WHITE INSPECTION COPY (FINAL): GREEN OWNER COPY (FINAL): YELLOW INSPECTION COPY (INITIAL): PINK OWNER COPY (INITIAL): GOLD