IREDELL COUNTY HEALTH DEPARTMENT

STATESVILLE 704-878-5305 MOORESVILLE 704-664-5281

IMPROVEMENT PERMIT / CERTIFICATE OF COMPLETION / OPERATION PERMIT / EXISTING SYSTEM INSPECTION

PROPERTY DESCRIPTION NO. 2162 8 DATE 8/14/95 TAX MAP NO. 2F 12 A 18 4625695537 Watershed: ☒ Yes ☐ No

OWNER OR CONTRACTOR John Wieland Homes PHONE: Business 522-9200 Home

ADDRESS 8325-D Dunwoody Blvd. Char. NC. 28273

LOCATION The Harbour - Brawley Sch TR. Bay Harbour, TL Harbor Mist, TL Bay Point Ln. last lot on (D) off cul-de-sac

SUBDIVISION Harbour BLOCK / SECTION 1 LOT 18 LOT AREA ~.7 AC SITE CLASS. PS DESIGN FLOW 480 L.T.A.R. .73

Septic Tank: 1000 Gallons; STB 744 Date 11/20/95
Pump Tank: 1000 Gallons; PT 27 Date 11/19/95
Pump Make: Model Serial No.
Nitrification Field: No Fields 1 Square Feet 1400 Linear Feet 266' (533)
No Lines 4 Trench Width 24" Max Trench Bottom Depth 30" Gravel Depth 6" STONE

☒ New System ☐ Repair System Type: I, II, ☒ III, IV, V, VI
System Description: Panel - Pressure Manifold
Repair System Description: None
Maintenance Agreement Required: ☒ Yes ☐ No


☒ House/Mod. Home No. Bedrooms 4
☐ Mobile Home No. Bathrooms 2.5
☐ Business No. Employees
☐ Other
☐ Slab ☐ Crawl Space ☒ Basement w/plumbing ☐ Basement wo/plumbing

Water Supply:
☐ Individual
☒ Community
☐ Public


Comments:
* Prefab Permeable Panels

Comments:
1/4/96 Drainfield and location approved
Nothing to be done today Ans-S
¾ HP LIBERTY - Model # LE7142

INITIAL SITE SKETCH

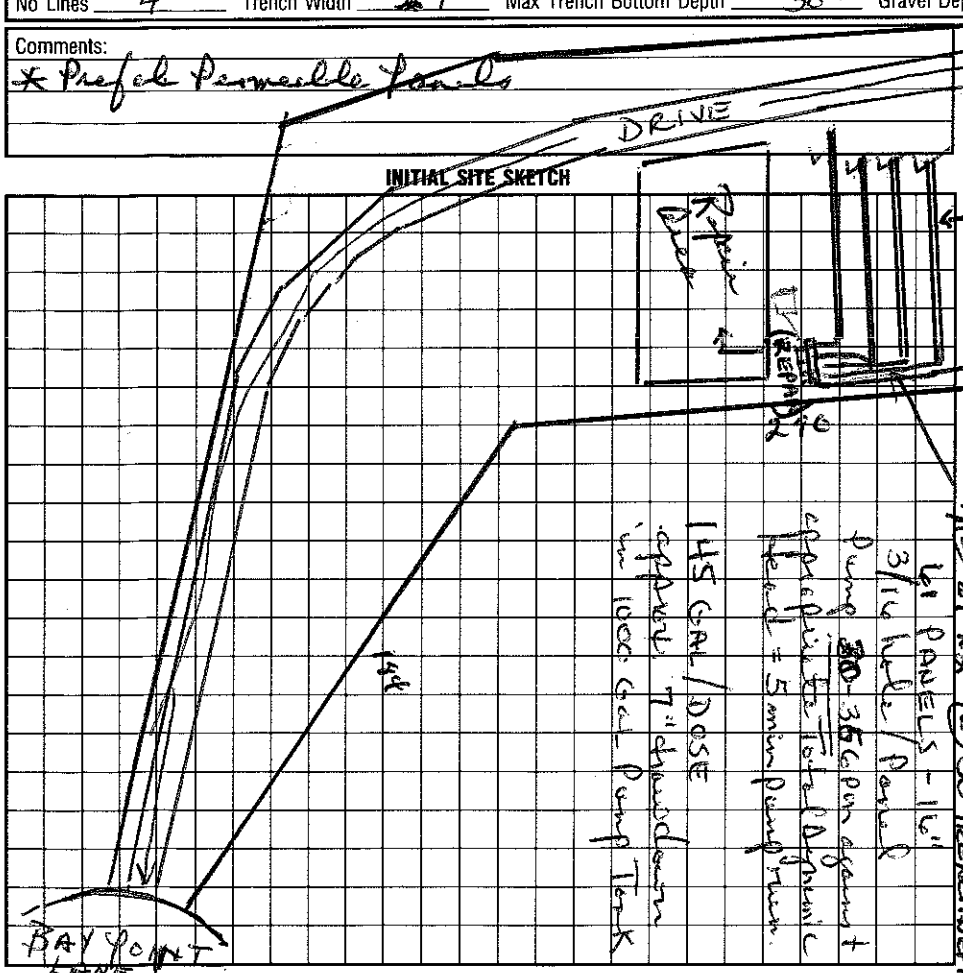

AS BUILT SKETCH

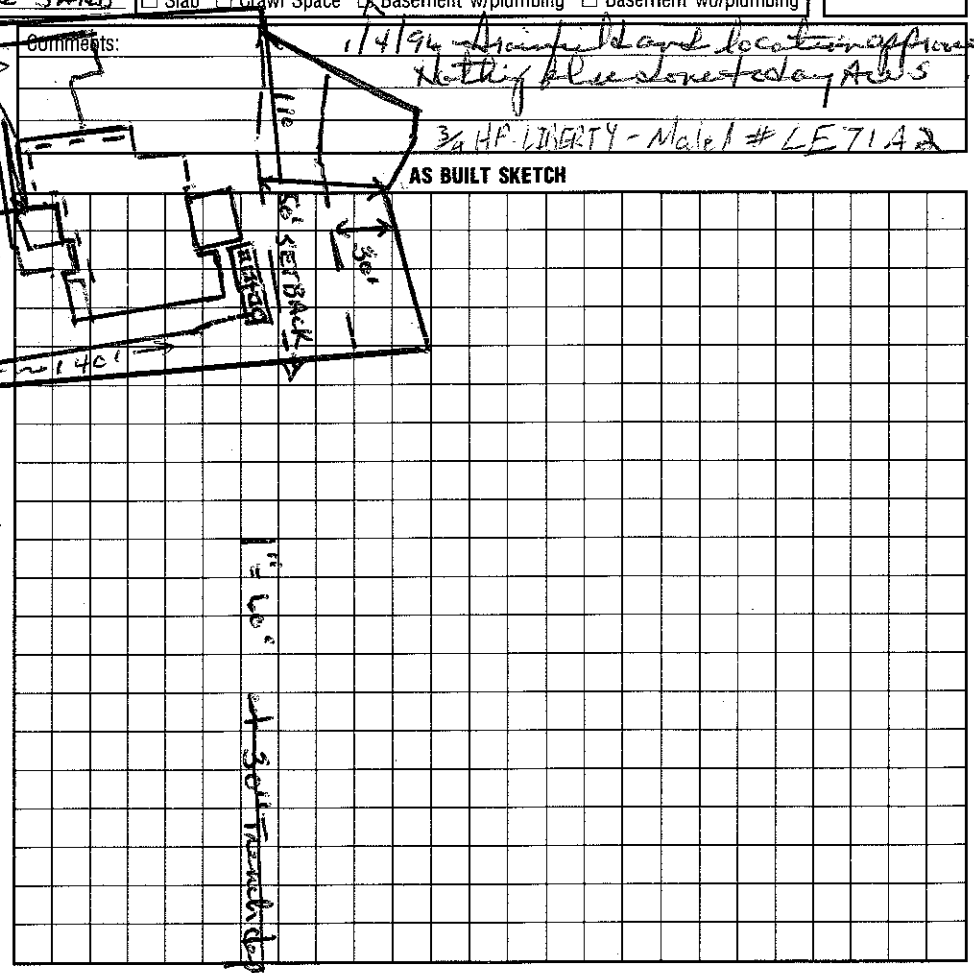

I understand that this permit can be suspended or revoked if any false information is supplied toward securing the permit/any unauthorized changes are made to the site/any unauthorized changes are made in the installation of the system.

Signed: [signature]

Improvement Permit by: Wesley Sparks RS. date 8/14/95

Existing System Inspection by: date

Installed by: RL Macleod Const Co.

Certificate of Completion by: Wesley Sparks RS. date 3/1/96

Operation Permit by: Wesley Sparks RS. date 3/1/96

HEALTH DEPT. COPY: WHITE INSPECTION COPY (FINAL): GREEN OWNER COPY (FINAL): YELLOW INSPECTION COPY (INITIAL): PINK OWNER COPY (INITIAL): GOLD