IREDELL COUNTY HEALTH DEPARTMENT

AUTHORIZATION TO CONSTRUCT 462569 5698 (2:15)

STATESVILLE 704-878-5305 MOORESVILLE 704-664-5281

IMPROVEMENT PERMIT / ~~CERTIFICATE OF COMPLETION~~ / OPERATION PERMIT / EXISTING SYSTEM INSPECTION

PROPERTY DESCRIPTION NO. 18386 DATE 12/6/96 TAX MAP NO. 26-A-3 pt of Watershed: ☑ Yes ☐ No

OWNER OR CONTRACTOR JOHN WIELAND PHONE: Business 663-6905 T. JACOBS Home

ADDRESS PO BOX 1003 CHARLOTTE NC 28201

LOCATION BRAWLEY SCHOOL RD - TR BAY HARBOUR RD - TL LAKEMIST - LEFT ON JONQUIL CT.

SUBDIVISION HARBOUR BLOCK / SECTION I LOT 9 LOT AREA 21,780 FS SITE CLASS. PS DESIGN FLOW 600 L.T.A.R. 3 GPD/FT²

Septic Tank: 1000 Gallons; STB ~~1000~~ 794 Date 10/~~15~~/96

Pump Tank: 1000 Gallons; PT 2-7 Date 10/2/96

Pump Make: LIBERTY Model LE 122A2 Serial No.

Nitrification Field: No Fields 1 Square Feet 1074 Linear Feet 358

No Lines ~~8~~ 6 Trench Width 24" Max Trench Bottom Depth 36" Gravel Depth NA

☑ New System ☐ Repair System Type: I, II, III, IV, V, VI

System Description: LPP PPBPS

Repair System Description: OFF SITE - SEE ATTACHED

Maintenance Agreement Required: ☑ Yes ☐ No

☑ House/Mod. Home ☐ Mobile Home ☐ Business ☐ Other

No. Bedrooms 5 No. Bathrooms 4 No. Employees


☐ Slab ☐ Crawl Space ☑ Basement w/plumbing ☐ Basement wo/plumbing

Water Supply: ☐ Individual ☑ Community ☐ Public


Comments: 3 11
47
55
6 11
9 ✓

Comments: LINES, TANKS CHECKED 12/11/96 - OK'd 12/13/96 RWS

INITIAL SITE SKETCH

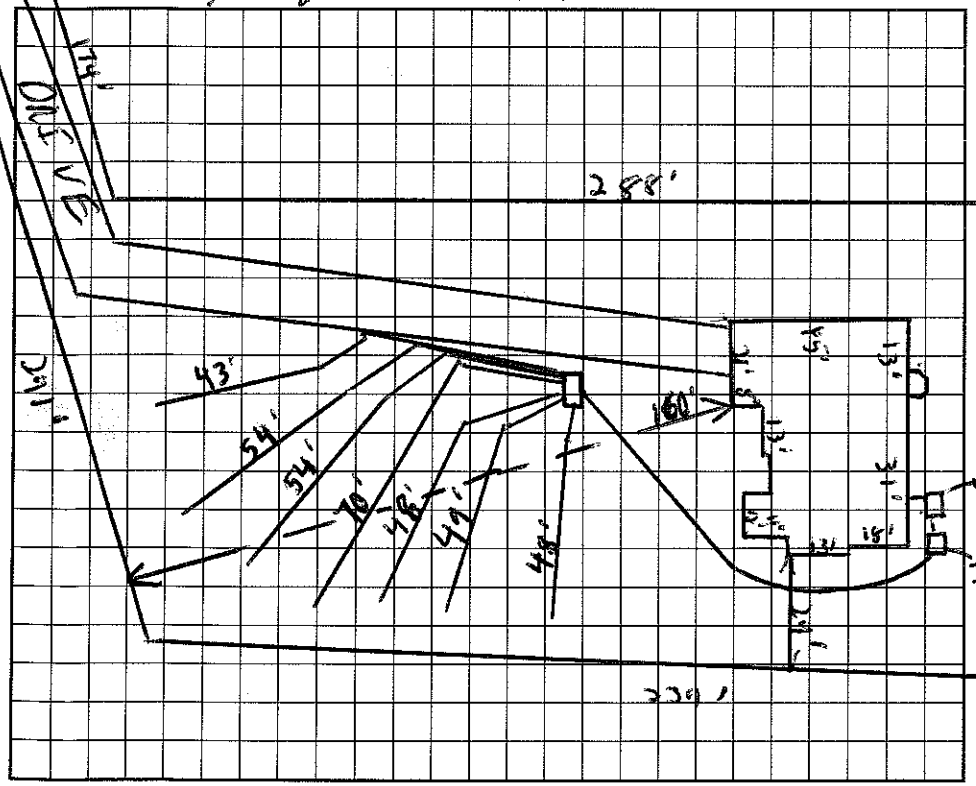

AS BUILT SKETCH

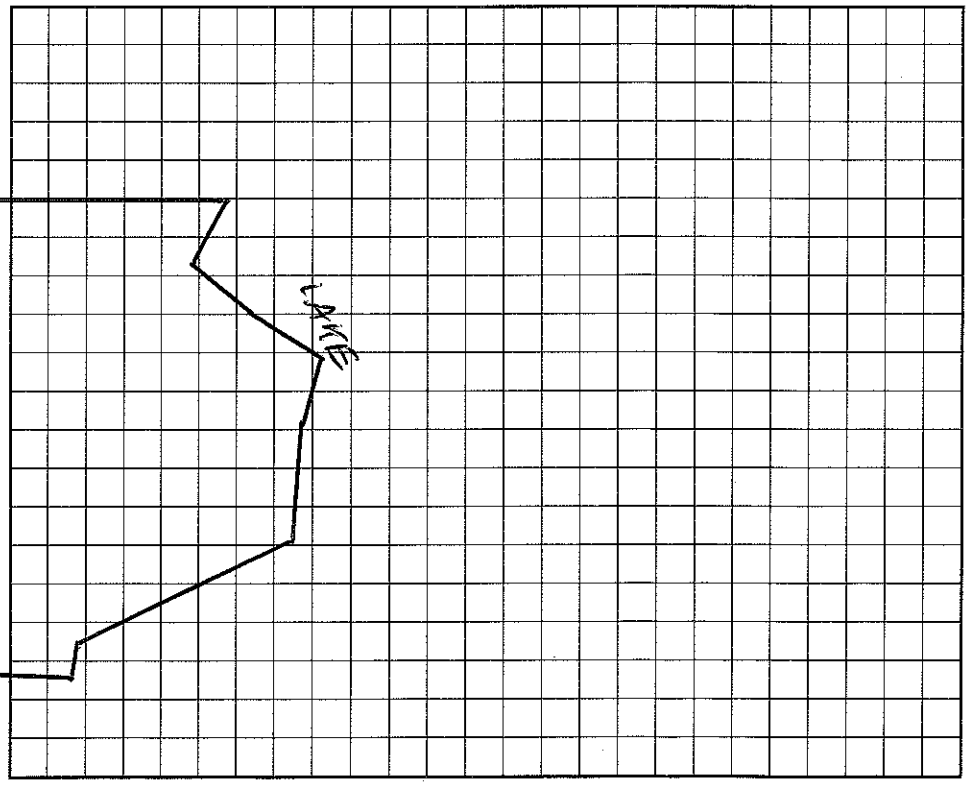

I understand that this permit can be suspended or revoked if any false information is supplied toward securing the permit/any unauthorized changes are made to the site/any unauthorized changes are made in the installation of the system.

Signed: Tonery C Jacobs (PSS(R)) 12-6-96

Improvement Permit by: ANDREA LEMON date

Existing System Inspection by: C. [illegible] date

Installed by: ~~[illegible]~~ MacLeod

Certificate of Completion by: date

Operation Permit by: C. [illegible] EHSI date 12/19/96

AUTHORIZATION TO CONSTRUCT

HEALTH DEPT. COPY: WHITE INSPECTION COPY (FINAL): GREEN OWNER COPY (FINAL): YELLOW INSPECTION COPY (INITIAL): PINK OWNER COPY (INITIAL): GOLD