4625 69 6727

IREDELL COUNTY HEALTH DEPARTMENT

AUTHORIZATION TO CONSTRUCT

STATESVILLE 704-878-5305 MOORESVILLE 704-664-5281

IMPROVEMENT PERMIT / ~~CERTIFICATE OF COMPLETION~~ / OPERATION PERMIT / EXISTING SYSTEM INSPECTION

PROPERTY DESCRIPTION NO. 18385 DATE JULY 12 1994 TAX MAP NO. PT OF 2C 3A Watershed: ☒ Yes ☐ No LN

OWNER OR CONTRACTOR ~~CRESCENT RESOURCES INC~~ WIELAND PHONE: Business Home

ADDRESS PO BOX 1004 CHARLOTTE NC 28201

LOCATION entrance is on west side of SR1180 ¼ mile south of SR1177 is Bay Harbour Rd, left onto Lake Mist Dr, left onto Jonquil Ct.

SUBDIVISION the Harbour BLOCK / SECTION 1 LOT 8 & 9A LOT AREA 21,780 SITE CLASS. P DESIGN FLOW 480 L.T.A.R. 0.3

Septic Tank: 1000 Gallons; STB 794 Date 10/30/96 ☒ New System ☐ Repair System Type: I, II, III, ⓘⓥ, V, VI

Pump Tank: 1000 Gallons; PT 27 Date 11/15/96 System Description: LPP PPBPS

Pump Make: ~~H40REMAT~~ Model 1HP Serial No. Repair System Description: OFF SITE-SEE ATTACHED

Nitrification Field: No Fields 1 Square Feet 1600SQ. Linear Feet 267 Maintenance Agreement Required: ☒ Yes ☐ No

No Lines 4 Trench Width 24" Max Trench Bottom Depth 36" Gravel Depth NA ☐ Slab ☐ Crawl Space ☒ Basement w/plumbing ☐ Basement wo/plumbing


☒ House/Mod. Home No. Bedrooms 4 ☐ Mobile Home No. Bathrooms 4 ☐ Business No. Employees ☐ Other

Water Supply: ☐ Individual ☒ Community ☐ Public


Comments: (1) check valve after quick release joint, floats on float tree. lift station design per .1952 (2) 2" sch 40 PVC distribution line, turnups & gate valves in valve boxes finished at grade, 3/16" hole per panel, 2' pressure head, follow contours with INITIAL SITE SKETCH laterals. Do not install during wet soil conditions.

Comments: Easement and S.A. see sheet attached here.

INITIAL SITE SKETCH

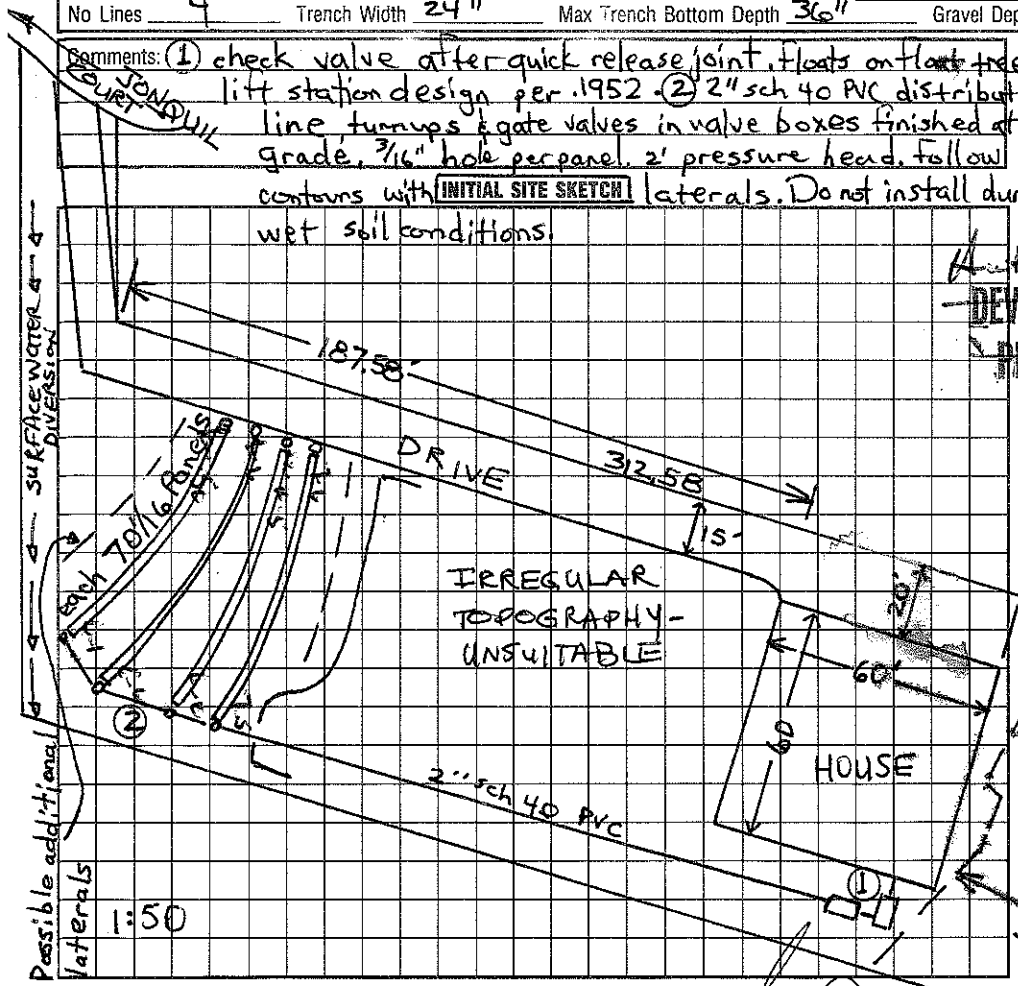

AS BUILT SKETCH

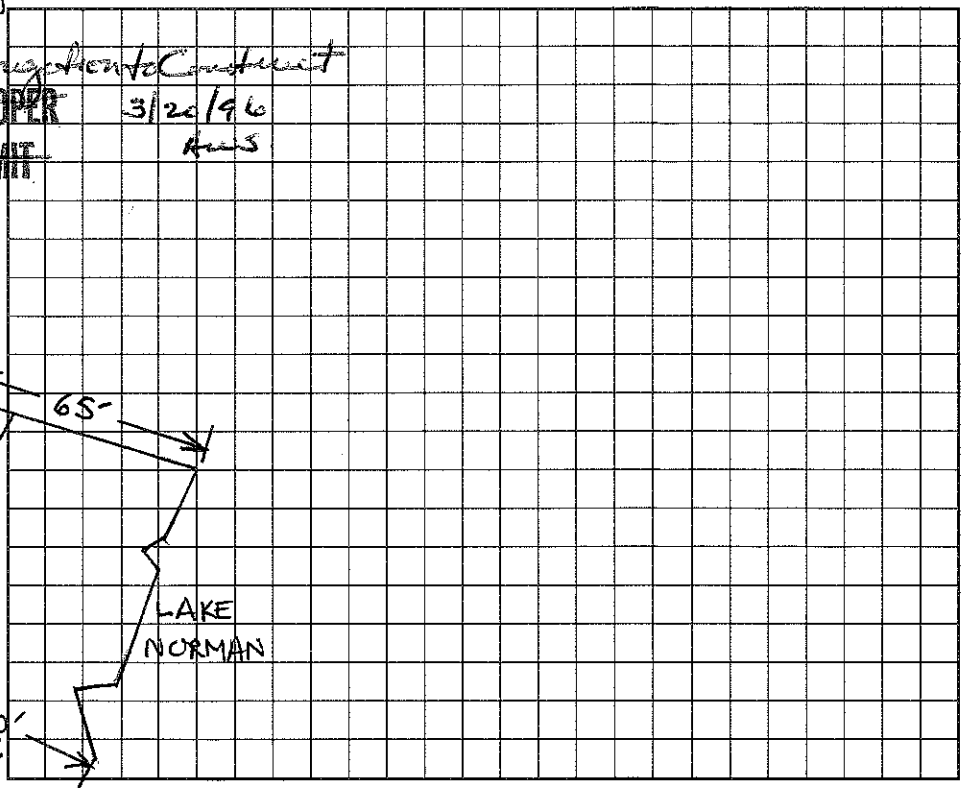

I understand that this permit can be suspended or revoked if any false information is supplied toward securing the permit/any unauthorized changes are made to the site/any unauthorized changes are made in the installation of the system. Improvement Permit is valid for 60 months from date of issuance.

Signed: Terry Hanby, CES agent for Lee Wieland

Improvement Permit by: Linda Lemon date 7/13/94

Existing System Inspection by: Authorization to Construct / Wesley Sparks date 3/20/96

Installed by: Macleod Const. Co.

Certificate of Completion by: date

Operation Permit by: Wesley Sparks RS. date 1/21/97

HEALTH DEPT. COPY: WHITE INSPECTION COPY (FINAL): GREEN OWNER COPY (FINAL): YELLOW INSPECTION COPY (INITIAL): PINK OWNER COPY (INITIAL): GOLD