IREDELL COUNTY HEALTH DEPARTMENT

STATESVILLE 704-878-5305 MOORESVILLE 704-[illegible] 130

IMPROVEMENT PERMIT / AUTHORIZATION TO CONSTRUCT / OPERATION PERMIT / EXISTING SYSTEM INSPECTION

PERMIT# 114651 PIN# 4625 71 7476.19 4625-70-2004 DATE 9/8/03

OWNER OR CONTRACTOR POINT ON NORMAN / LAKE NORMAN SIGNATURE PHONE: Business 660-1185 Home

ADDRESS 2214 BRAWLEY SCHOOL - MOORESVILLE NC 28117

LOCATION BRAWLEY SCHOOL - TL NEW HAVEN - TR SOUTH LONGFELLOW - ON LT

SUBDIVISION POINT BLOCK / SECTION 12 LOT 19 LOT AREA 44244 ft² SITE CLASS. PS DESIGN FLOW 480 GPD L.T.A.R. 360 IP

Septic Tank: 700/1500 Gallons; STB 338 Date 10/1/05

Pump Tank: 1000/1500 Gallons; PT 477 Date 4/20/05

Pump Make: Zoeller Model W50S72144 Serial No.

Nitrification Field: No Fields 1 Square Feet 1200 Linear Feet 400

No Lines 4@100' Trench Width 36" Max Trench Bottom Depth 36" Gravel Depth N/A

☑ New System ☐ Repair System Type: I, II, (III), IV, V, VI

System Description: PUMP 25% REDUCTION

Repair System Description: PUMP SAME

Maintenance Agreement Required: ☐ Yes ☑ No

☑ House/Mod. Home No. Bedrooms 4

☐ Mobile Home No. Bathrooms 4

☐ Business No. Employees

☐ Other

☐ Slab ☑ Crawl Space ☑ Basement w/plumbing ☐ Basement wo/plumbing

Water Supply: ☐ Individual ☐ Public ☑ Community

Comments:/Conditions:


Comments:/Conditions: PARTIAL

Tanks & alarm checked by GM 11/15/05


Pressure Checked 12/30/05 GM

Float & Alarm Checked by MD

INITIAL SITE SKETCH 1"=50'

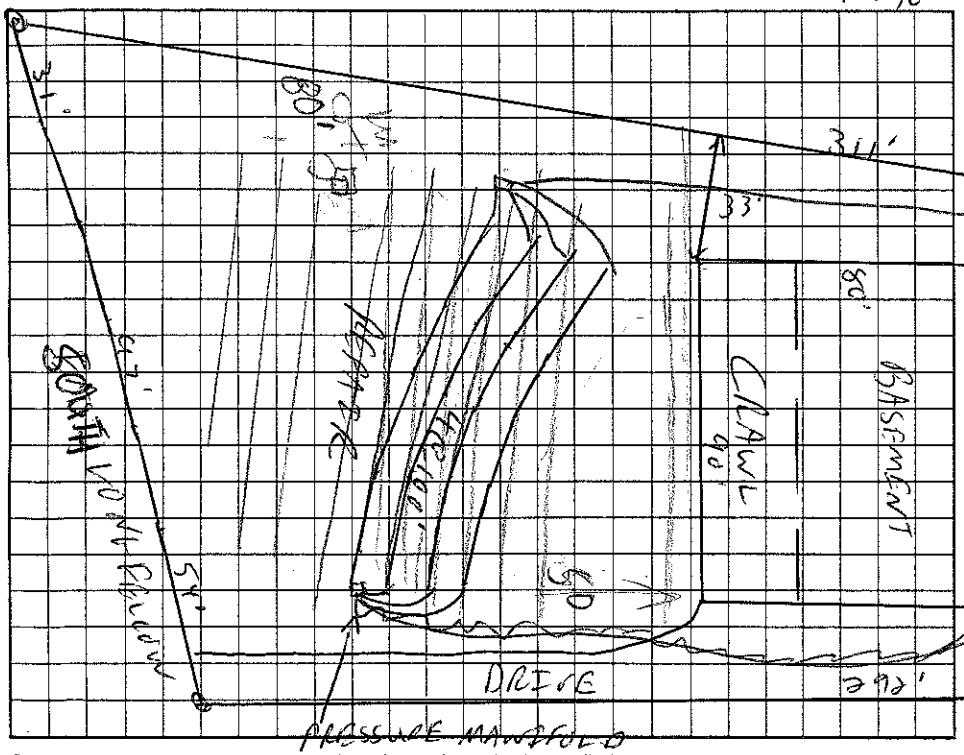

AS BUILT SKETCH

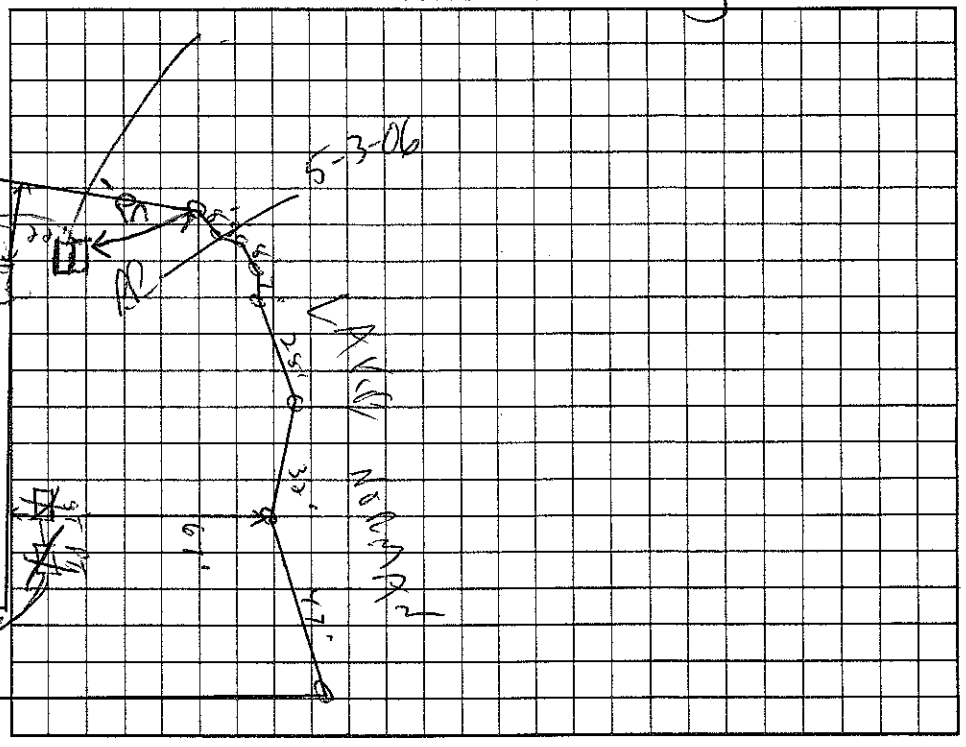

Permit can be suspended or revoked if any false information is supplied toward securing the permit/any unauthorized changes are made to the site/any unauthorized changes are made in the installation of the system. Improvement Permit with plat valid without expiration. Improvement Permit with site plan valid for sixty months. Authorization to Construct is valid for a period equal to that of Improvement Permit – not to exceed sixty months.

Signed: [signature] date 9-23-03 Installed by: Hallman

Improvement Permit by: [signature] RS date 9/8/03 Operation Permit by: Maria H. Dolan RS date 5/3/06

Authorization to Construct by: [signature] RS date 9/21/04 Existing System Inspection by: date

HEALTH DEPT. COPY: WHITE OWNER COPY (FINAL): YELLOW OWNER COPY (INITIAL): PINK