IREDELL COUNTY HEALTH DEPARTMENT

STATESVILLE 704-878-5305 MOORESVILLE 704-664-5281

IMPROVEMENT PERMIT / AUTHORIZATION TO CONSTRUCT / OPERATION PERMIT / EXISTING SYSTEM INSPECTION

PERMIT# 114662 PIN# 4625-71-7476.24 4625701891 DATE 9/16/03

OWNER OR CONTRACTOR POINT ON NORMAN / Kenneth Beales PHONE Business 660-1185 Home

ADDRESS 2214 BRAWLEY SCHOOL MOORESVILLE NC 28117

LOCATION BRAWLEY SCHOOL TL NEW HAVEN - TL NORTH LONGFELLOW - ON RT

SUBDIVISION POINT BLOCK / SECTION 12 LOT 124 LOT AREA 38,856ft² SITE CLASS RS DESIGN FLOW 480GPD L.T.A.R. .36PD/FT²

Septic Tank: 1000 Gallons; STB 338 Date 3-1-07
Pump Tank: 1000 Gallons; PT 283 Date 3-6-07
Pump Make: Myers Model ME50S-2 Serial No.
Nitrification Field: No Fields 1 Square Feet 1200 Linear Feet 400
No Lines 5@80' Trench Width 36" Max Trench Bottom Depth 36" Gravel Depth

☑ New System ☐ Repair System Type: I, II, III, IV, V, VI
System Description: PUMP 25% REDUCTION
Repair System Description: LP ~~SAME~~ 25% REDUCTION
Maintenance Agreement Required: ☐ Yes ☑ No Reduction

☑ House/Mod. Home No. Bedrooms 4
☐ Mobile Home No. Bathrooms 4
☐ Business No. Employees
☐ Other


☐ Slab ☐ Crawl Space ☑ Basement w/plumbing ☐ Basement wo/plumbing

Water Supply: ☐ Individual ☐ Public ☐ ~~Community~~


Comments:/Conditions:

Comments:/Conditions: 4/25/07 Checked tanks & 4 lines EZ Flow
Checked 5th line 4/26/07 MD

INITIAL SITE SKETCH 1"=50'

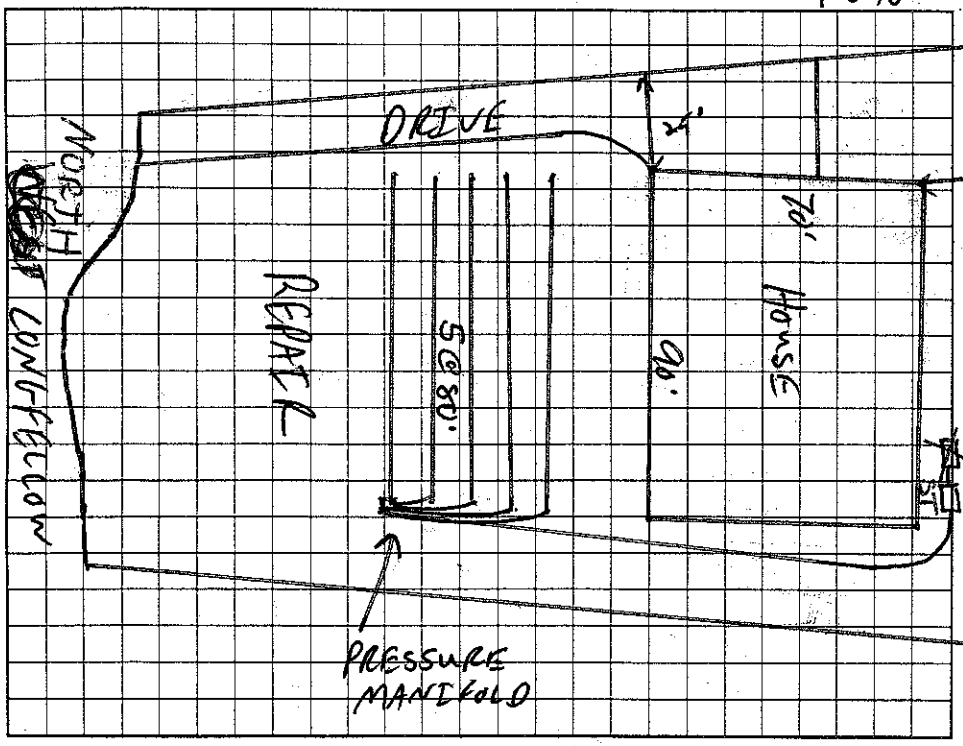

AS BUILT SKETCH

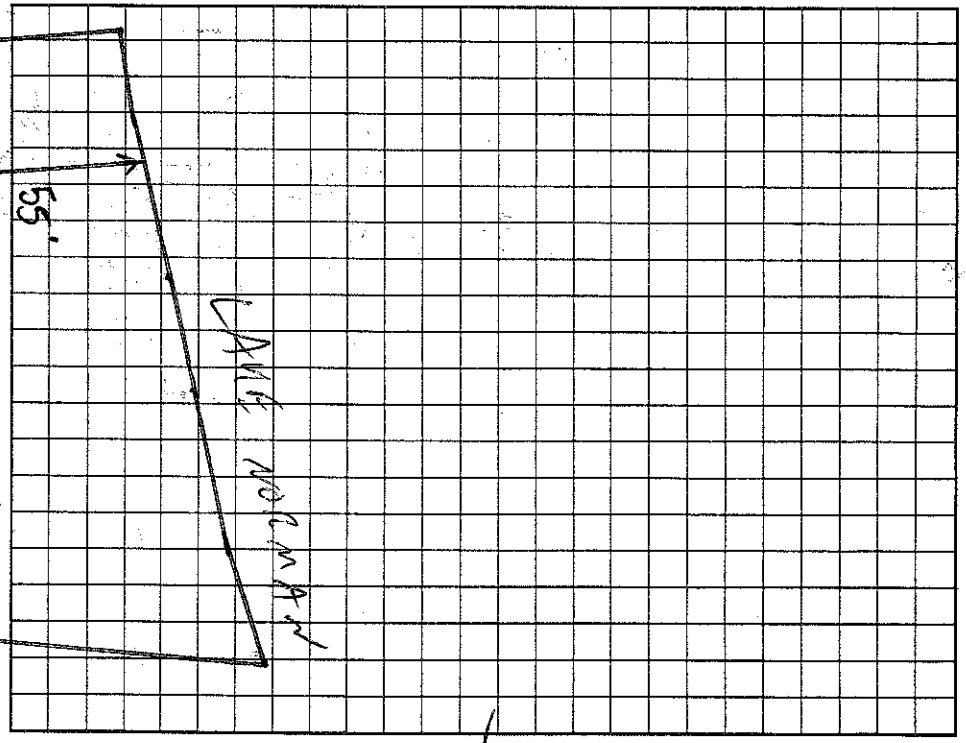

Permit can be suspended or revoked if any false information is supplied toward securing the permit/any unauthorized changes are made to the site/any unauthorized changes are made in the installation of the system. Improvement Permit with plat valid without expiration. Improvement Permit with site plan valid for sixty months. Authorization to Construct is valid for a period equal to that of Improvement Permit – not to exceed sixty months.

Signed: date 9-23-03

Improvement Permit by: RS date 9/16/03

Authorization to Construct by: RS date 1/25/06

Installed by: date

Operation Permit by: RS date 5/24/07

Existing System Inspection by: date

HEALTH DEPT. COPY: WHITE OWNER COPY (FINAL): YELLOW OWNER COPY (INITIAL): PINK