IREDELL COUNTY HEALTH DEPARTMENT

STATESVILLE 704-878-5305 — MOORESVILLE 704-664-5281

IMPROVEMENT PERMIT / AUTHORIZATION TO CONSTRUCT / OPERATION PERMIT / EXISTING SYSTEM INSPECTION

PERMIT# 114649 PIN# 4625 71 7476 .18 4625-70-2004 DATE 8/10/05

OWNER OR CONTRACTOR Augusta Hopes PHONE: Business 897-1190 Home

ADDRESS 10602-B Bailey Rd. Cornelius, NC. 28031

LOCATION 1100 TL New Haven TR South Longfellows on (L)

SUBDIVISION Point BLOCK / SECTION 12 LOT 1218 LOT AREA 44786 SITE CLASS PS DESIGN FLOW 480 L.T.A.R. .3

Septic Tank: 1500 Gallons; STB 338 Date 10-1-06
Pump Tank: 1000 Gallons; PT 27 Date 8-7-06
Pump Make: Myers Model ME50 Serial No.
Nitrification Field: No Fields 1 Square Feet 810 Linear Feet 270
No Lines 3@90' Trench Width 3' Max Trench Bottom Depth 3'

[X] New System [ ] Repair System Type: I, II, III, IV, V, VI
System Description: LP-PPBRS 16"
Repair System Description: SAME
Maintenance Agreement Required: [X] Yes [ ] No
Gravel Depth NA [ ] Slab [ ] Crawl Space [X] Basement w/plumbing [ ] Basement wo/plumbing

[X] House/Mod. Home No. Bedrooms 4
[ ] Mobile Home No. Bathrooms 4
[ ] Business No. Employees
[ ] Other


Water Supply: [ ] Individual [ ] Public [X] Community POINT

Comments:/Conditions:


Comments:/Conditions: Checked lines 4/13/06 MD
Checked tanks 12/12/06

(1" = 50')

INITIAL SITE SKETCH

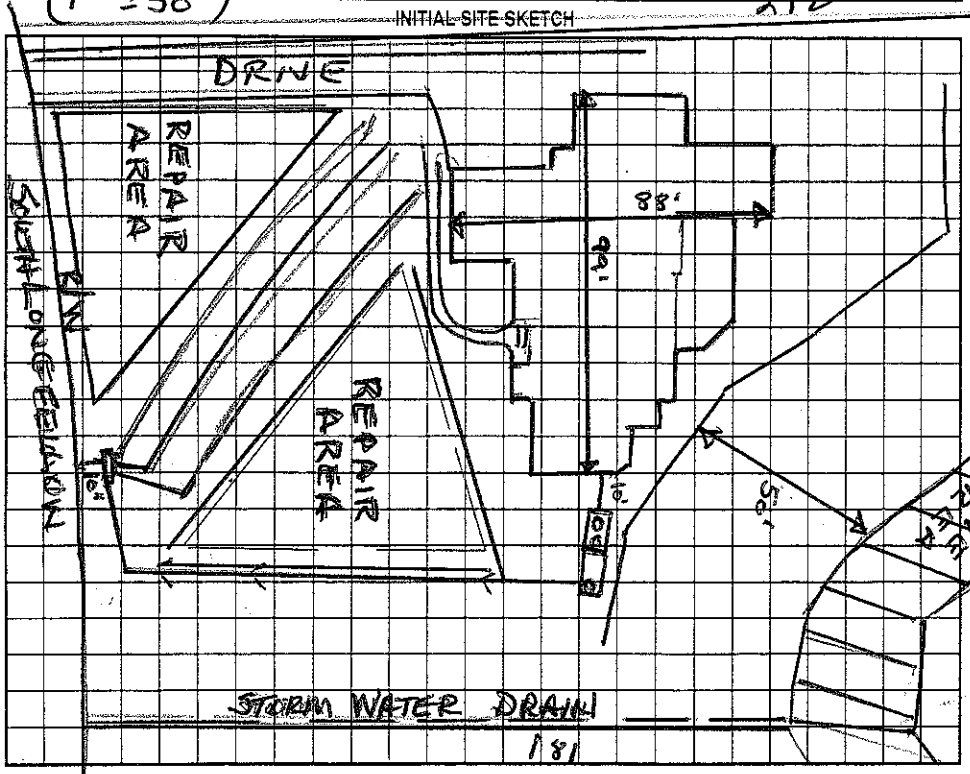

AS BUILT SKETCH

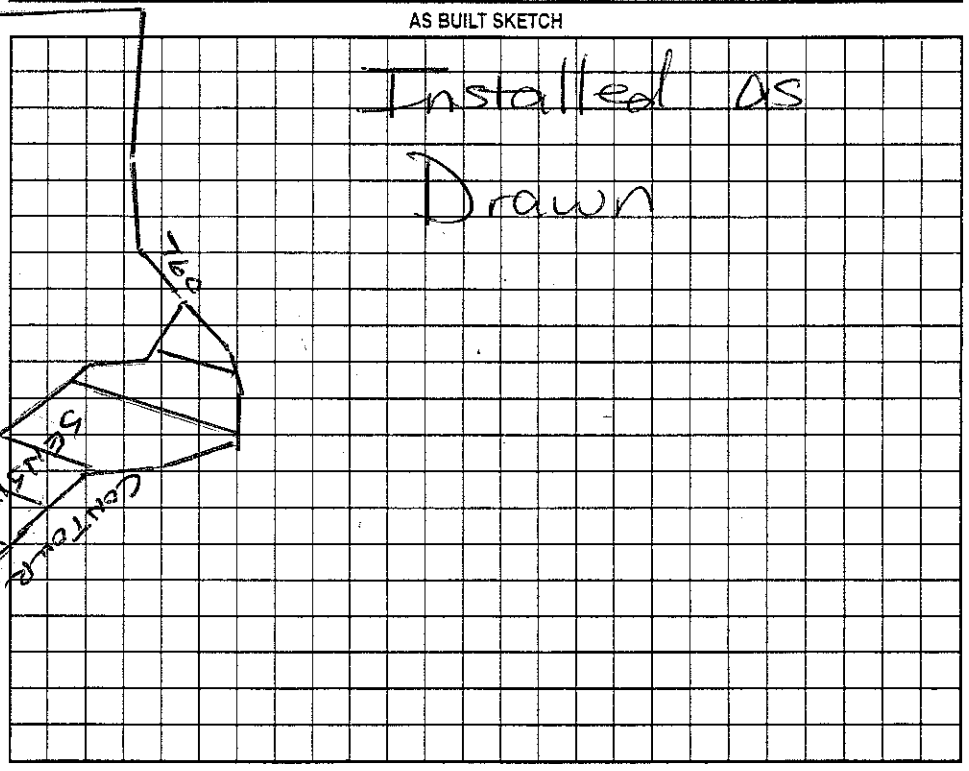

Permit can be suspended or revoked if any false information is supplied toward securing the permit/any unauthorized changes are made to the site/any unauthorized changes are made in the installation of the system. Improvement Permit with plat valid without expiration. Improvement Permit with site plan valid for sixty months. Authorization to Construct is valid for a period equal to that of Improvement Permit – not to exceed sixty months.

Signed: Tammy Caskey CPSS Agent date 8/12/05 Installed by: R & H RS.

Improvement Permit by: Wesley Sparks R.S. date 8/10/05 Operation Permit by: Maria H. Rodas date 12/21/06

Authorization to Construct by: Wesley Sparks R.S. date 8/10/05 Existing System Inspection by: date

HEALTH DEPT. COPY: WHITE OWNER COPY (FINAL): YELLOW OWNER COPY (INITIAL): PINK