IREDELL COUNTY HEALTH DEPARTMENT SC

STATESVILLE 704-878-5305 MOORESVILLE 704-664-5281

IMPROVEMENT PERMIT / AUTHORIZATION TO CONSTRUCT / OPERATION PERMIT / EXISTING SYSTEM INSPECTION

PERMIT# 114655 PIN# 4625718776 4625-70-2302 DATE 6-5-08

OWNER OR APPLICANT Tom Stevenson Building PHONE: Business 660-6638 Home

ADDRESS 570 Williamson Rd. Ste. E Mooresville, NC 28117

LOCATION Brawley School Rd TL New Haven In Circle on South Longfellow

SUBDIVISION The Point BLOCK / SECTION 12 LOT 220 LOT AREA 35,072 SITE CLASS PS DESIGN FLOW 600gpd L.T.A.R. .3

Septic Tank: 1500 Gallons: STB 338 Date 1-28-08

Pump Tank: 1500 Gallons: PT 477 Date 3-25-08

Pump Make: Myers Model ME 50 Serial No.

Nitrification Field: No Fields 1 Square Feet 1500' Linear Feet 500'

No Lines 6 Trench Width 36" Max Trench Bottom Depth 36"

☒ New System ☐ Repair ☐ Expansion System Type: I II III IV V VI

System Description: Pump- 25% Reduction

Repair System Description: Pump-LP-Panel Blk

Maintenance Agreement Required: ☐ Yes ☐ No

☒ House/Mod. Home No. Bedrooms 4 ☐ Mobile Home No. Persons ☐ Business No. Employees ☐ Other


Water Supply: ☐ Individual ☒ Public ☒ Community

Gravel Depth N/A ☐ Gravity ☒ Pressure ☐ Slab ☐ Crawl Space ☒ Basement w/plumbing ☐ Basement wo/plumbing


Comments:/Conditions: Note: Silt pond was filled in 5/14/08 Checked 5 of 6 lines on Drainfield installed Quick 48. 500 84ft. 5/15/08 Checked tanks

Comments:/Conditions: If 6th line not installed then permit would only be 4 Bdrm 11/4/08 Did not install 6th line only approved for 4 Bedrooms

INITIAL SITE SKETCH Scale 1:50'

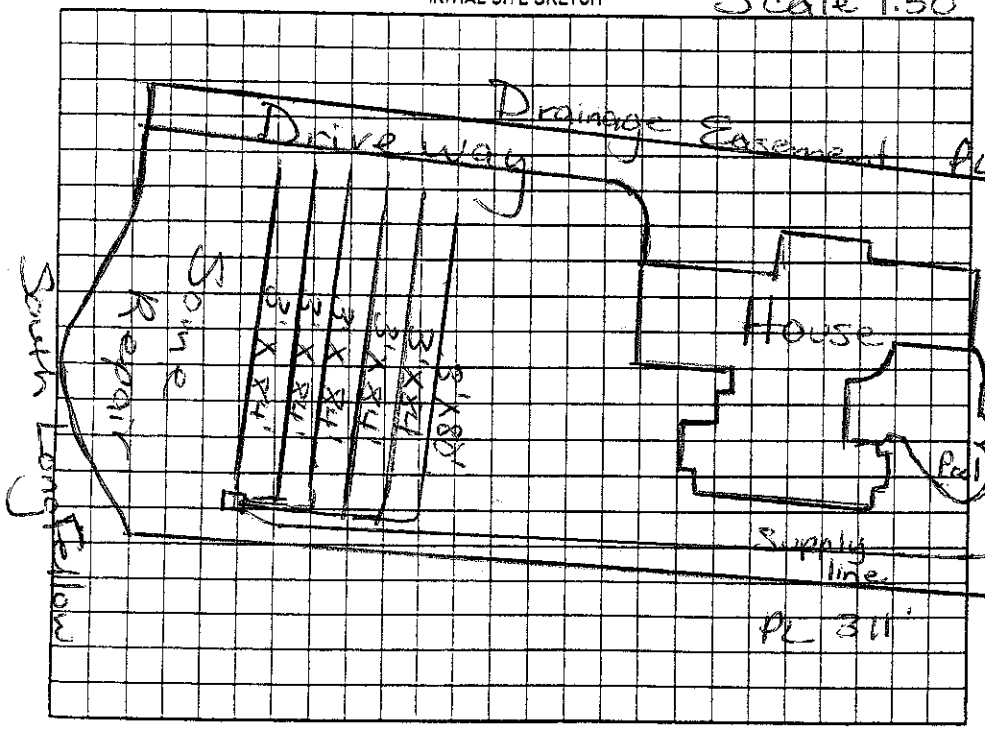

AS BUILT SKETCH

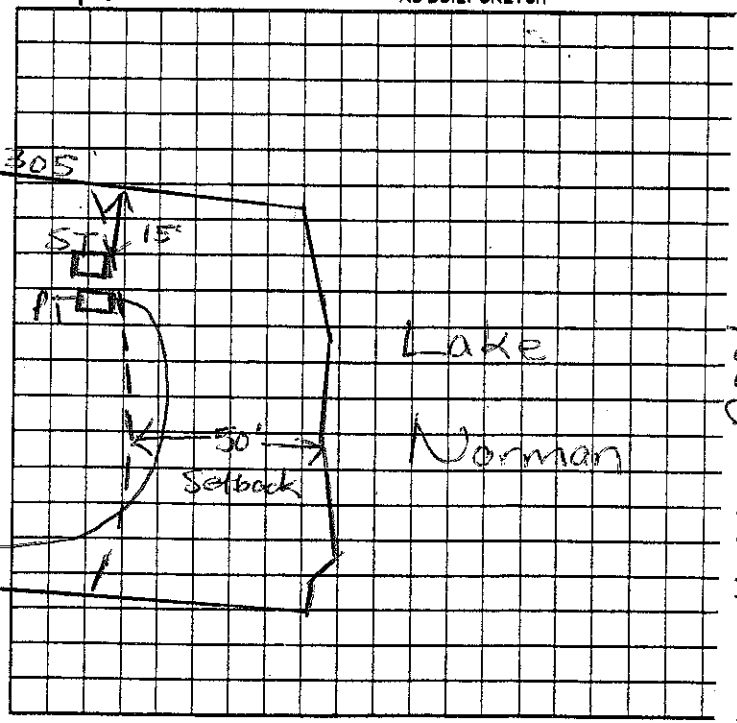

The proposed / existing P.D.D. addition does not appear to impact the existing septic system.

**NOTE:

Date: 11-7-08 R.S.

ICHD-Environmental Health Division

Permit can be suspended or revoked if any false information is supplied toward securing the permit/any unauthorized changes are made to the site/any unauthorized changes are made in the installation of

Permit with plat valid without expiration ☐ Improvement Permit with site plan valid for sixty months ☐ Authorization to Construct is valid for a period equal to that of Improvement Permit – not to exceed sixty months.

Signed: date 8-11-08

Improvement Permit by: Maria H. Dolan RS date 6/5/08

Authorization to Construct by: Maria H. Dolan RS date 6/5/08

Installed by: R.P.

Operation Permit by: Maria H. Dolan RS date 11/4/08

Existing System Inspection by: date

HEALTH DEPT. COPY: WHITE OWNER COPY (FINAL): YELLOW OWNER COPY (INITIAL): PINK