4625711943

IREDELL COUNTY HEALTH DEPARTMENT

STATESVILLE 704-878-5305 MOORESVILLE 704-664-5281

IMPROVEMENT PERMIT / AUTHORIZATION TO CONSTRUCT / OPERATION PERMIT / EXISTING SYSTEM INSPECTION

PERMIT # 114568 PIN # 4625 714 740.000 DATE 3-1-2011

OWNER or APPLICANT Dr. Holly Layman PHONE: Business 704 201-7181 Home: 704 575-3880

OWNER or APPLICANT ADDRESS 19018 Natalie Michelle Cornelius NC 28031

LOCATION / DIRECTIONS Brawley School Rd past traffic circle. On left just after Yorkchit Rd.

SUBDIVISION The Point BLOCK / SECTION 12 LOT # 1230 LOT AREA 52.54 DESIGN FLOW 600 L.T.A.R. 3 Initial / .25 R

Septic Tank 500 Gallons: STB 444 Date 3-4-13

Pump Tank 500 Gallons: PT 477 Date 5-18-13

Pump Make Norweco Model PF500512 Serial #

Nitrification Field No Fields 1 No Lines 5 Linear Feet 335'

Trench Width min 24" Max. Trench Bottom Depth 36" Gravel Depth N/A

☒ New System ☐ Repair ☐ Expansion System Type I II III (IV) V VI

System Description: Pump-LP-Panel Block

Repair System Description: Same

Maintenance Agreement Required ☒ YES ☐ NO

☐ GRAVITY ☒ PRESSURE

☒ Residence No. Bedrooms 5

☐ Business No. Persons

☐ Other No. Employees

☐ Slab ☐ Crawl Space


☒ Basement w/plumbing ☐ Basement w/o plumbing

Water Supply: ☐ Private ☐ Public ☒ Community


Comments / Conditions: FILL AREA IMPACTED ONLY LOWER LINE AND ABOVE (FILL OK) 10' OF FILL

Comments / Conditions: LINES CHECKED 7/24/13

INITIAL SITE SKETCH

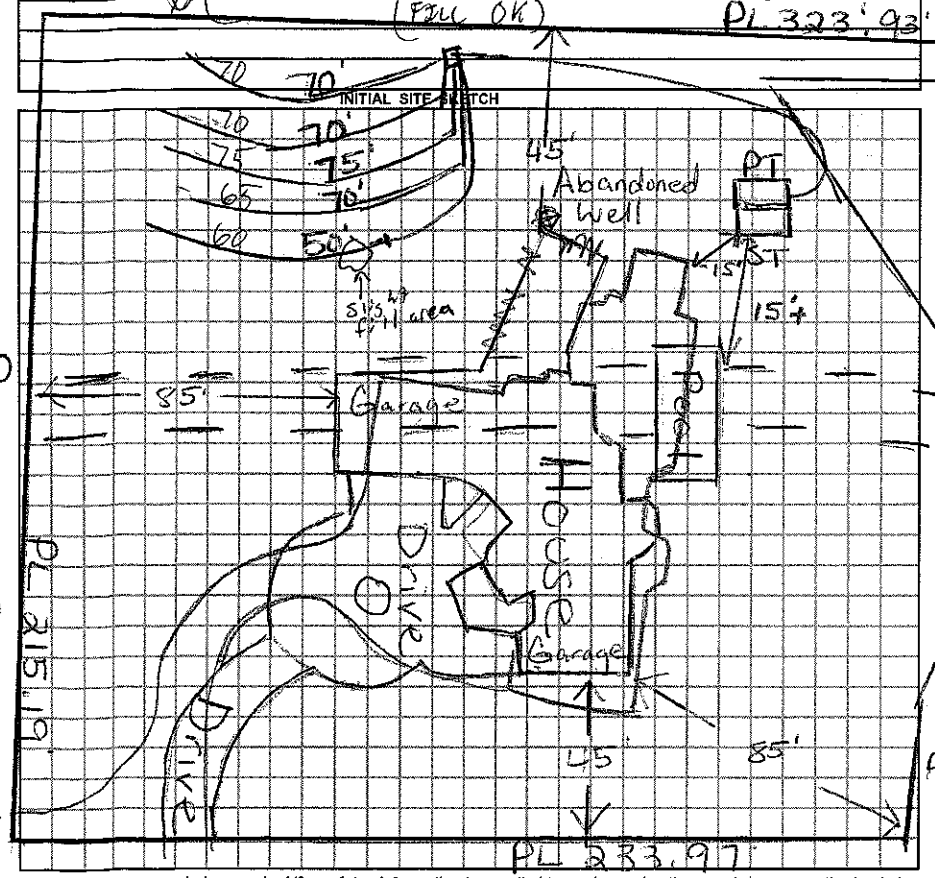

AS BUILT SKETCH

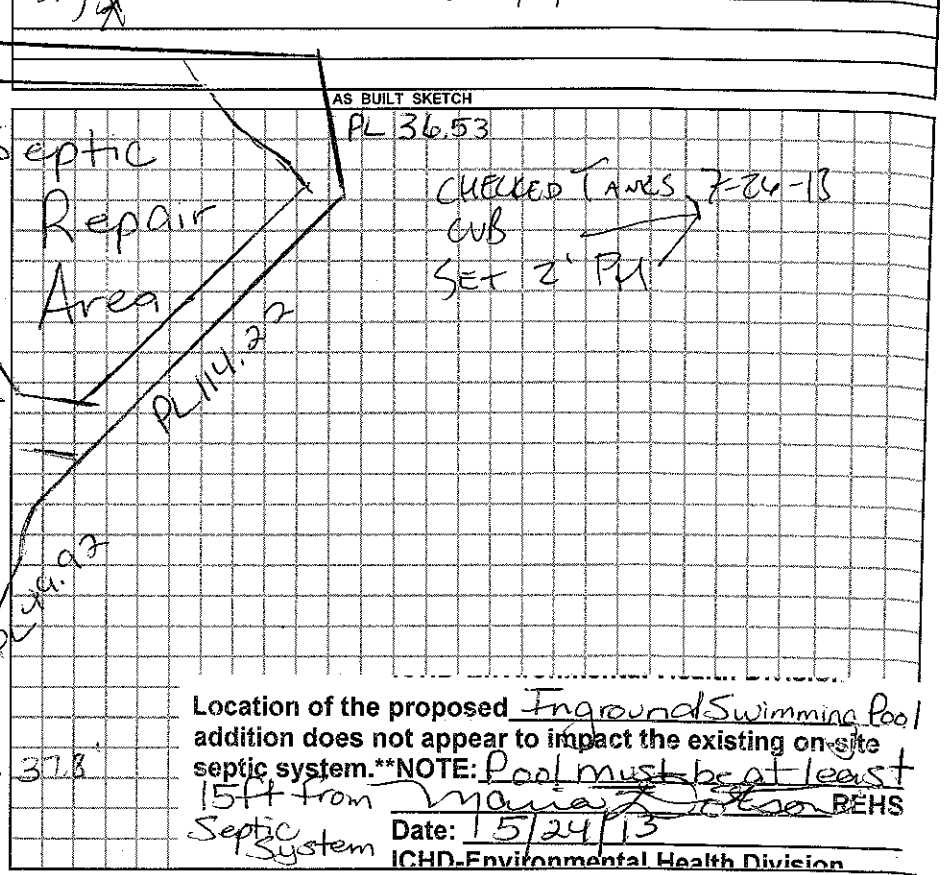

Location of the proposed Inground Swimming Pool addition does not appear to impact the existing on-site septic system.**NOTE: Pool must be at least 15ft from Septic System

Maria H. Dotson REHS

Date: 15/24/13

ICHD-Environmental Health Division

Brawley School Rd

Permit can be suspended or revoked if any false information is supplied toward securing the permit / any unauthorized changes are made to the site / any unauthorized changes are made in the installation of the system.

☐ *IMPROVEMENT PERMIT w / plat valid without expiration.* ☐ *IMPROVEMENT PERMIT w / site plan valid for 60 mos.* ☐ *AUTHORIZATION TO CONSTRUCT valid for period equal to IMPROVEMENT PERMIT-not to exceed 60 mo.*

Owner / Applicant Signature: [signature] Date 3/1/11

Improvement Permit by: Maria H. Dotson REHS Date 3/1/11

Authorization to Construct by: Cindy Melville Date 10-16-12

Installed by: ORBISON

Operation Permit by: Maria H. Dotson RS Date: 11/8/13

Existing System Inspected by: Date:

I SHOULD CONTACT A LOCATOR SERVICE PRIOR TO ANY EXCAVATION.

WHITE COPY Environmental Health YELLOW COPY (Final) Owner / Applicant PINK COPY (Initial) Owner / Applicant