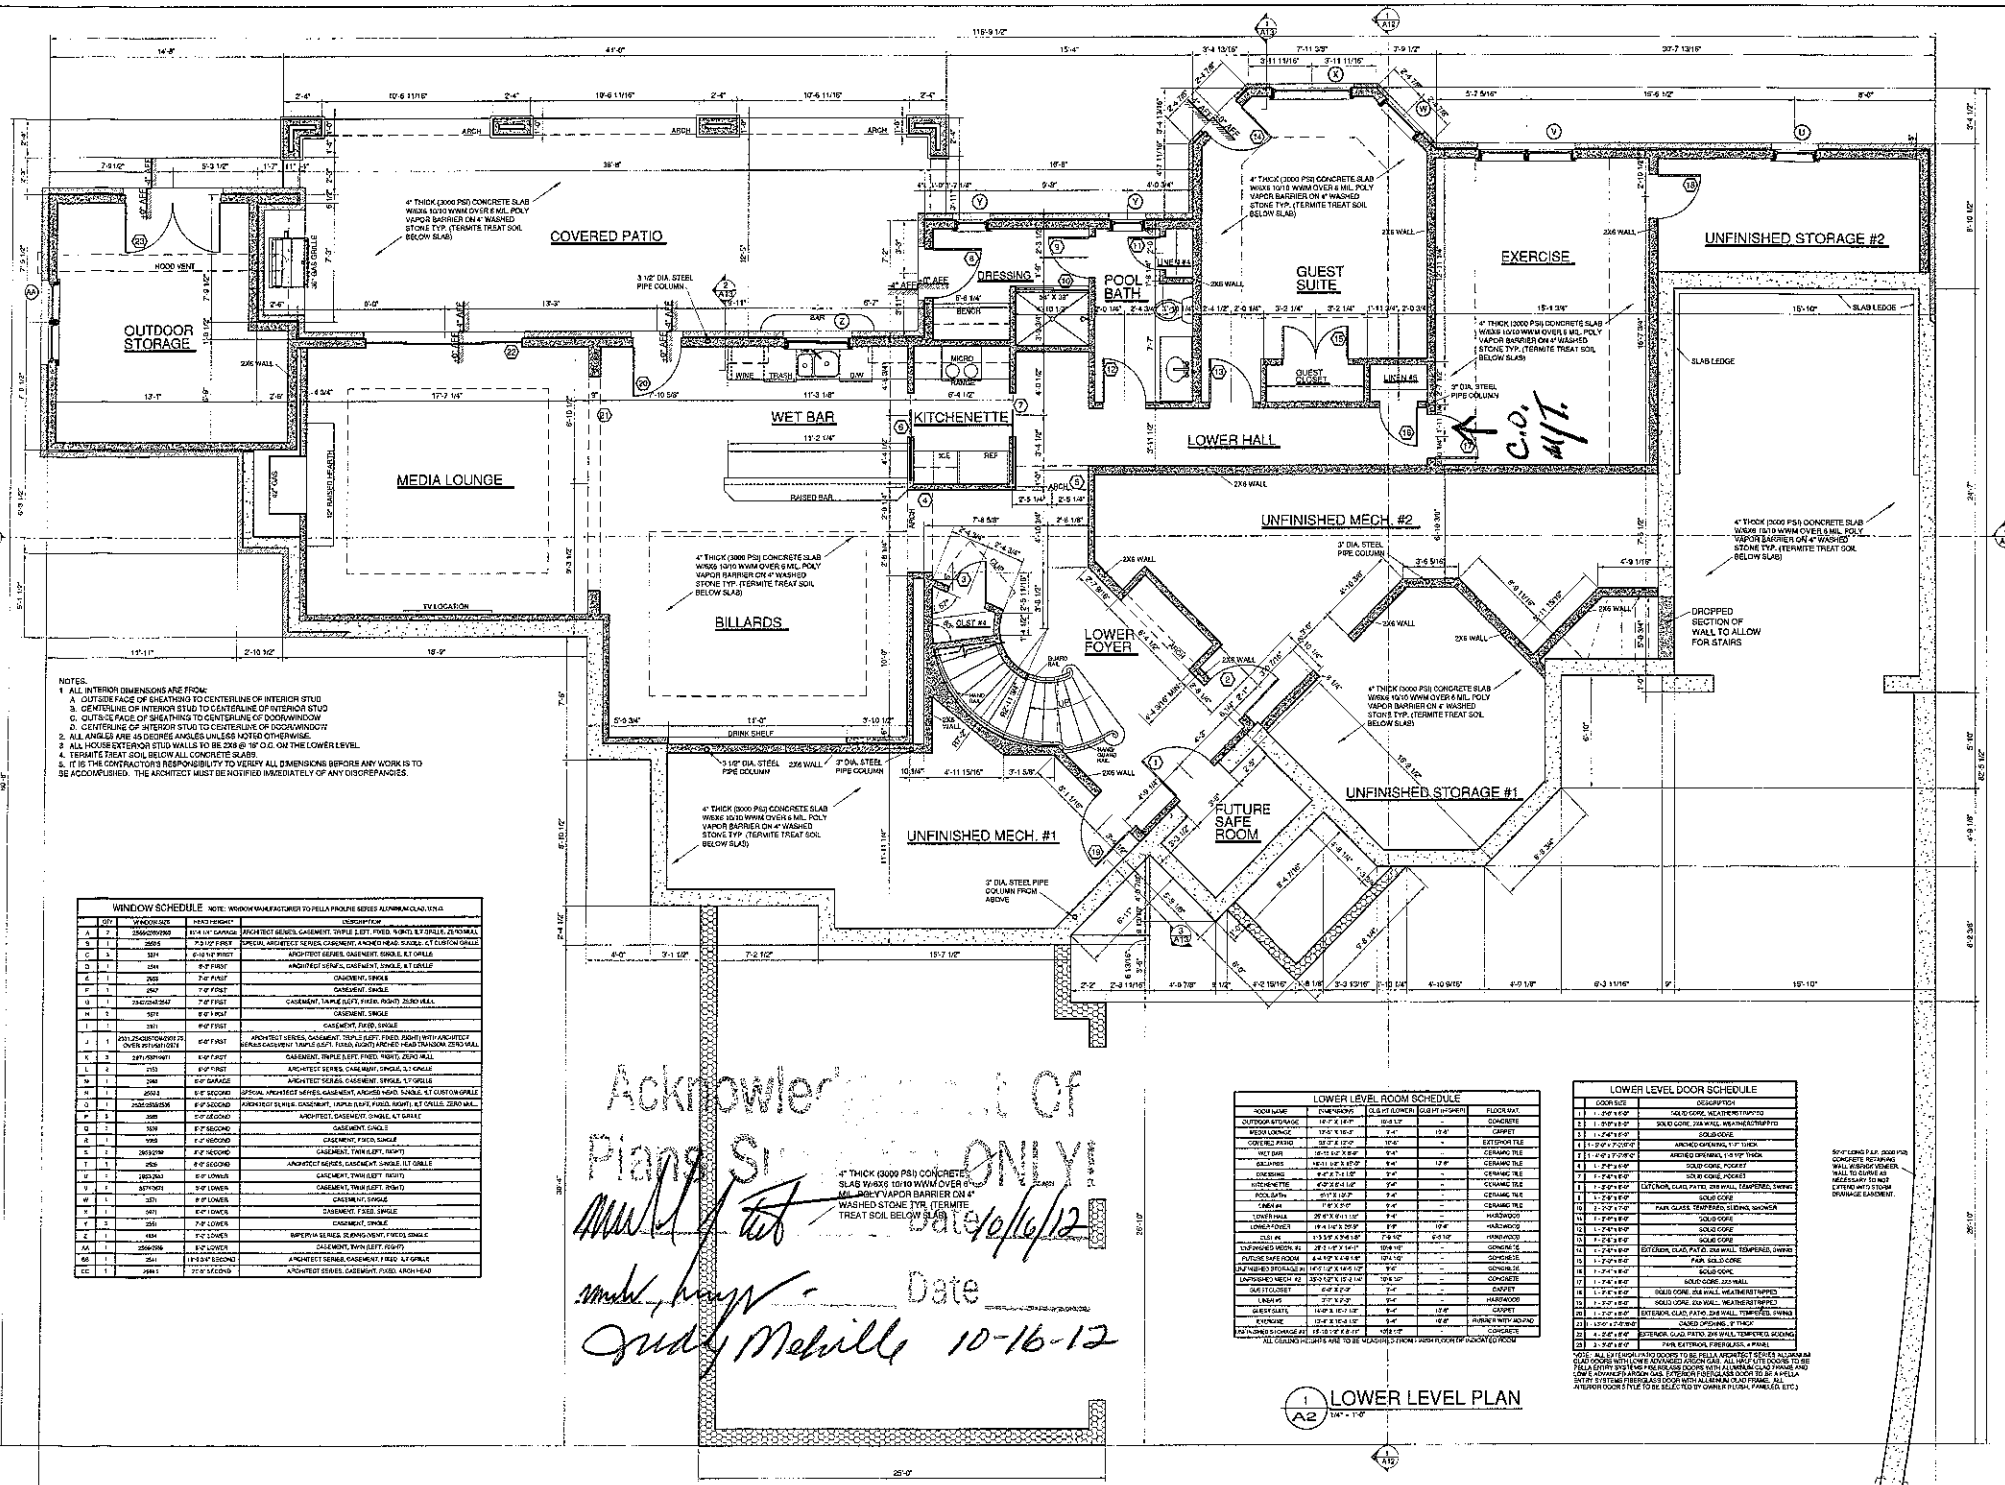


NOTES:
1. ALL INTERIOR DIMENSIONS ARE FROM:
   A. OUTSIDE FACE OF SHEATHING TO CENTERLINE OF INTERIOR STUD
   B. CENTERLINE OF INTERIOR STUD TO CENTERLINE OF INTERIOR STUD
   C. OUTSIDE FACE OF SHEATHING TO CENTERLINE OF DOOR/WINDOW
   D. CENTERLINE OF INTERIOR STUD TO CENTERLINE OF DOOR/WINDOW
2. ALL ANGLES ARE 45 DEGREE ANGLES UNLESS NOTED OTHERWISE.
3. ALL HOUSE EXTERIOR STUD WALLS TO BE 2X6 @ 16" O.C. ON THE LOWER LEVEL.
4. TERMITE TREAT SOIL BELOW ALL CONCRETE SLABS.
5. IT IS THE CONTRACTOR'S RESPONSIBILITY TO VERIFY ALL DIMENSIONS BEFORE ANY WORK IS TO BE ACCOMPLISHED. THE ARCHITECT MUST BE NOTIFIED IMMEDIATELY OF ANY DISCREPANCIES.

WINDOW SCHEDULE NOTE: WINDOW MANUFACTURER TO PELLA PROLINE SERIES ALUMINUM CLAD, U=0.3

	QTY	WINDOW SIZE	HEAD HEIGHT	DESCRIPTION
A	2	2566/2566/2566	8'-0 1/4" GARAGE	ARCHITECT SERIES, CASEMENT, TRIPLE (LEFT, FIXED, RIGHT), 6.7 GRILLE, ZERO WALL
B	1	2668/2	7'-3 1/2" FIRST	SPECIAL ARCHITECT SERIES, CASEMENT, ARCHED HEAD, SINGLE, 6.7 CUSTOM GRILLE
C	3	3264	8'-0 1/2" FIRST	ARCHITECT SERIES, CASEMENT, SINGLE, 6.7 GRILLE
D	1	2264	8'-2" FIRST	ARCHITECT SERIES, CASEMENT, SINGLE, 6.7 GRILLE
E	1	2668	7'-9" FIRST	CASEMENT, SINGLE
F	1	2642	7'-9" FIRST	CASEMENT, SINGLE
G	1	2342/2342/2342	7'-9" FIRST	CASEMENT, TRIPLE (LEFT, FIXED, RIGHT) ZERO WALL
H	3	3070	7'-9" FIRST	CASEMENT, SINGLE
I	1	3070	8'-0" FIRST	CASEMENT, FIXED, SINGLE
J	1	2530_2542/2530/2542/2530 OVER 2570/4810/2570	8'-0" FIRST	ARCHITECT SERIES, CASEMENT, TRIPLE (LEFT, FIXED, RIGHT) WITH ARCHITECT SERIES CASEMENT TRIPLE (LEFT, FIXED, RIGHT) ARCHED HEAD TRANSOM, ZERO WALL
K	3	2970/7030/2970	8'-0" FIRST	CASEMENT, TRIPLE (LEFT, FIXED, RIGHT), ZERO WALL
L	2	2170	8'-0" FIRST	ARCHITECT SERIES, CASEMENT, SINGLE, 6.7 GRILLE
M	1	2068	8'-0" GARAGE	ARCHITECT SERIES, CASEMENT, SINGLE, 6.7 GRILLE
N	1	2668/2	8'-0" SECOND	SPECIAL ARCHITECT SERIES, CASEMENT, ARCHED HEAD, SINGLE, 6.7 CUSTOM GRILLE
O	1	2566/2566/2566	8'-0" SECOND	ARCHITECT SERIES, CASEMENT, TRIPLE (LEFT, FIXED, RIGHT), 6.7 GRILLE, ZERO WALL
P	3	3068	8'-0" SECOND	ARCHITECT, CASEMENT, SINGLE, 6.7 GRILLE
Q	2	3068	8'-0" SECOND	CASEMENT, SINGLE
R	1	2668	8'-0" SECOND	CASEMENT, FIXED, SINGLE
S	2	2670/2670	8'-0" SECOND	CASEMENT, TWIN (LEFT, RIGHT)
T	1	2670	8'-0" SECOND	ARCHITECT SERIES, CASEMENT, SINGLE, 6.7 GRILLE
U	1	2670/2670	8'-0" LOWER	CASEMENT, TWIN (LEFT, RIGHT)
V	1	2670/2670	8'-0" LOWER	CASEMENT, TWIN (LEFT, RIGHT)
W	1	2670	8'-0" LOWER	CASEMENT, SINGLE
X	1	2670	8'-0" LOWER	CASEMENT, FIXED, SINGLE
Y	3	2668	7'-0" LOWER	CASEMENT, SINGLE
Z	1	4864	8'-0" LOWER	BIFOLD/4 SERIES, SLIDING VENT, FIXED, SINGLE
AA	1	2566/2566	8'-0" LOWER	CASEMENT, TWIN (LEFT, RIGHT)
BB	1	2541	11'-0 3/4" SECOND	ARCHITECT SERIES, CASEMENT, FIXED, 6.7 GRILLE
CC	1	2566 1	7'-0 5" SECOND	ARCHITECT SERIES, CASEMENT, FIXED, ARCH HEAD

LOWER LEVEL ROOM SCHEDULE

ROOM NAME	WINDOWS	CLG HT (LOWER)	CLG HT (HIGHER)	FLOOR MAT.
OUTDOOR STORAGE	18'-7" X 18'-7"	10'-0 1/2"	-	CONCRETE
MEDIA LOUNGE	17'-5" X 18'-5"	7'-4"	12'-6"	CARPET
COVERED PATIO	58'-2" X 12'-2"	10'-6"	-	EXTERIOR TILE
WET BAR	13'-11 1/2" X 8'-6"	9'-4"	-	CERAMIC TILE
BILLARDS	18'-11 1/2" X 17'-3"	9'-4"	12'-6"	CERAMIC TILE
DRESSING	8'-4" X 7'-11 1/2"	9'-4"	-	CERAMIC TILE
KITCHENETTE	8'-2" X 6'-4 1/2"	9'-4"	-	CERAMIC TILE
POOL BATH	8'-11" X 8'-2"	9'-4"	-	CERAMIC TILE
CANEVA	7'-8" X 5'-0"	9'-4"	-	CERAMIC TILE
LOWER HALL	3'-6" X 10'-11 1/2"	9'-4"	-	HARDWOOD
LOWER FOYER	19'-4 1/4" X 25'-9"	9'-4"	12'-6"	HARDWOOD
CLOSET #4	1'-1 3/8" X 4'-9 1/8"	7'-6 1/2"	9'-0 1/2"	HARDWOOD
UNFINISHED MECH. #2	28'-1" X 24'-1"	10'-6 1/2"	-	CONCRETE
FUTURE SAFE ROOM	4'-4 1/2" X 4'-9 1/8"	10'-1 1/2"	-	CONCRETE
UNFINISHED STORAGE #1	41'-7 1/2" X 14'-5 1/2"	10'-6 1/2"	-	CONCRETE
UNFINISHED MECH. #1	28'-1" X 24'-1"	10'-6 1/2"	-	CONCRETE
QUEST CLOSET	6'-6" X 2'-0"	7'-4"	-	CARPET
LINEN #5	2'-7" X 5'-2"	7'-4"	-	HARDWOOD
QUEST SUITE	14'-8" X 15'-1 1/8"	9'-4"	12'-6"	CARPET
EXERCISE	12'-6" X 15'-4 1/2"	9'-4"	12'-6"	RUBBER WITH MOPAD
UNFINISHED STORAGE #2	15'-10 1/2" X 8'-0 1/2"	10'-6 1/2"	-	CONCRETE

ALL CEILING HEIGHTS ARE TO BE MEASURED FROM FINISH FLOOR OF INDICATED ROOM

LOWER LEVEL DOOR SCHEDULE

	DOOR SIZE	DESCRIPTION
1	1'-3"x7'-0"	SOLID CORE, WEATHERSTRIPPED
2	3'-0"x7'-0"	SOLID CORE, 2X6 WALL, WEATHERSTRIPPED
3	1'-2"x7'-0"	SOLID CORE
4	1'-3"x7'-0"	ARCHED OPENING, 1'-1" THICK
5	1'-6"x7'-0"	ARCHED OPENING, 1'-1" THICK
6	1'-3"x7'-0"	SOLID CORE, POCKET
7	1'-2"x7'-0"	SOLID CORE, POCKET
8	1'-3"x7'-0"	EXTERIOR, CLAD, PATIO, 2X6 WALL, TEMPERED, SWING
9	1'-2"x7'-0"	SOLID CORE
10	2'-3"x7'-0"	PAIR, GLASS, TEMPERED, SLIDING, SHOWER
11	1'-3"x7'-0"	SOLID CORE
12	1'-3"x7'-0"	SOLID CORE
13	1'-3"x7'-0"	SOLID CORE
14	1'-3"x7'-0"	EXTERIOR, CLAD, PATIO, 2X6 WALL, TEMPERED, SWING
15	1'-3"x7'-0"	PAIR, SOLID CORE
16	1'-3"x7'-0"	SOLID CORE
17	1'-3"x7'-0"	SOLID CORE, 2X6 WALL
18	1'-3"x7'-0"	SOLID CORE, 2X6 WALL, WEATHERSTRIPPED
19	1'-3"x7'-0"	SOLID CORE, 2X6 WALL, WEATHERSTRIPPED
20	1'-3"x7'-0"	EXTERIOR, CLAD, PATIO, 2X6 WALL, TEMPERED, SWING
21	1'-0"x7'-0"x6'-0"	CASED OPENING, 2" THICK
22	4'-3"x8'-0"x8'-0"	EXTERIOR, CLAD, PATIO, 2X6 WALL, TEMPERED, SLIDING
23	3'-3"x8'-0"x8'-0"	PAIR, EXTERIOR, FIRE GLASS, 4 PANEL

NOTE: ALL EXTERIOR PATIO DOORS TO BE PELLA ARCHITECT SERIES ALUMINUM CLAD DOORS WITH LOWE ADVANTAGE ARGON GAS. ALL INTERIOR DOORS TO BE PELLA ARCHITECT SERIES SOLID CORE DOORS WITH ALDER DOOR TO BE APPLIED LOWE SMART ARGON GAS. EXTERIOR DOOR TO BE PELLA ASS DOOR TO BE APPLIED SMART SYSTEMS FIRE GLASS DOOR WITH ALUMINUM CLAD FRAME. ALL PELLA INTERIOR DOORS STYLE TO BE SELECTED BY OWNER (FLUSH, PANELED, ETC.)


8'-0" LONG P.S.F. 3000 PSI CONCRETE RETAINING WALL W/BRICK VENEER. WALL TO CURVE AS NECESSARY TO NOT EXTEND INTO STORM DRAINAGE EASEMENT.

Acknowledgement of Plans Submission ONLY
Date 10/16/12
Date
Judy Melville 10-16-12

1 A2 LOWER LEVEL PLAN
1/4" = 1'-0"

PROJECT NAME AND ADDRESS
Layman Residence

DRAWING TITLE

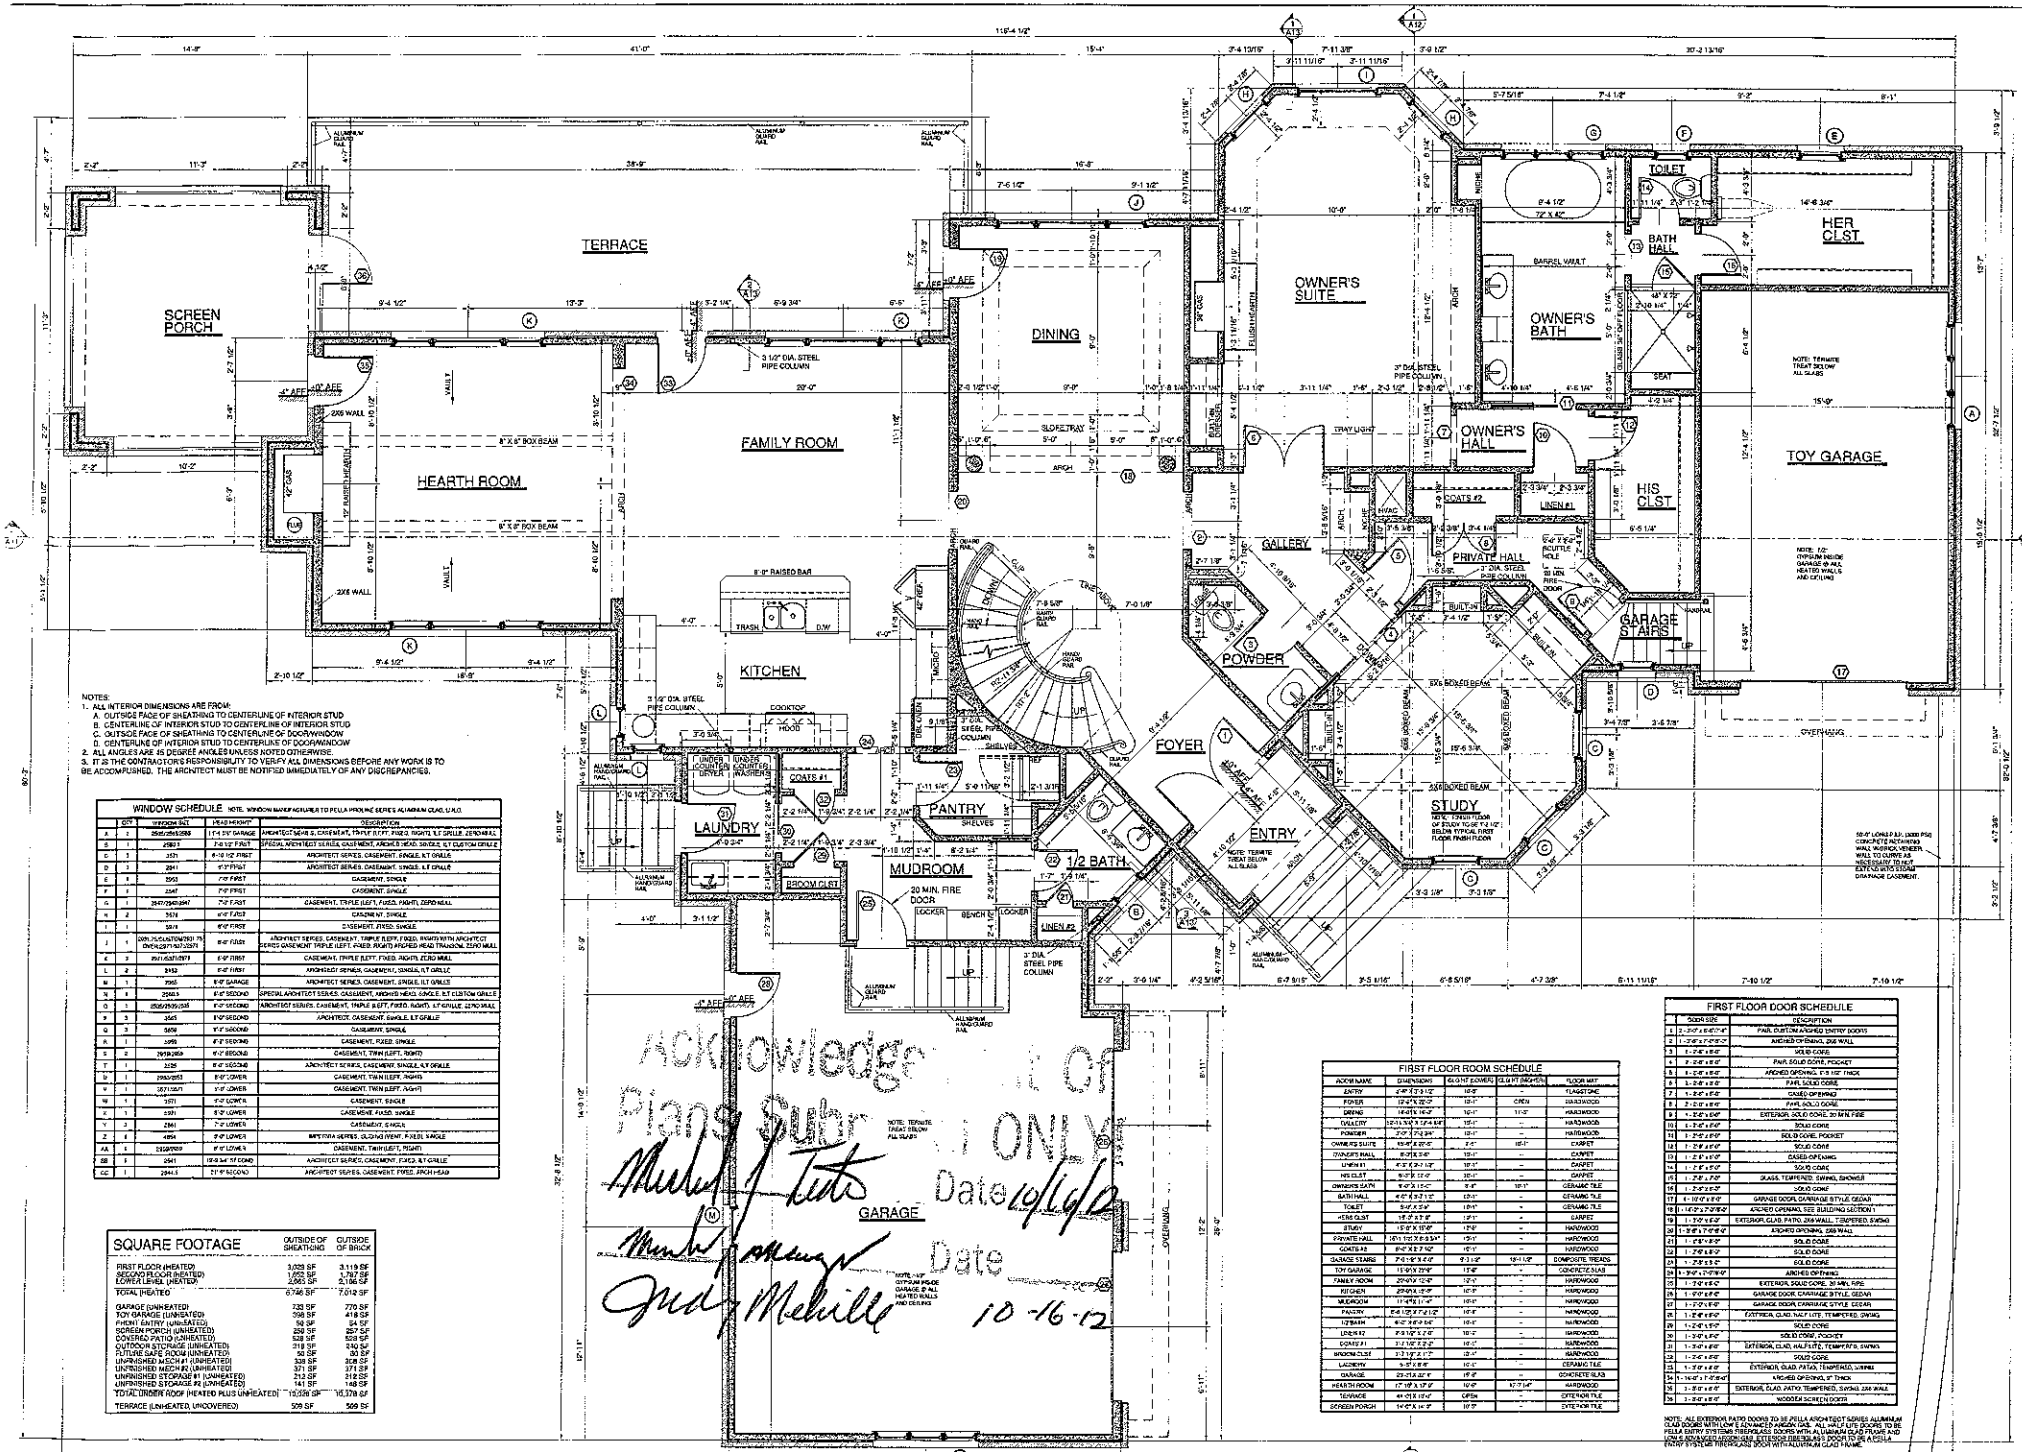

NOTES:
1. ALL INTERIOR DIMENSIONS ARE FROM:
   A. OUTSIDE FACE OF SHEATHING TO CENTERLINE OF INTERIOR STUD
   B. CENTERLINE OF INTERIOR STUD TO CENTERLINE OF INTERIOR STUD
   C. OUTSIDE FACE OF SHEATHING TO CENTERLINE OF DOOR/WINDOW
   D. CENTERLINE OF INTERIOR STUD TO CENTERLINE OF DOOR/WINDOW
2. ALL ANGLES ARE 45 DEGREE ANGLES UNLESS NOTED OTHERWISE.
3. IT IS THE CONTRACTOR'S RESPONSIBILITY TO VERIFY ALL DIMENSIONS BEFORE ANY WORK IS TO BE ACCOMPLISHED. THE ARCHITECT MUST BE NOTIFIED IMMEDIATELY OF ANY DISCREPANCIES.

WINDOW SCHEDULE NOTE: WINDOW MANUFACTURER TO PELLA PROVIDE SERIES ALUMINUM CLAD, U-0.0

QTY	WINDOW SIZE	HEAD HEIGHT*	DESCRIPTION
A	2	2646/2653/2659	11'-4 3/8" GARAGE	ARCHITECT SERIES, CASEMENT, TRIPLE (LEFT, FIXED, RIGHT), LT GRILLE, ZERO MULL
B	1	2580 1	7'-6 1/2" FIRST	SPECIAL ARCHITECT SERIES, CASEMENT, ARCHED HEAD, SINGLE, LT CUSTOM GRILLE
C	3	2571	8'-10 1/2" FIRST	ARCHITECT SERIES, CASEMENT, SINGLE, LT GRILLE
D	1	2041	8'-0" FIRST	ARCHITECT SERIES, CASEMENT, SINGLE, LT GRILLE
E	1	2653	7'-0" FIRST	CASEMENT, SINGLE
F	1	2647	7'-0" FIRST	CASEMENT, SINGLE
G	1	2647/2647/2647	7'-0" FIRST	CASEMENT, TRIPLE (LEFT, FIXED, RIGHT), ZERO MULL
H	2	3676	8'-0" FIRST	CASEMENT, SINGLE
I	1	3676	8'-0" FIRST	CASEMENT, FIXED, SINGLE
J	1	2068 (FIXED)/2068/2651 (TR DH)/2651/2651/2651	8'-0" FIXED	ARCHITECT SERIES, CASEMENT, TRIPLE (LEFT, FIXED, RIGHT) WITH ARCHITECT SERIES CASEMENT TRIPLE (LEFT, FIXED, RIGHT) ARCHED HEAD TRANSOM, ZERO MULL
K	3	2651/2651/2651	8'-0" FIRST	CASEMENT, TRIPLE (LEFT, FIXED, RIGHT), ZERO MULL
L	2	3153	8'-0" FIRST	ARCHITECT SERIES, CASEMENT, SINGLE, LT GRILLE
M	1	2068	8'-0" GARAGE	ARCHITECT SERIES, CASEMENT, SINGLE, LT GRILLE
N	6	2068 3	8'-0" SECOND	SPECIAL ARCHITECT SERIES, CASEMENT, ARCHED HEAD, SINGLE, LT CUSTOM GRILLE
O	1	2068/2068/2068	10'-0" SECOND	ARCHITECT SERIES, CASEMENT, TRIPLE (LEFT, FIXED, RIGHT), LT GRILLE, ZERO MULL
P	3	2545	9'-0" SECOND	ARCHITECT, CASEMENT, SINGLE, LT GRILLE
Q	3	3656	9'-0" SECOND	CASEMENT, SINGLE
R	1	3656	8'-0" SECOND	CASEMENT, FIXED, SINGLE
S	2	2659/2659	8'-0" SECOND	CASEMENT, TWIN (LEFT, RIGHT)
T	1	3126	8'-0" SECOND	ARCHITECT SERIES, CASEMENT, SINGLE, LT GRILLE
U	1	2653/2653	8'-0" LOWER	CASEMENT, TWIN (LEFT, RIGHT)
V	1	3571/3571	9'-0" LOWER	CASEMENT, TWIN (LEFT, RIGHT)
W	1	3571	9'-0" LOWER	CASEMENT, SINGLE
X	1	3191	8'-0" LOWER	CASEMENT, FIXED, SINGLE
Y	3	2661	7'-0" LOWER	CASEMENT, SINGLE
Z	6	4854	8'-0" LOWER	IMPERIA SERIES, SLIDING PATIO DOOR, SINGLE
AA	1	2150/2650	8'-0" LOWER	CASEMENT, TWIN (LEFT, RIGHT)
BB	1	2641	10'-0 3/4" TO CORD	ARCHITECT SERIES, CASEMENT, FIXED, LT GRILLE
CC	1	2644 3	21'-9" SECOND	ARCHITECT SERIES, CASEMENT, FIXED, ARCH HEAD

SQUARE FOOTAGE

	OUTSIDE OF SHEATHING	OUTSIDE OF BRICK
FIRST FLOOR (HEATED)	3,023 SF	3,119 SF
SECOND FLOOR (HEATED)	1,065 SF	1,787 SF
LOWER LEVEL (HEATED)	2,668 SF	2,106 SF
TOTAL (HEATED)	6,756 SF	7,012 SF
GARAGE (UNHEATED)	733 SF	770 SF
TOY GARAGE (UNHEATED)	398 SF	418 SF
FRONT ENTRY (UNHEATED)	50 SF	54 SF
SCREEN PORCH (UNHEATED)	256 SF	257 SF
COVERED PATIO (UNHEATED)	528 SF	528 SF
OUTDOOR STORAGE (UNHEATED)	318 SF	340 SF
FUTURE SAFE ROOM (UNHEATED)	30 SF	30 SF
UNFINISHED MECH #1 (UNHEATED)	338 SF	368 SF
UNFINISHED MECH #2 (UNHEATED)	371 SF	371 SF
UNFINISHED STORAGE #1 (UNHEATED)	212 SF	212 SF
UNFINISHED STORAGE #2 (UNHEATED)	141 SF	148 SF
TOTAL UNDER ROOF (HEATED PLUS UNHEATED)	15,009 SF	16,370 SF
TERRACE (UNHEATED, UNCOVERED)	509 SF	509 SF

FIRST FLOOR ROOM SCHEDULE

ROOM NAME	DIMENSIONS	CEILING HEIGHT	CEILING FINISH	FLOOR MAT.
ENTRY	7'-0" X 7'-0 1/2"	10'-0"	-	FLAGSTONE
FOYER	12'-4" X 12'-2"	10'-0"	OPEN	SANDSTONE
DINING	14'-4" X 14'-0"	10'-1"	11'-0"	HARDWOOD
GALLERY	12'-1 1/4" X 12'-4 3/4"	10'-1"	-	HARDWOOD
FOYER	7'-0" X 7'-0 3/4"	10'-1"	-	HARDWOOD
OWNER'S SUITE	15'-4" X 21'-0"	9'-1"	10'-1"	CARPET
OWNER'S HALL	8'-0" X 9'-4"	9'-1"	-	CARPET
LINEN #1	4'-5" X 2'-3 1/2"	10'-1"	-	CARPET
HIS CLST	6'-5" X 9'-0"	10'-1"	-	CARPET
OWNER'S BATH	9'-4" X 15'-4"	9'-1"	10'-1"	CERAMIC TILE
BATH HALL	4'-6" X 9'-1 1/2"	10'-1"	-	CERAMIC TILE
TOILET	5'-4" X 5'-4"	10'-1"	-	CERAMIC TILE
HER CLST	14'-3" X 9'-1"	10'-1"	-	CARPET
BATH #2	11'-9" X 15'-8"	10'-1"	-	HARDWOOD
PRIVATE HALL	14'-11 1/2" X 6'-9 3/4"	10'-1"	-	HARDWOOD
COATS #2	6'-4" X 3'-7 1/2"	10'-1"	-	HARDWOOD
GARAGE STAIRS	7'-6 1/2" X 7'-0"	9'-1 1/2"	10'-1 1/2"	COMPOSITE TREADS
TOY GARAGE	18'-4" X 21'-8"	11'-9"	-	CONCRETE SLAB
FAMILY ROOM	20'-4" X 12'-8"	10'-2"	-	HARDWOOD
KITCHEN	20'-8" X 15'-9"	10'-2"	-	HARDWOOD
MUDROOM	11'-4" X 9'-11"	10'-2"	-	HARDWOOD
PANTRY	5'-4 1/2" X 7'-1 1/2"	10'-2"	-	HARDWOOD
1/2 BATH	6'-2" X 6'-6"	10'-2"	-	HARDWOOD
LINEN #2	3'-9 1/2" X 5'-0"	10'-2"	-	HARDWOOD
LAUNDRY	9'-3" X 11'-0"	10'-2"	-	CERAMIC TILE
GARAGE	23'-2 1/2" X 37'-9"	9'-1"	-	CONCRETE SLAB
HEARTH ROOM	17'-7" X 17'-7"	10'-0"	11'-7 1/4"	HARDWOOD
TERRACE	41'-0" X 15'-4"	OPEN	-	EXTERIOR TILE
SCREEN PORCH	14'-0" X 14'-3"	10'-3"	-	EXTERIOR TILE

FIRST FLOOR DOOR SCHEDULE

DOOR SIZE	DESCRIPTION
1 2'-0" X 8'-0 1/2"	PAIR, CUSTOM ARCHED ENTRY DOORS
2 1'-6" X 7'-0 1/2"	ARCHED OPENING, 2X6 WALL
3 1'-4" X 8'-0"	SOLID CORE
4 1'-0" X 8'-0"	PAIR, SOLID CORE, POCKET
5 1'-0" X 8'-0"	ARCHED OPENING 6'-3 1/2" THICK
6 1'-3" X 8'-0"	PAIR, SOLID CORE
7 1'-6" X 8'-0"	CASED OPENING
8 2'-0" X 8'-0"	PAIR, SOLID CORE
9 1'-0" X 7'-0"	EXTERIOR, SOLID CORE, 20 MIN FIRE
10 1'-3" X 8'-0"	SOLID CORE
11 2'-0" X 8'-0"	SOLID CORE, POCKET
12 2'-0" X 8'-0"	SOLID CORE
13 1'-3" X 8'-0"	CASED OPENING
14 1'-3" X 8'-0"	SOLID CORE
15 1'-3" X 7'-0"	GLASS, TEMPERED, SWING, SHOWER
16 1'-3" X 8'-0"	SOLID CORE
17 9'-0" X 8'-0"	GARAGE DOOR, CARRIAGE STYLE, CEDAR
18 11'-10" X 7'-9 1/2"	ARCHED OPENING, SEE BUILDING SECTION 1
19 3'-0" X 6'-8"	EXTERIOR, CLAD, PATIO, 2X6 WALL, TEMPERED, SWING
20 11'-9 1/2" X 7'-6"	ARCHED OPENING, 2X6 WALL
21 1'-6" X 8'-0"	SOLID CORE
22 1'-3" X 8'-0"	SOLID CORE
23 1'-3" X 8'-0"	SOLID CORE
24 1'-3" X 7'-0"	SOLID CORE
25 1'-3" X 7'-0"	SOLID CORE
26 1'-3" X 7'-0"	ARCHED OPENING
27 1'-0" X 7'-0"	EXTERIOR, SOLID CORE, 20 MIN. FIRE
28 1'-0" X 8'-0"	GARAGE DOOR, CARRIAGE STYLE, CEDAR
29 9'-0" X 8'-0"	GARAGE DOOR, CARRIAGE STYLE, CEDAR
30 2'-0" X 8'-0"	ENTRY DOOR, CLAD, TEMPERED, SWING
31 1'-6" X 8'-0"	GARAGE DOOR, CARRIAGE STYLE, CEDAR
32 1'-3" X 8'-0"	SOLID CORE
33 1'-3" X 8'-0"	SOLID CORE, POCKET
34 1'-3" X 8'-0"	EXTERIOR, CLAD, HALF LITE, TEMPERED, SWING
35 1'-3" X 8'-0"	SOLID CORE
36 1'-3" X 8'-0"	EXTERIOR, CLAD, PATIO, TEMPERED, SWING
37 1'-3" X 8'-0"	WOODEN SCREEN DOORS
38 1'-3" X 8'-0"	ARCHED OPENING, 2X6 WALL
39 1'-3" X 8'-0"	EXTERIOR, CLAD, PATIO, TEMPERED, SWING, 2X6 WALL
40 1'-3" X 8'-0"	WOODEN SCREEN DOORS


NOTE: ALL EXTERIOR PATIO DOORS TO BE PELLA ARCHITECT SERIES ALUMINUM CLAD DOORS WITH LOW E ENHANCED ARGON GAS. ALL VINYL LITE DOORS TO BE PELLA ENTRY SYSTEMS FIBERGLASS DOORS WITH ALUMINUM CLAD FRAME AND LOW E ENHANCED ARGON GAS. EXTERIOR SWING DOOR TO BE A PELLA ENTRY SYSTEMS FIBERGLASS DOOR WITH ALUMINUM CLAD FRAME.

2'-0" X 2'-0" BRICK PILASTER AT END OF RETAINING WALL

1 / A3 FIRST FLOOR PLAN 1/4" = 1'-0"

PROJECT NAME AND ADDRESS

DRAWING TITLE

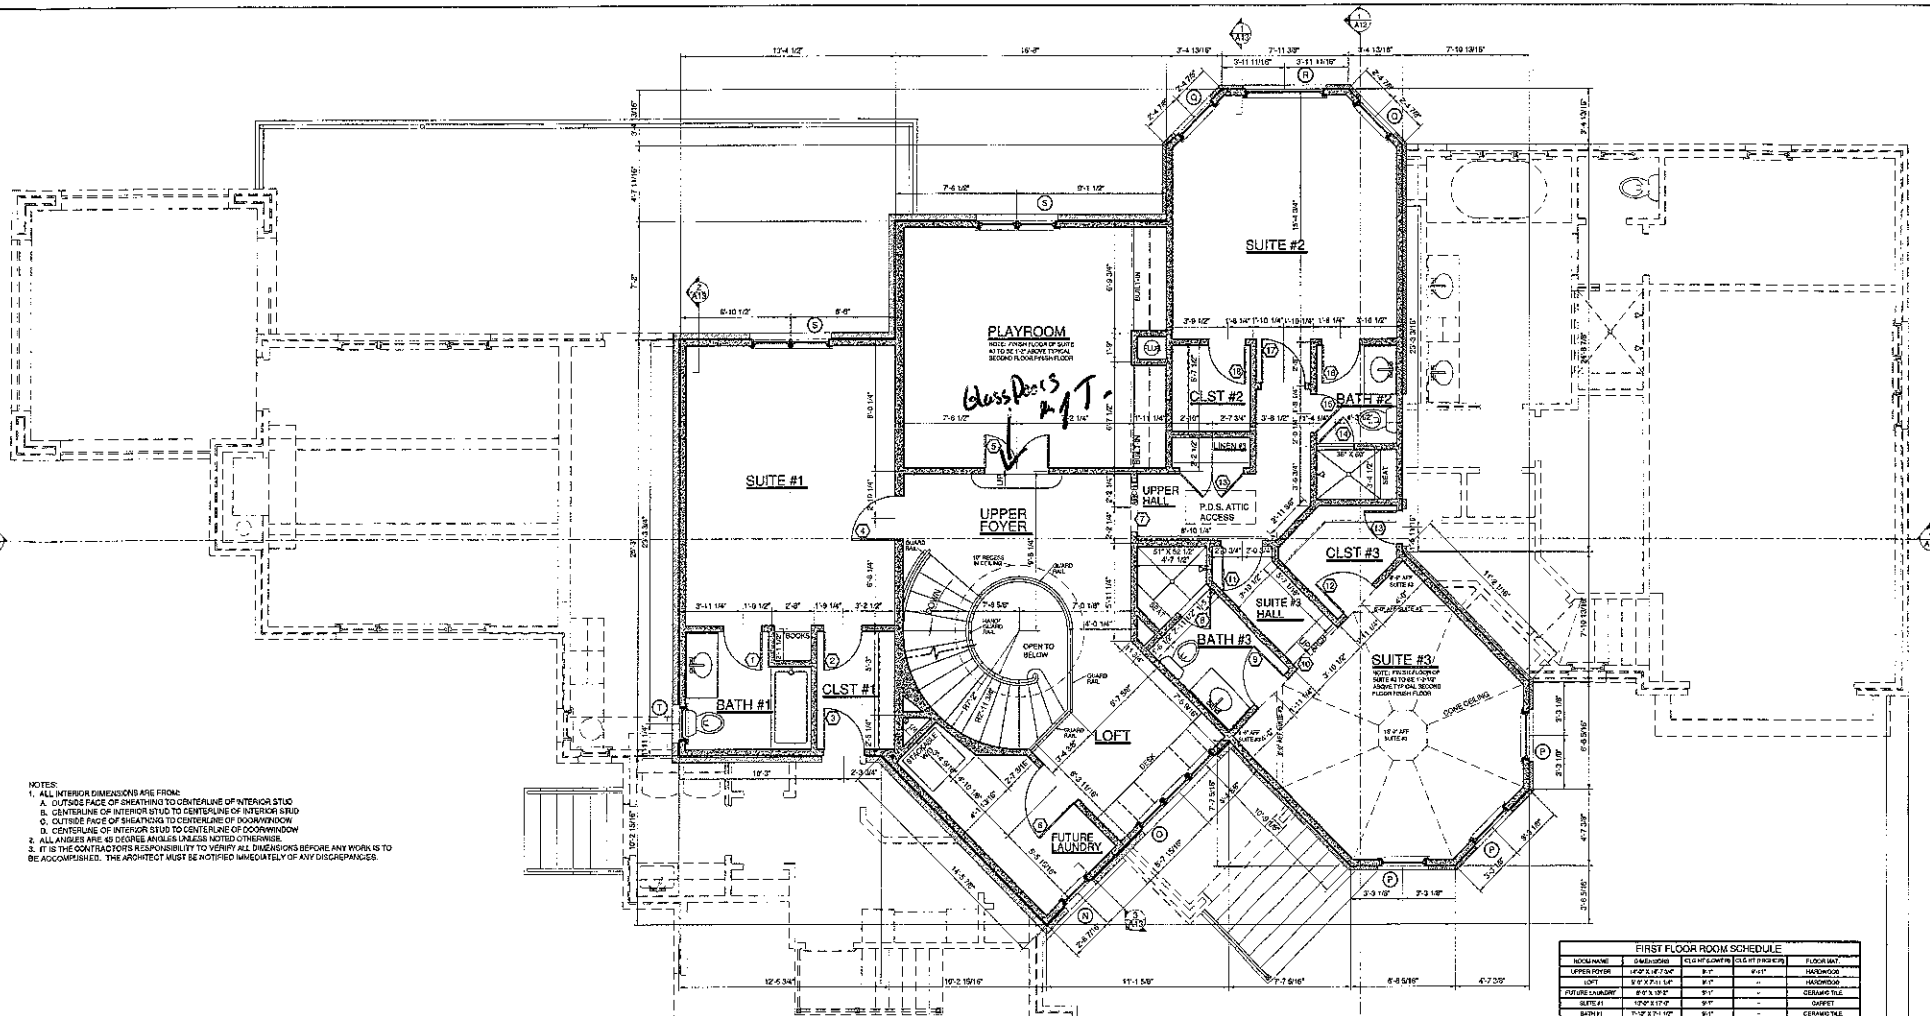

NOTES:
1. ALL INTERIOR DIMENSIONS ARE FROM:
   A. OUTSIDE FACE OF SHEATHING TO CENTERLINE OF INTERIOR STUD
   B. CENTERLINE OF INTERIOR STUD TO CENTERLINE OF INTERIOR STUD
   C. OUTSIDE FACE OF SHEATHING TO CENTERLINE OF DOOR/WINDOW
   D. CENTERLINE OF INTERIOR STUD TO CENTERLINE OF DOOR/WINDOW
2. ALL ANGLES ARE 45 DEGREE ANGLES UNLESS NOTED OTHERWISE.
3. IT IS THE CONTRACTOR'S RESPONSIBILITY TO VERIFY ALL DIMENSIONS BEFORE ANY WORK IS TO BE ACCOMPLISHED. THE ARCHITECT MUST BE NOTIFIED IMMEDIATELY OF ANY DISCREPANCIES.

WINDOW SCHEDULE NOTE: WINDOW MANUFACTURER TO PELLA PROLINE SERIES ALUMINUM CLAD U.N.O.

	QTY	WINDOW SIZE	HEAD HEIGHT	DESCRIPTION
A	2	1566x6080/96	11'-1 1/4" GARAGE	ARCHITECT SERIES, CASEMENT, TRIPLE (LEFT, FIXED, RIGHT), ILT GRILLE, ZERO MULL
B	1	7068	7'-3 1/2" FIRST	SPECIAL ARCHITECT SERIES, CASEMENT, ARCHED HEAD, SINGLE, ILT CUSTOM GRILLE
C	7	3671	9'-10 1/2" FIRST	ARCHITECT SERIES, CASEMENT, SINGLE, ILT GRILLE
D	1	2641	10'-2" FIRST	ARCHITECT SERIES, CASEMENT, SINGLE, ILT GRILLE
E	1	2663	7'-0" FIRST	CASEMENT, SINGLE
F	1	3341	7'-0" FIRST	CASEMENT, SINGLE
G	3	3347/3347/3347	7'-0" FIRST	CASEMENT, TRIPLE (LEFT, FIXED, RIGHT), ZERO MULL
H	2	3671	9'-0" FIRST	CASEMENT, S NALE
I	1	2671	9'-0" FIRST	CASEMENT, FIXED, SINGLE
J	1	2671/3451/2671 OVER 2971/4271/2971	9'-0" FIRST	ARCHITECT SERIES, CASEMENT, TRIPLE (LEFT, FIXED, RIGHT) WITH ARCHITECT SERIES CASEMENT TRIPLE (LEFT, FIXED, RIGHT) ARCHED HEAD TRANSOM, ZERO MULL
K	3	2971/4271/2971	9'-0" FIRST	CASEMENT, TRIPLE (LEFT, FIXED, RIGHT), ZERO MULL
L	2	5139	9'-0" FIRST	ARCHITECT SERIES, CASEMENT, SINGLE, ILT GRILLE
M	1	2968	9'-0" GARAGE	ARCHITECT SERIES, CASEMENT, SINGLE, ILT GRILLE
N	1	2570 S	8'-0" SECOND	SPECIAL ARCHITECT SERIES, CASEMENT, ARCHED HEAD, SINGLE, ILT CUSTOM GRILLE
O	1	5535/5535/5535	9'-0" SECOND	ARCHITECT SERIES, CASEMENT, TRIPLE (LEFT, FIXED, RIGHT), ILT GRILLE, ZERO MULL
P	2	2363	9'-0" SECOND	ARCHITECT, CASEMENT, SINGLE, ILT GRILLE
Q	3	3656	9'-0" SECOND	CASEMENT, SINGLE
R	1	3656	9'-0" SECOND	CASEMENT, FIXED, SINGLE
S	2	3336/3656	9'-0" SECOND	CASEMENT, TWIN (LEFT, RIGHT)
T	1	3656	9'-0" SECOND	ARCHITECT SERIES, CASEMENT, SINGLE, ILT GRILLE
U	1	7656/3660	9'-0" LOWER	CASEMENT, TWIN (LEFT, RIGHT)
V	1	3371/3671	6'-0" LOWER	CASEMENT, TWIN (LEFT, RIGHT)
W	1	3671	6'-0" LOWER	CASEMENT, SINGLE
X	1	2971	6'-0" LOWER	CASEMENT, FIXED, SINGLE
Y	2	2671	7'-0" LOWER	CASEMENT, SINGLE
Z	1	4854	6'-0" LOWER	SIDELITE SERIES, SLIDING CENT, FIXED, SINGLE
AA	1	7656/3660	9'-0" LOWER	CASEMENT, TWIN (LEFT, RIGHT)
BB	1	2541	10'-6 3/4" SECOND	ARCHITECT SERIES, CASEMENT, FIXED, ILT GRILLE
CC	1	3144.5	7'-1" ARCHED	ARCHITECT SERIES, CASEMENT, FIXED, ARCH HEAD

FIRST FLOOR ROOM SCHEDULE

ROOM NAME	DIMENSIONS	CLG HT (UNFIN)	CLG HT (FINISHED)	FLOOR MAT.
UPPER FOYER	14'-0" X 14'-7 3/4"	9'-1"	9'-1"	HARDWOOD
LOFT	9'-9" X 7'-11 1/4"	9'-1"	--	HARDWOOD
FUTURE LAUNDRY	8'-9" X 13'-5"	9'-1"	--	CERAMIC TILE
SUITE #1	17'-0" X 17'-0"	9'-1"	--	CARPET
BATH #1	7'-10" X 7'-1 1/2"	9'-1"	--	CERAMIC TILE
CLST #1	6'-1 1/2" X 7'-1 1/2"	9'-1"	--	CARPET
PLAYROOM	18'-1 1/2" X 14'-1 1/2"	8'-1"	--	CARPET
UPPER HALL	10'-4" X 6'-0"	9'-1"	--	HARDWOOD
SUITE #3 HALL	5'-8" X 9'-0 3/8"	9'-1"	10'-0"	CARPET
SUITE #3	12'-9" X 15'-9"	9'-1"	10'-0"	CARPET
BATH #3	5'-4 1/2" X 11'-11 3/8"	9'-1"	--	CERAMIC TILE
CLST #3	7'-5 3/8" X 5'-4 1/4"	9'-1"	--	CARPET
LINEN #3	6'-11" X 1'-6 1/2"	9'-1"	--	HARDWOOD
BATH #2	14'-8" X 11'-10"	9'-1"	--	CARPET
SUITE #2	17'-0" X 17'-0"	9'-1"	--	CERAMIC TILE
CLST #2	6'-1 1/2" X 3'-7 3/4"	9'-1"	--	CARPET

ALL CEILING HEIGHTS ARE TO BE MEASURED FROM FINISH FLOOR OF INDICATED ROOM

SECOND FLOOR DOOR SCHEDULE

	DOOR SIZE	DESCRIPTION
1	1'-0" X 6'-8"	SOLID CORE
2	1'-0" X 6'-8"	SOLID CORE
3	2'-0" X 6'-8"	SOLID CORE, WEATHERSTRIPPED
4	1'-0" X 6'-8"	SOLID CORE, 2HR WALL
5	2'-0" X 6'-8"	PAIR, SOLID CORE
6	2'-0" X 6'-8"	SOLID CORE
7	1'-0" X 8'-0"	ARCHED OPENING
8	1'-0" X 6'-8"	GLASS, TEMPERED, SWING, SHOWER
9	1'-0" X 6'-8"	SOLID CORE
10	1'-0" X 6'-8"	ARCHED OPENING
11	1'-0" X 6'-8"	SOLID CORE
12	1'-0" X 6'-8"	SOLID CORE
13	2'-0" X 6'-8"	PAIR, SOLID CORE
14	1'-0" X 6'-8"	GLASS, TEMPERED, SWING, SHOWER
15	1'-0" X 6'-8"	SOLID CORE
16	1'-0" X 6'-8"	SOLID CORE
17	1'-0" X 6'-8"	SOLID CORE
18	1'-0" X 6'-8"	SOLID CORE

NOTE: ALL EXTERIOR PATIO DOORS TO BE PELLA ARCHITECT SERIES ALUMINUM CLAD DOORS WITH LOW E ARGON GLASS. ALL HALF LITE DOORS TO BE PELLA ENTRY SYSTEMS FIBERGLASS DOORS WITH ALUMINUM CLAD FRAME AND LOW E ADVANCED ARGON GLASS. ALL INTERIOR DOOR TO BE A PELLA ENTRY SYSTEMS FIBERGLASS DOOR WITH ALUMINUM CLAD FRAME. ALL INTERIOR DOOR STYLE TO BE SELECTED BY OWNER (FLUSH, PANELED, ETC.)

Approved as Noted
Subject to Compliance with Comments
Permit ONLY!
Date 10/16/12
Date
10-16-12

1 / A4 SECOND FLOOR PLAN
1/4" = 1'-0"

PROJECT NAME AND ADDRESS

DRAWING TITLE