0 $130

IREDELL COUNTY HEALTH DEPARTMENT

STATESVILLE 704-878-5305 MOORESVILLE 704-664-5281

IMPROVEMENT PERMIT / AUTHORIZATION TO CONSTRUCT / OPERATION PERMIT / EXISTING SYSTEM INSPECTION

PERMIT# 119534 PIN# 4625-83-4957.1301 4625-71-6891 DATE June 21, 04

OWNER OR CONTRACTOR Crescent Resources Inc // The Point on Norman / Hughes & Assoc PHONE: Business _____ Home _____

ADDRESS 2214 Brawley Sch Rd, Mooresville, N.C. 28117

LOCATION Brawley Sch Rd to RW Yacht Rd. ~500' on Right

SUBDIVISION The Point BLOCK / SECTION 13 LOT 1301 LOT AREA .830 Ac ± .487 ac SFE SITE CLASS. PS SFE DESIGN FLOW 480 gpd L.T.A.R. .3 SFE 130

Septic Tank: 1000+ Gallons; STB 4444 Date 4-18-06
Pump Tank: 1000 Gallons; PT 283 Date 5-29-06
Pump Make: Myers Model ME50 Serial No. _____
Nitrification Field: No Fields 1 Square Feet 1200 Linear Feet 400
No Lines 5 @ 80' Trench Width 36" Max Trench Bottom Depth 36" Gravel Depth NA

☑ New System ☐ Repair System Type: I, II, III, IV, V, VI
System Description: plus 25% Reduction on SFE 1308-1301A
Repair System Description: LPPPBPS on SFE 1308-1301A
Maintenance Agreement Required: ☐ Yes ☑ No

☑ House/Mod. Home No. Bedrooms 4
☐ Mobile Home No. Bathrooms 4
☐ Business No. Employees _____
☐ Other _____


☐ Slab ☑ Crawl Space ☐ Basement w/plumbing ☐ Basement wo/plumbing

Water Supply: ☐ Individual ☑ Public ☑ Community


Comments:/Conditions: "Shave off" old berms in septic system AREA.

Comments:/Conditions: Reviewed Building plans & Floor plans, essentially in Compliance with I.P.

INITIAL SITE SKETCH

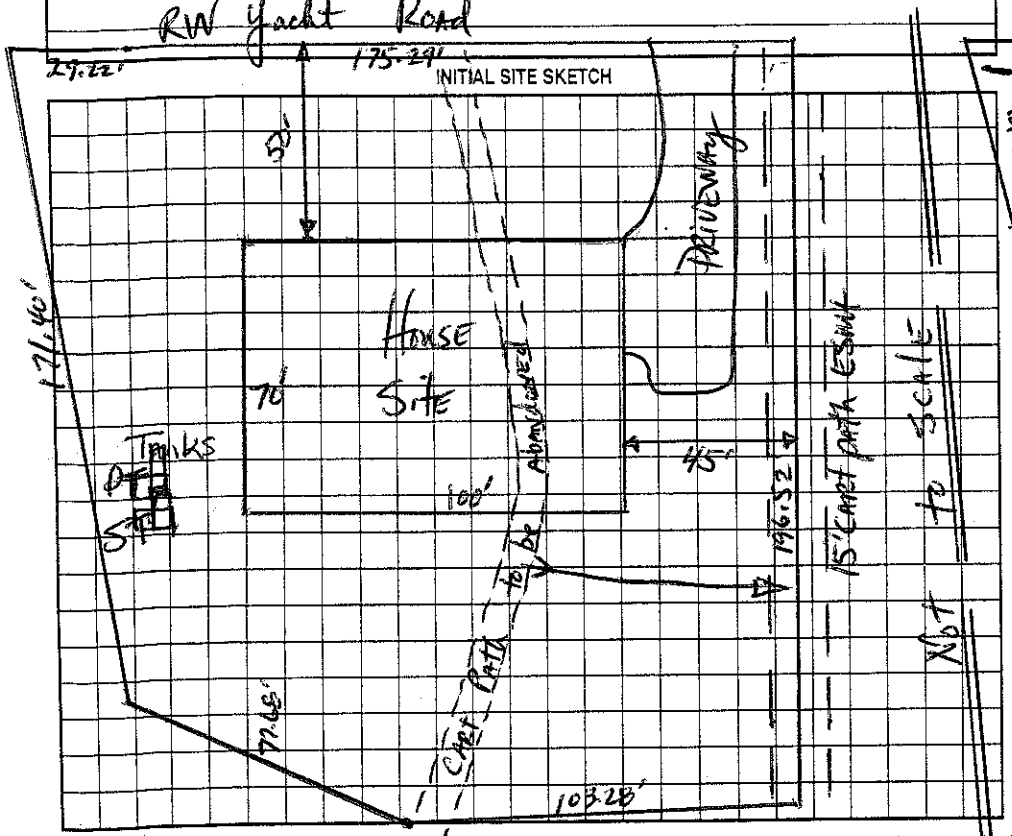

AS BUILT SKETCH

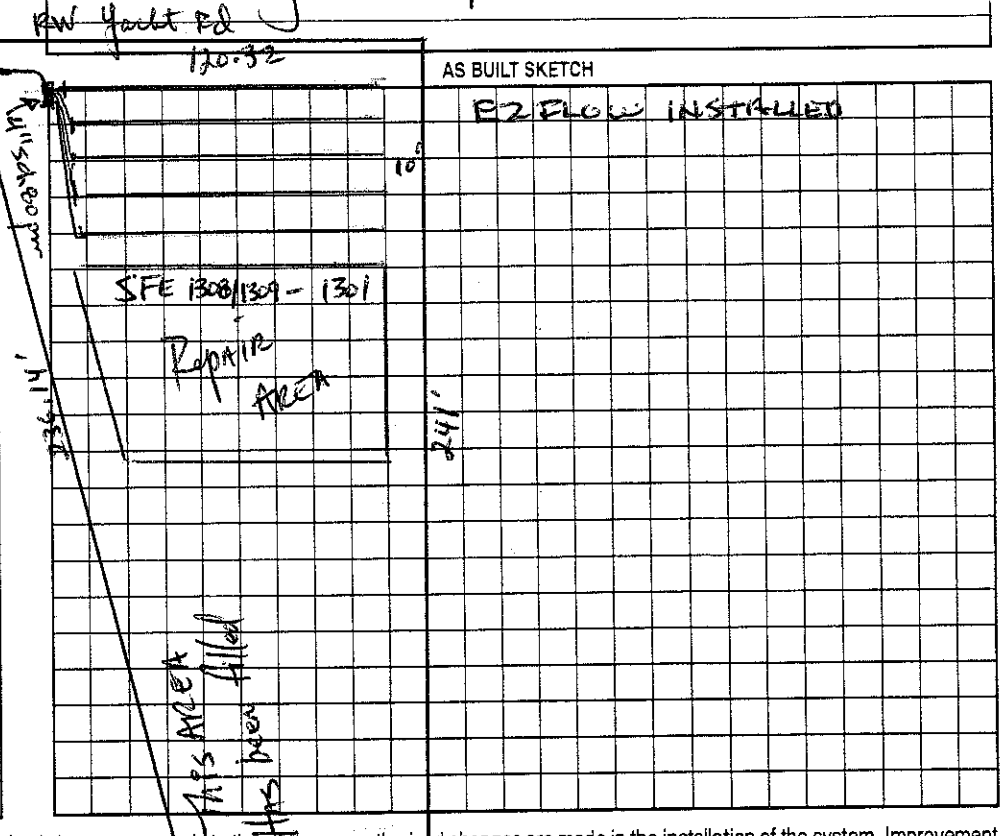

Permit can be suspended or revoked if any false information is supplied toward securing the permit/any unauthorized changes are made to the site/any unauthorized changes are made in the installation of the system. Improvement Permit with plat valid without expiration. Improvement Permit with site plan valid for sixty months. Authorization to Construct is valid for a period equal to that of Improvement Permit – not to exceed sixty months.

Signed: _____ date 6-22-04 Installed by: R + H Wesley Sparkes date 8/17/06

Improvement Permit by: _____ date 6-21-04 Operation Permit by: _____

Authorization to Construct by: _____ date 12/5/05 Existing System Inspection by: _____ date _____

HEALTH DEPT. COPY: WHITE OWNER COPY (FINAL): YELLOW OWNER COPY (INITIAL): PINK