IREDELL COUNTY HEALTH DEPARTMENT

STATESVILLE 704-878-5305 MOORESVILLE 704-664-5281

IMPROVEMENT PERMIT / AUTHORIZATION TO CONSTRUCT / OPERATION PERMIT / EXISTING SYSTEM INSPECTION

$375

PERMIT# 114559 PIN# ~~4625-83-4957~~ 4625-71-8437 DATE April 21, 04

OWNER OR CONTRACTOR Crescent Resources c/o Jeff The Hunt on Norman / LAKE NORMAN ~~SPECULATIVE~~ Business Home

ADDRESS 2214 Brawley Sch Rd, Mooresville, NC 28117

LOCATION Brawley Sch Rd TL Yacht Rd TR Kent Ct. Attend on Right

SUBDIVISION The Point BLOCK / SECTION 13 LOT 1304 LOT AREA 1.103Ac SITE CLASS PS DESIGN FLOW 480gpd L.T.A.R. .25 (Initial Septem & Repair Area)

Septic Tank: ~~1000~~ 1500 Gallons; STB 444 Date 6/11/07

Pump Tank: ~~1000~~ 1500 Gallons; PT 477 Date 6/12/07

Pump Make Goulds Model WE07I2HV Serial No E0795798

Nitrification Field: No Fields 1 Square Feet 640/960 Linear Feet 320

No Lines 4@80' Trench Width 24" Min 80c Max Trench Bottom Depth 36" Gravel Depth N/A

☑ New System ☐ Repair System Type: I, II, III, ⊙ V, VI

System Description: LPPPBPS

Repair System Description: LPPPBPS

Maintenance Agreement Required: ☑ Yes ☐ No

☑ House/Mod. Home ☐ Mobile Home ☐ Business ☐ Other

No. Bedrooms 4 No. Bathrooms 4 No. Employees

☐ Slab ☐ Crawl Space ☑ Basement w/plumbing ☐ Basement wo/plumbing


Water Supply: ☐ Individual ☑ ~~Public~~ ☑ Community

Comments:/Conditions: OR 36" max 9"oc "Shave Off" All old burns/Hornets


Comments:/Conditions: Polylok filter installed. Tanks, lines & pressure Checked by A.C.

1" = 50'

INITIAL SITE SKETCH

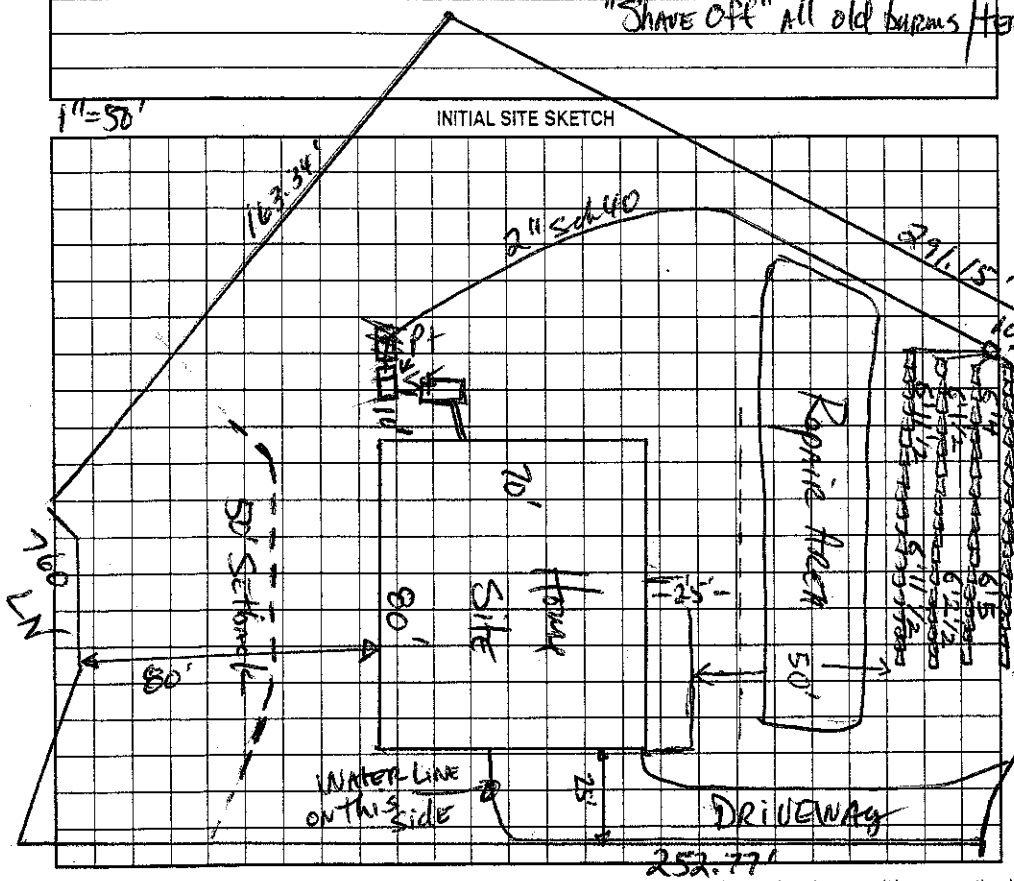

AS BUILT SKETCH

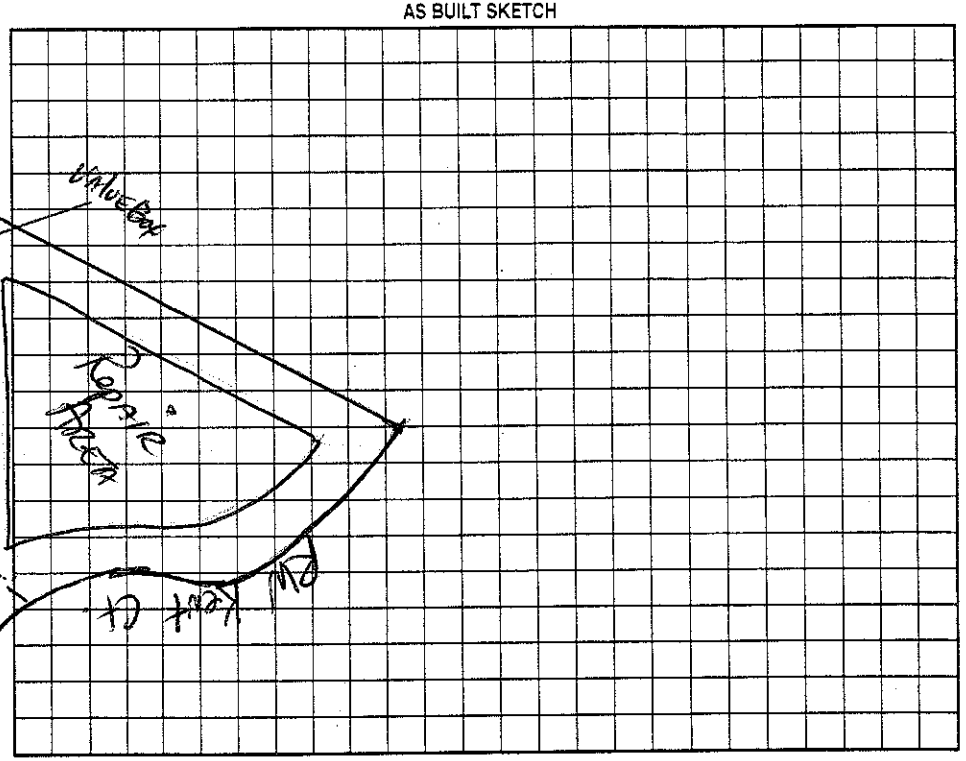

Permit can be suspended or revoked if any false information is supplied toward securing the permit/any unauthorized changes are made to the site/any unauthorized changes are made in the installation of the system. Improvement Permit with plat valid without expiration. Improvement Permit with site plan valid for sixty months. Authorization to Construct is valid for a period equal to that of Improvement Permit – not to exceed sixty months.

Signed: _____ date 6-22-06 Installed by: Kevin Holman

Improvement Permit by: _____ date 4-21-04 Operation Permit by: Wesley Sparks R.S. date 9/7/07

Authorization to Construct by: _____ date 11-17-06 Existing System Inspection by: _____ date _____

HEALTH DEPT. COPY: WHITE OWNER COPY (FINAL): YELLOW OWNER COPY (INITIAL): PINK