IREDELL COUNTY HEALTH DEPARTMENT

STATESVILLE 704-878-5305 MOORESVILLE 704-664-5281

IMPROVEMENT PERMIT / AUTHORIZATION TO CONSTRUCT / OPERATION PERMIT / EXISTING SYSTEM INSPECTION

PERMIT# 130381 PIN# 4625 72 4370 .000 4625-72-4370 DATE 6/21/06

OWNER OR APPLICANT Kenneth Beaty Homes PHONE: Business 704-662-6400 Home

ADDRESS PO Box 3398 Mooresville, NC. 28117

LOCATION 1100 on (L) just before Yacht Rd

SUBDIVISION Point BLOCK / SECTION 13 LOT 13&8 LOT AREA .815 AC SITE CLASS. PS DESIGN FLOW 480 L.T.A.R. .3

Septic Tank: 1500 Gallons; STB 338 Date 12-3-06
Pump Tank: 1000 Gallons; PT 37 Date 1-6-07
Pump Make: Gouds Model WE0312M Serial No.
Nitrification Field: No Fields 1 Square Feet 46/960 Linear Feet 320
No Lines 3 CF Trench Width 2' Max Trench Bottom Depth 3'

[X] New System [ ] Repair [ ] Expansion System Type: I II III (IV) V VI
System Description: LP PPBPS
Repair System Description: LP PPBPS
Maintenance Agreement Required: [X] Yes [ ] No

[X] House/Mod. Home No. Bedrooms 4
[ ] Mobile Home No. Persons
[ ] Business No. Employees
[ ] Other


Water Supply: [ ] Individual [ ] Public [ ] Community

Gravel Depth N/A [ ] Gravity [X] Pressure [ ] Slab [X] Crawl Space [ ] Basement w/plumbing [ ] Basement wo/plumbing


Comments:/Conditions: Initial site evaluation and layout performed by S+ME.
See Easement Letter for Lines in Landscape Easement Area

Comments:/Conditions Checked tanks & lines 2/20/07

INITIAL SITE SKETCH

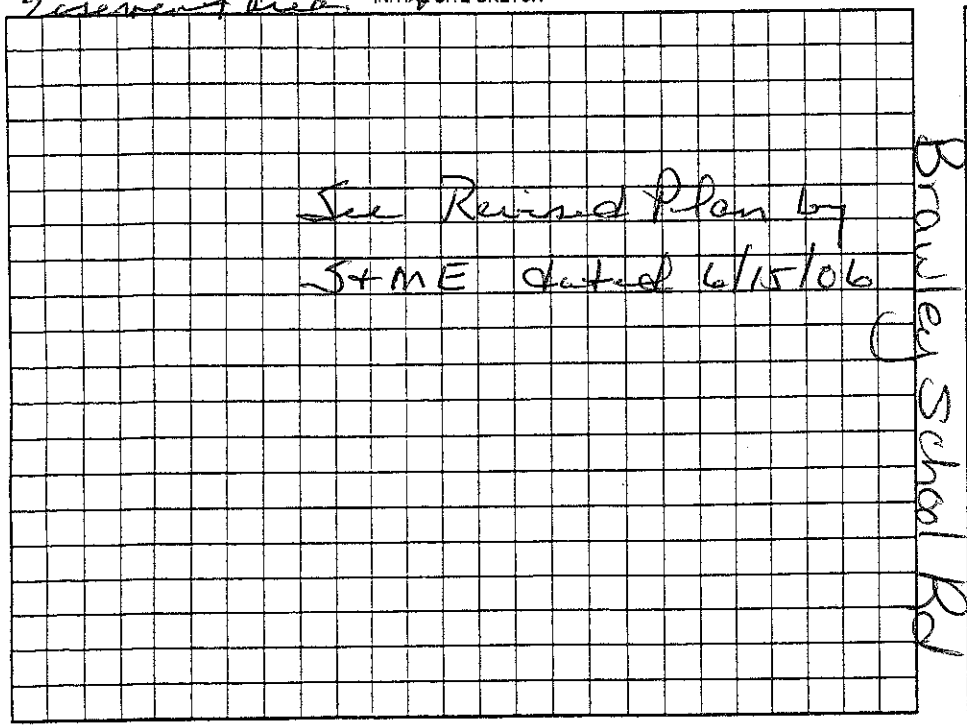

AS BUILT SKETCH

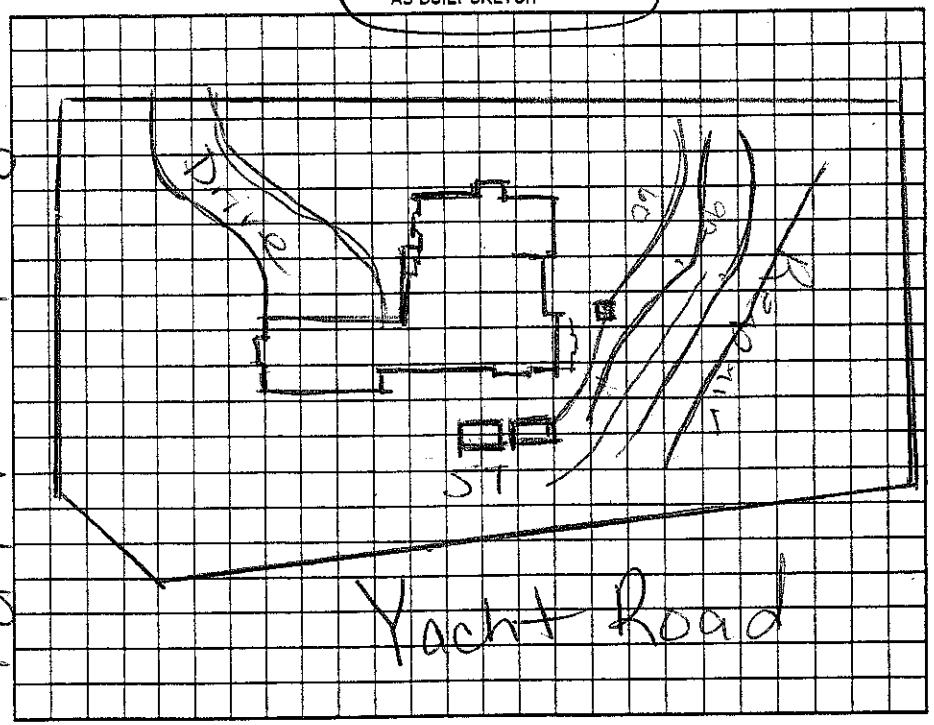

Permit can be suspended or revoked if any false information is supplied toward securing the permit/any unauthorized changes are made to the site/any unauthorized changes are made in the installation of the system. Improvement Permit with plat valid without expiration ☐ Improvement Permit with site plan valid for sixty months ☐ Authorization to Construct is valid for a period equal to that of Improvement Permit – not to exceed sixty months.

Signed: Emily Beach date 6/26/06 Installed by: R & H R.S.

Improvement Permit by: Wesley Sparks RS date 6/21/06 Operation Permit by: Mark Hilton date 4/5/07

Authorization to Construct by: Wesley Sparks RS. date 6/26/06 Existing System Inspection by: date

HEALTH DEPT. COPY: WHITE OWNER COPY (FINAL): YELLOW OWNER COPY (INITIAL): PINK