IREDELL COUNTY HEALTH DEPARTMENT

STATESVILLE 704-878-5305 50.00 Paid MOORESVILLE 704-664-5281

IMPROVEMENT PERMIT / AUTHORIZATION TO CONSTRUCT / OPERATION PERMIT / EXISTING SYSTEM INSPECTION

PERMIT# 40758 PIN# 4625 94 1684 PT 4625-73-0986 DATE 2/18/02

OWNER OR CONTRACTOR John R. Poore Builders PHONE: Business 704-847-0496 Home

ADDRESS 1059 D Independence Point Parkway Suite 100 Matthews NC 28105

LOCATION Brawley Sch / TR Stonewall Beach on Lt

SUBDIVISION Point BLOCK / SECTION 6 LOT 62 LOT AREA 37 493 Ft² SITE CLASS. PS DESIGN FLOW 480 L.T.A.R. 0.25

Septic Tank: 1000 Gallons: STB 338 Date 12/13/02

Pump Tank: 1000 Gallons: PT 283 Date 1/11/03

Pump Make: Model Serial No.

Nitrification Field: No Fields 1 Square Feet 1500 Linear Feet 500

No Lines 5 @ 100' Trench Width 36" Max Trench Bottom Depth 36" Gravel Depth —

☒ New System ☐ Repair System Type: I, II, III, IV, V, VI

System Description: Pump 25% Reduction

Repair System Description: Same

Maintenance Agreement Required: ☐ Yes ☒ No

☒ House/Mod. Home ☐ Mobile Home ☐ Business ☐ Other

No. Bedrooms 4 No. Bathrooms 4 No. Employees


☐ Slab ☒ Crawl Space ☐ Basement w/plumbing ☐ Basement wo/plumbing

Water Supply: ☐ Individual ☐ Public ☒ Community


Comments/Conditions: Remove Terraces + Berms

Comments/Conditions: Tanks Checked & lines Checked 3/5/03-MD

INITIAL SITE SKETCH 1" = 50'

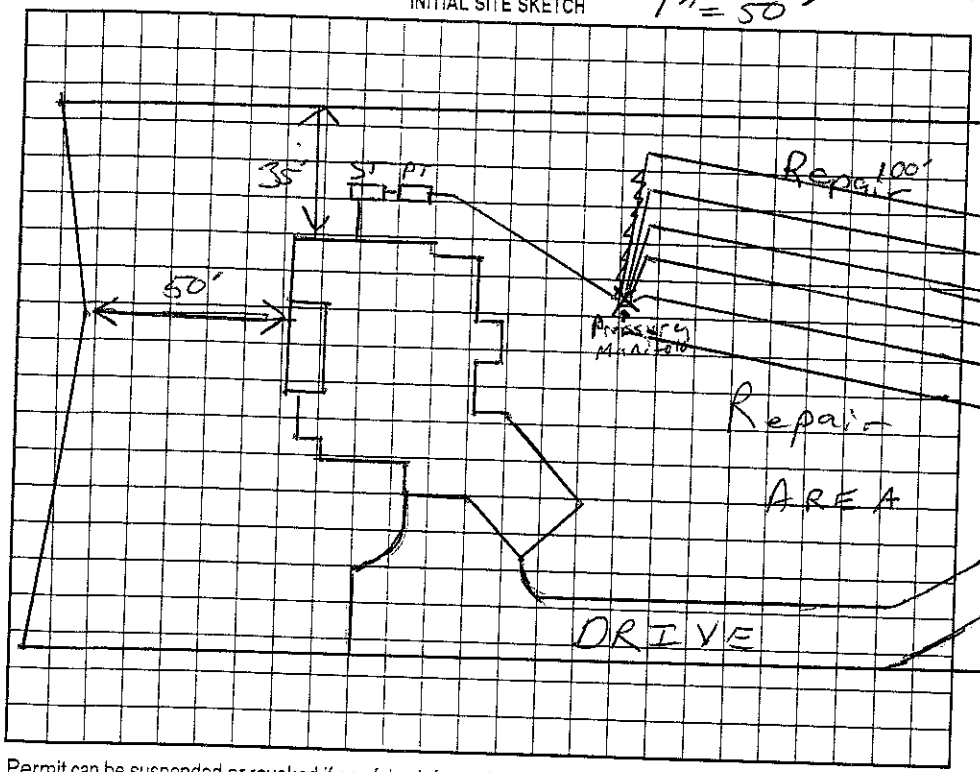

AS BUILT SKETCH

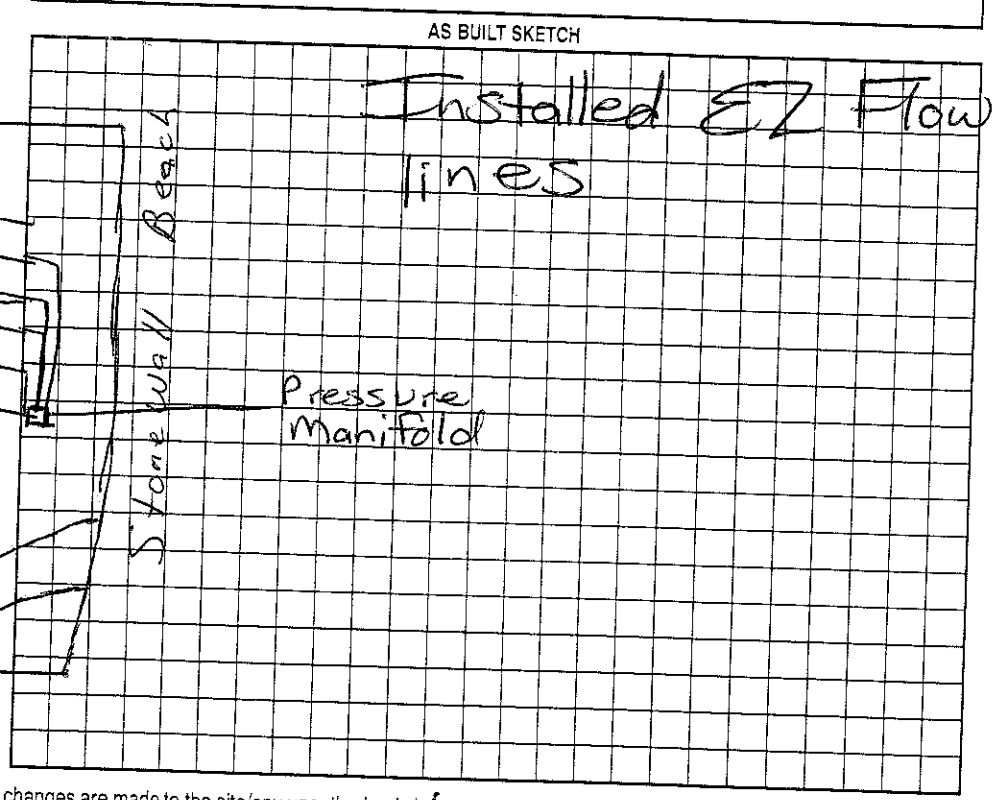

Permit can be suspended or revoked if any false information is supplied toward securing the permit/any unauthorized changes are made to the site/any unauthorized changes are made in the installation of the system. Improvement Permit with plat valid without expiration. Improvement Permit with site plan valid for sixty months. Authorization to Construct is valid for a period equal to that of Improvement Permit not to exceed sixty months.

Signed: date 2-19-02

Improvement Permit by: RS date 2/18/02

Authorization to Construct by: RS date 2/18/02

Installed by: R & T Inc

Operation Permit by: Marion H Dotson RS date 3/17/2003

Existing System Inspection by: date

HEALTH DEPT. COPY: WHITE OWNER COPY (FINAL): YELLOW OWNER COPY (INITIAL): PINK