Site Address: 128 Attlebors Place - Norvel. $125 11/00

IREDELL COUNTY HEALTH DEPARTMENT

STATESVILLE 704-878-5305 MOORESVILLE 704-664-5281

IMPROVEMENT PERMIT / AUTHORIZATION TO CONSTRUCT / OPERATION PERMIT / EXISTING SYSTEM INSPECTION

PERMIT# 094922 PIN# 4625941684 (Lot) 4625-62-1004 DATE June 5, 01

OWNER OR CONTRACTOR Crescent Resources Dev. Arcadia Homes PHONE: Business 4625731004 Home

ADDRESS P.O. Box 1003 Charlotte N.C. 28201

LOCATION Brawley School Road TR Attleboro 2nd lot on Right

SUBDIVISION The Point on Norman LOT 705/705A LOT AREA 33170 + 30,400 Ft² ± SITE CLASS. PS SPE DESIGN FLOW 480 gpd L.T.A.R. .225 - .25

Septic Tank: 1000 + Gallons; STB 338 Date 8-26-03

Pump Tank: 1000 Gallons; PT 27 Date 8-29-03

Pump Make: Model Serial No.

Nitrification Field: No Fields 1 Square Feet 1560 Linear Feet 520

No Lines 4 @ 130' Trench Width 36" Trench Bottom Depth 36"+ Gravel Depth N/A

☑ New System ☐ Repair System Type: I, II, III, IV, V, VI

System Description: Pan Innovative - 25% Red.

Repair System Description: LP Innovative

Maintenance Agreement Required: ☐ Yes ☑ No initially

☑ House/Mod. Home ☐ Mobile Home ☐ Business ☐ Other

No. Bedrooms 4/4 No. Bathrooms 4/4 No. Employees


☐ Slab ☐ Crawl Space ☑ Basement w/plumbing ☐ Basement wo/plumbing

Water Supply: ☐ Individual ☑ Public ☑ Community

Comments:/Conditions: Install Laterals No Shallower Than 36" trench bottom.

Comments:/Conditions: Reviewed plans 12/12/02, in compliance with permit. Checked tanks & lines 10/1/03 MD

INITIAL SITE SKETCH

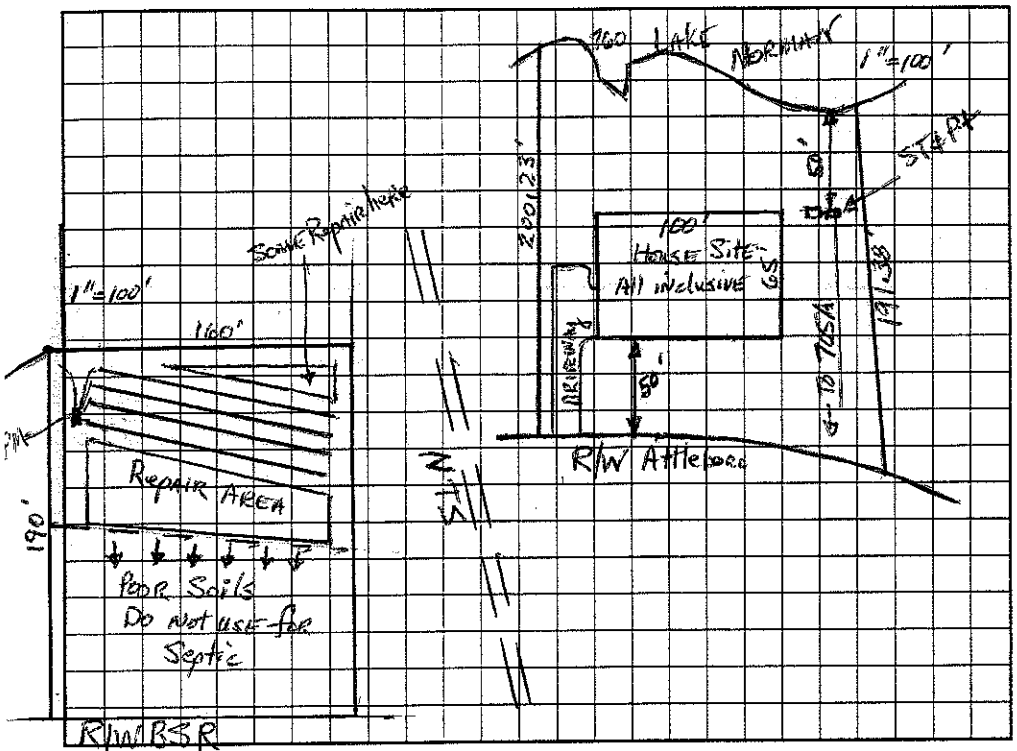

AS BUILT SKETCH

Installed EZ Flow Drainfield as Drawn

Permit can be suspended or revoked if any false information is supplied toward securing the permit/any unauthorized changes are made to the site/any unauthorized changes are made in the installation of the system. Improvement Permit with plat valid without expiration. Improvement Permit with site plan valid for sixty months. Authorization to Construct is valid for a period equal to that of Improvement Permit – not to exceed sixty months.

Signed: date 6-15-01 Installed by: R & H Inc

Improvement Permit by: date 6-5-01 Operation Permit by: date 10/16/03

Authorization to Construct by: date 12/12/02 Existing System Inspection by: date

HEALTH DEPT. COPY: WHITE OWNER COPY (FINAL): YELLOW OWNER COPY (INITIAL): PINK