IREDELL COUNTY HEALTH DEPARTMENT

STATESVILLE 704-878-5305 MOORESVILLE 704-664-5281

3:30.

IMPROVEMENT PERMIT / AUTHORIZATION TO CONSTRUCT / OPERATION PERMIT / EXISTING SYSTEM INSPECTION

PERMIT# 90757 PIN# ~~4627594 1684 PT~~ 4625 73 1729 DATE 10/19/00

OWNER OR CONTRACTOR CRESCENT RESOURCES / Poore Builder PHONE: Business 663-6905 Home

ADDRESS PO BOX 1003 CHARLOTTE NC 28201 209 Stonewall Bch

LOCATION BRAWLEY SCHOOL - TR STONEWALL BEACH - AT END OF LT

SUBDIVISION POINT BLOCK / SECTION 6 LOT 626 LOT AREA 43555 M^2 SITE CLASS. RS DESIGN FLOW 480 GPD L.T.A.R. .25 gal/ft^2

Septic Tank: 1000 T Gallons: STB 338 Date 7-20-03

Pump Tank: Gallons: PT Date

Pump Make: Model Serial No.

Nitrification Field: No Fields 1 Square Feet 1500 Linear Feet 500

No Lines 4@125' Trench Width 36" Max Trench Bottom Depth 36" Gravel Depth N/A

☑ New System ☐ Repair System Type: I, II, III, IV, V, VI

System Description: GRAVITY 25% REDUCTION

Repair System Description: ~~CRADLE~~ LPP&NGL

Maintenance Agreement Required: ☐ Yes ☑ No

☑ House/Mod. Home No. Bedrooms 4

☐ Mobile Home No. Bathrooms 4

☐ Business No. Employees

☐ Other


☐ Slab ☑ Crawl Space ☐ Basement w/plumbing ☐ Basement wo/plumbing

Water Supply: ☐ Individual ☐ Public ☑ Community


Comments:/Conditions: REMOVE TERRACES AND BERMS

Comments:/Conditions: ~~Crooked~~ tanks & 3 lines 8/25/03 Checked 4th line 9/2/03 * Drive well move to opposite side

INITIAL SITE SKETCH

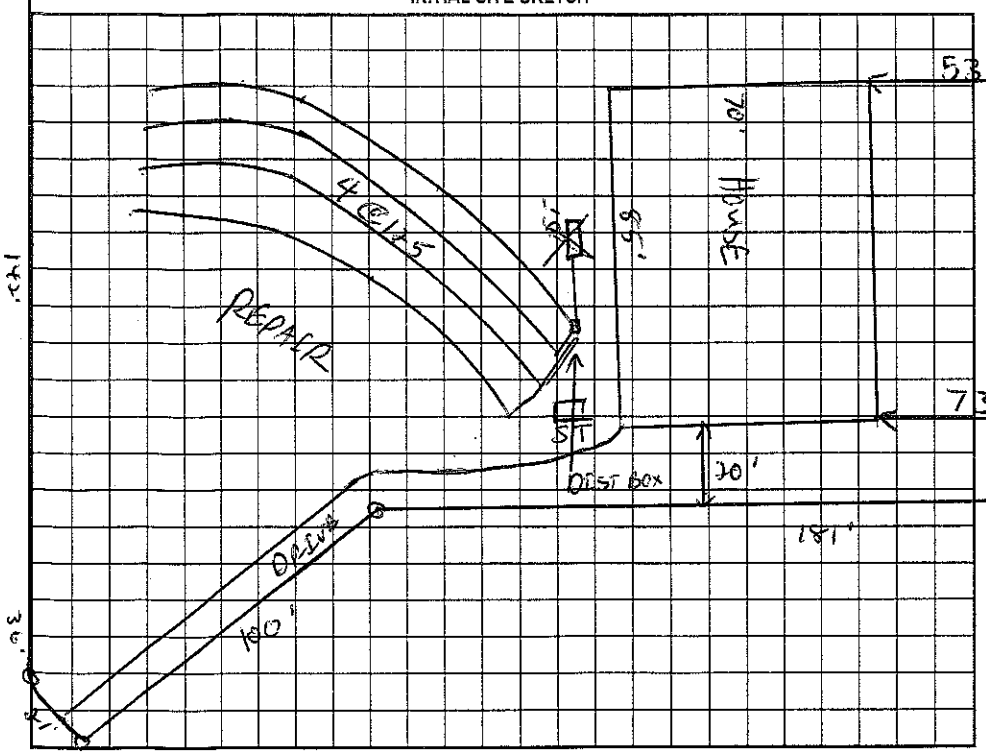

AS BUILT SKETCH

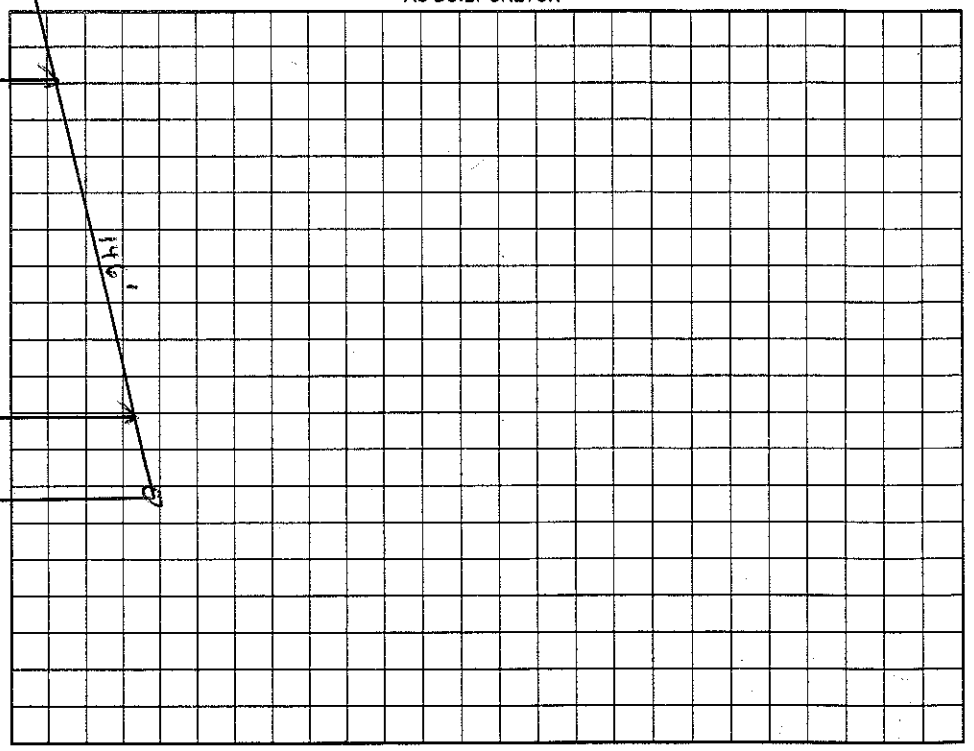

Permit can be suspended or revoked if any false information is supplied toward securing the permit/any unauthorized changes are made to the site/any unauthorized changes are made in the installation of the system. Improvement Permit with plat valid without expiration. Improvement Permit with site plan valid for sixty months. Authorization to Construct is valid for a period equal to that of Improvement Permit – not to exceed sixty months.

Signed: [signature] (Agent) date 10/25/00

Improvement Permit by: [signature] RS date 10/26/00

Authorization to Construct by: [signature] RS date 11/18/00

Installed by: R&H RS

Operation Permit by: [signature] date 9/4/03

Existing System Inspection by: date

HEALTH DEPT. COPY: WHITE OWNER COPY (FINAL): YELLOW OWNER COPY (INITIAL): PINK