$325 11:00

IREDELL COUNTY HEALTH DEPARTMENT

STATESVILLE 704-878-5305 MOORESVILLE 704-664-5281

IMPROVEMENT PERMIT / AUTHORIZATION TO CONSTRUCT / OPERATION PERMIT / EXISTING SYSTEM INSPECTION

PERMIT# 094920 PIN# ~~4625~~ 94 1684 (pt) 4625-73-2299 DATE June 13, 01

OWNER OR CONTRACTOR Crescent Resources Dev. / Dienst Custom Homes PHONE: Business _____ Home _____

ADDRESS P.O. Box 1003 Charlotte NC 28201

LOCATION Bowles Sch RD. TR Attleboro TR Marbury on left

SUBDIVISION The Point BLOCK / SECTION 7 LOT 702/702A LOT AREA 30587 + 18794 ft² SITE CLASS. PSSFE DESIGN FLOW 480 gpd L.T.A.R. .3

Septic Tank: 1000 Gallons; STB ~~238~~ 338 Date 9-17-02

Pump Tank: 1000 Gallons; PT ~~283~~ 338 Date 9-11-02

Pump Make: _____ Model _____ Serial No. _____

Nitrification Field: No Fields 1 Square Feet 520/840 Linear Feet 280+

No Lines 3-4 Trench Width 24" min 8'oc Max Trench Bottom Depth 36" Gravel Depth NA

☑ New System ☐ Repair System Type: I, II, III, IV, V, VI

System Description: LPPPBPS

Repair System Description: SAME

Maintenance Agreement Required: ☑ Yes ☐ No

☑ House/Mod. Home No. Bedrooms 4/4

☐ Mobile Home No. Bathrooms 4/4

☐ Business No. Employees _____

☐ Other _____

☐ Slab ☐ Crawl Space ☑ Basement w/plumbing ☐ Basement wo/plumbing

Water Supply: ☐ Individual ☑ Public ☐ Community

Comments:/Conditions: OR 36" MAX 9'oc

Comments:/Conditions:


Plans reviewed 3/13/02 GM

Checked lines, 6/26/2002

Tanks checked 11/4/02

Pres, Elect Alarm 11/18/2002

INITIAL SITE SKETCH

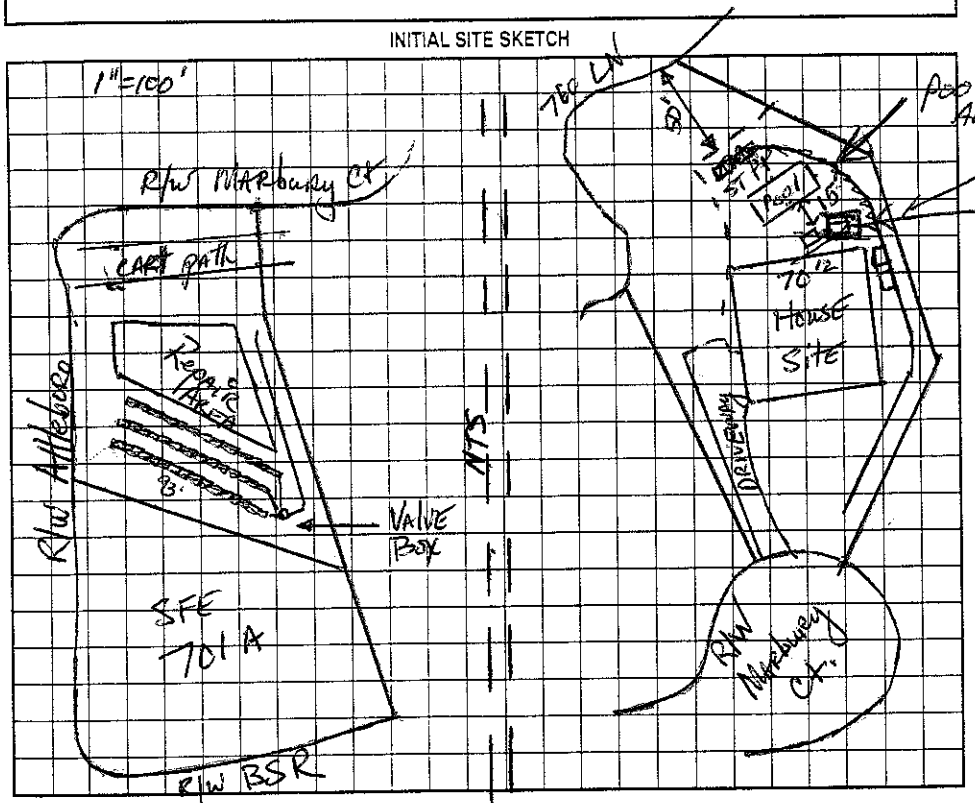

AS BUILT SKETCH

Pool Added

Tank Location changed

Outdoor Kitchen (No Plumbing)

The proposed / existing Outdoor Kitchen addition does not appear to impact the existing septic system.

**NOTE: Must be at least 5FT From Septic Tanks

Pump tank Maria H Dotson R.S.

Date: 3/13/2012

ICHD-Environmental Health Division

* Owner says No plumbing in Outdoor kitchen

Permit can be suspended or revoked if any false information is supplied toward securing the permit/any unauthorized changes are made to the site/any unauthorized changes are made in the installation of the system. Improvement Permit with plat valid without expiration. Improvement Permit with site plan valid for sixty months. Authorization to Construct is valid for a period equal to that of Improvement Permit – not to exceed sixty months.

Signed: _____ date 6-15-01 Installed by: R & H

Improvement Permit by: Mark Tenon, RS date 6-13-01 Operation Permit by: Maria H Dotson RS date 11/18/2002

Authorization to Construct by: _____ RS date 3/13/02 Existing System Inspection by: _____ date _____

HEALTH DEPT. COPY: WHITE OWNER COPY (FINAL): YELLOW OWNER COPY (INITIAL): PINK