IREDELL COUNTY HEALTH DEPARTMENT

STATESVILLE 704-878-5305 MOORESVILLE 704-664-5281

IMPROVEMENT PERMIT / AUTHORIZATION TO CONSTRUCT / OPERATION PERMIT / EXISTING SYSTEM INSPECTION

PERMIT# 14226 PIN# 4625732492 DATE 8-1-07

OWNER OR APPLICANT Kenneth Bealer Homes/JS Tisha PHONE: Business 704 746-4669 Home

ADDRESS P.O. Box 3398 Mooresville NC 28117

LOCATION Brawley School Rd TR Athlebord TR Marbury Ct

SUBDIVISION The Point BLOCK / SECTION 7 LOT 701/701A LOT AREA 65339+18560 SITE CLASS SEE RS DESIGN FLOW 600gpd L.T.A.R. .3

Septic Tank: 1500 Gallons; STB 338 Date 8-12-14

Pump Tank: 1500 Gallons; PT 477 Date 8-18-14

Pump Make: Orenco Model Serial No.

Nitrification Field: No Fields 1 Square Feet 1005' Linear Feet 335'

No Lines 6 Trench Width A See Note Max Trench Bottom Depth 36" Gravel Depth N/A ☐ Gravity ☒ Pressure

☒ New System ☐ Repair ☐ Expansion System Type: I II III IV V VI

System Description: LP PPBPS Same

Repair System Description:

Maintenance Agreement Required: ☒ Yes ☐ No

☒ House/Mod. Home No. Bedrooms 5

☐ Mobile Home No. Persons

☐ Business No. Employees


☐ Other

Water Supply: ☐ Individual ☒ Public ☒ Community

☐ Slab ☐ Crawl Space ☒ Basement w/plumbing ☐ Basement wo/plumbing

Comments:/Conditions:


INITIAL SITE SKETCH

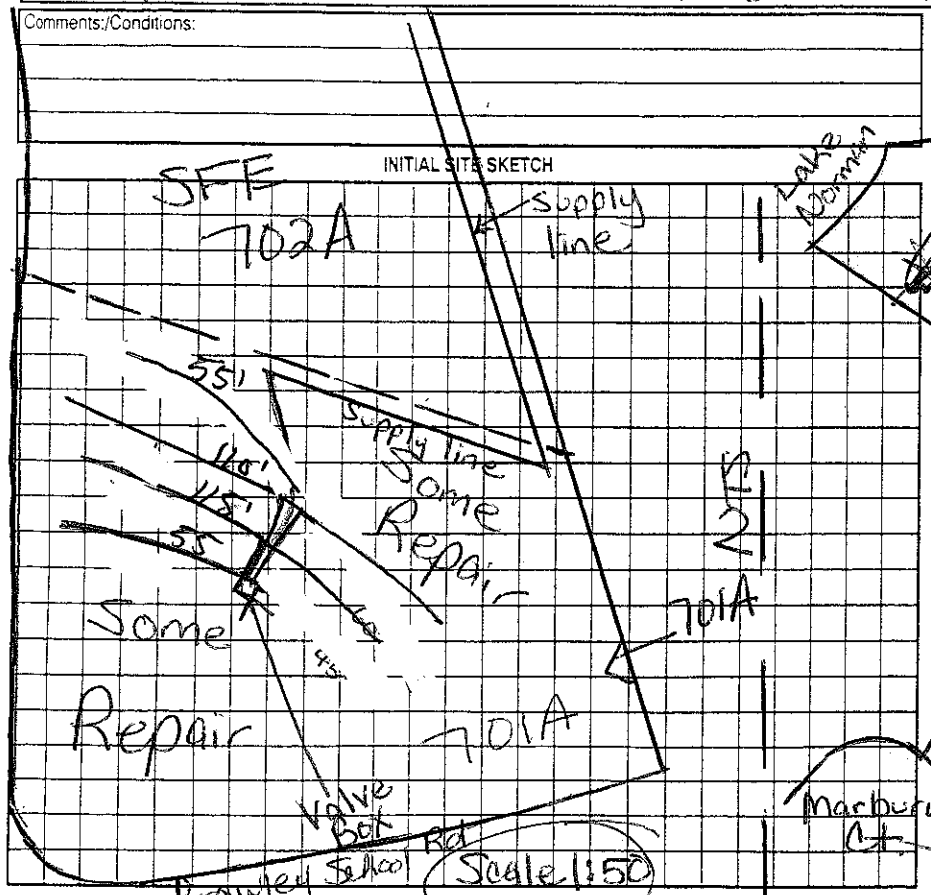

Comments:/Conditions:

* Use trench width as specified in Crescent Comm Manuel
9/23/14 Checked tanks @ 10/3/14 Set 3ft pressure

AS BUILT SKETCH

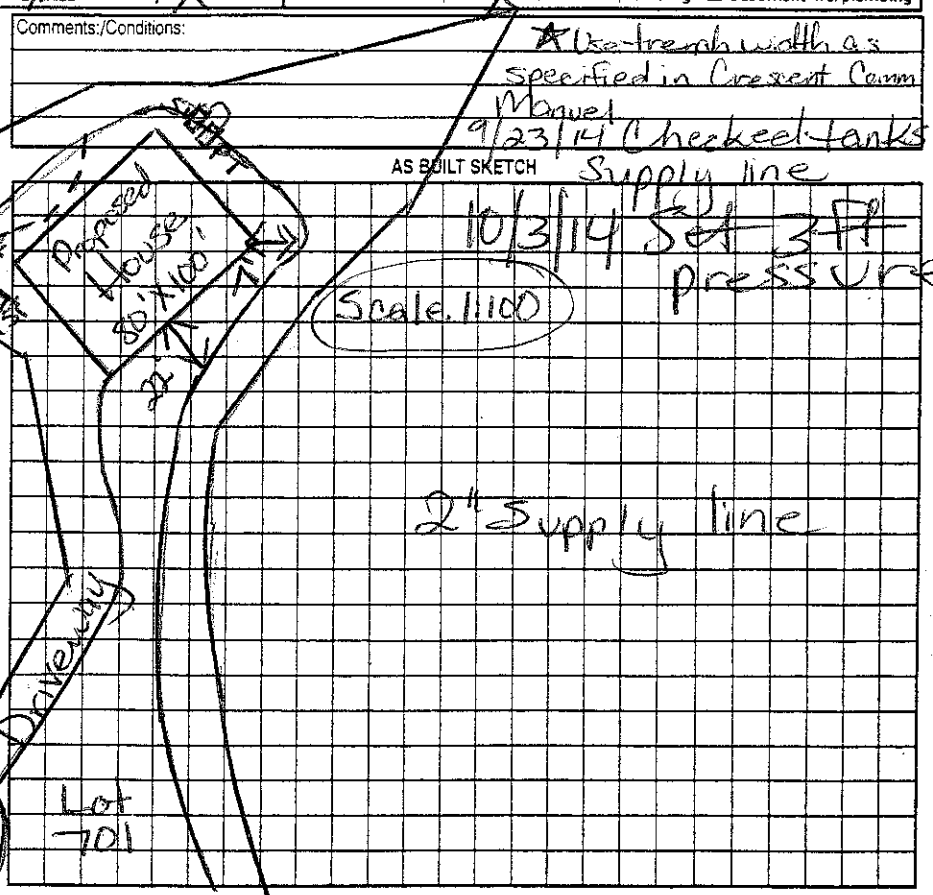

Permit can be suspended or revoked if any false information is supplied toward securing the permit/any unauthorized changes are made to the site/any unauthorized changes are made in the installation of the system. Improvement Permit with plat valid without expiration ☐ Improvement Permit with site plan valid for sixty months ☐ Authorization to Construct is valid for a period equal to that of Improvement Permit – not to exceed sixty months.

Signed: date 8-27-07 Installed by: Gary Leatherman

Improvement Permit by: Maine H. Dotson RS date 8/1/07 Operation Permit by: Maine H. Dotson RS date 11/18/14

Authorization to Construct by: Maine H. Dotson RS date 8/1/07 Existing System Inspection by: date

updated AC Cindy Mabry 7-31-13

HEALTH DEPT. COPY: WHITE OWNER COPY (FINAL): YELLOW OWNER COPY (INITIAL): PINK