IREDELL COUNTY HEALTH DEPARTMENT

STATESVILLE 704-878-5305 MOORESVILLE 704-664-5281

IMPROVEMENT PERMIT / AUTHORIZATION TO CONSTRUCT / OPERATION PERMIT / EXISTING SYSTEM INSPECTION

PERMIT# 094921 PIN# ~~4625-94-7684 PT~~ 4625-73-3103 DATE 10/16/02

OWNER OR CONTRACTOR Pienst Custom Homes PHONE: Business 704-892-8426 Home

ADDRESS 9606-A Caldwell Commons Cornelius NC 28031

LOCATION Brawley Sch, TR Attleboro, on corner w/ Marbury #105

SUBDIVISION Point BLOCK / SECTION 7 LOT 703/703 LOT AREA 40,194 ft² + 51,067 ft² SITE CLASS. SFE-PS DESIGN FLOW 600 L.T.A.R. 0.3 initial, 0.2 Repair

Septic Tank: 1500 Gallons; STB 338 Date 6-09-03
Pump Tank: 1500 Gallons; P.T 338 Date 4-06-03
Pump Make: Myers Model Serial No.
Nitrification Field: No Fields 1 Square Feet 1020 Linear Feet 340
No Lines 4@85' Trench Width 36" Max Trench Bottom Depth min 36" Gravel Depth —

☒ New System ☐ Repair System Type: I. II. III. IV. V. VI (SEE)
System Description: LP Panel Block
Repair System Description: Same
Maintenance Agreement Required: ☒ Yes ☐ No


☒ House/Mod. Home No. Bedrooms 5
☐ Mobile Home No. Bathrooms 5½
☐ Business No. Employees
☐ Other
☐ Slab ☐ Crawl Space ☒ Basement w/plumbing ☐ Basement wo/plumbing

Water Supply: ☐ Individual ☐ Public ☒ Community


Comments/Conditions:

Comments/Conditions: 5/32" hole drilled
Lines checked 12/30/02 mD
Tanks checked 7/15/03 mD
Alarm elect. checked 8/18/03 mD
Pressure checked 8/24/03

INITIAL SITE SKETCH 1:100

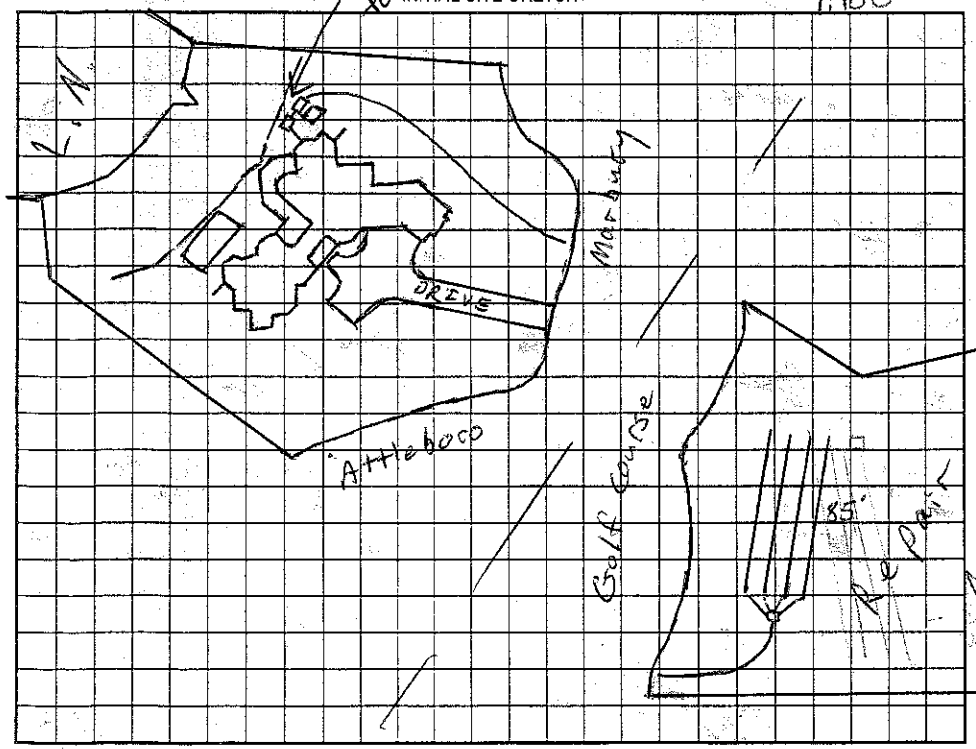

AS BUILT SKETCH

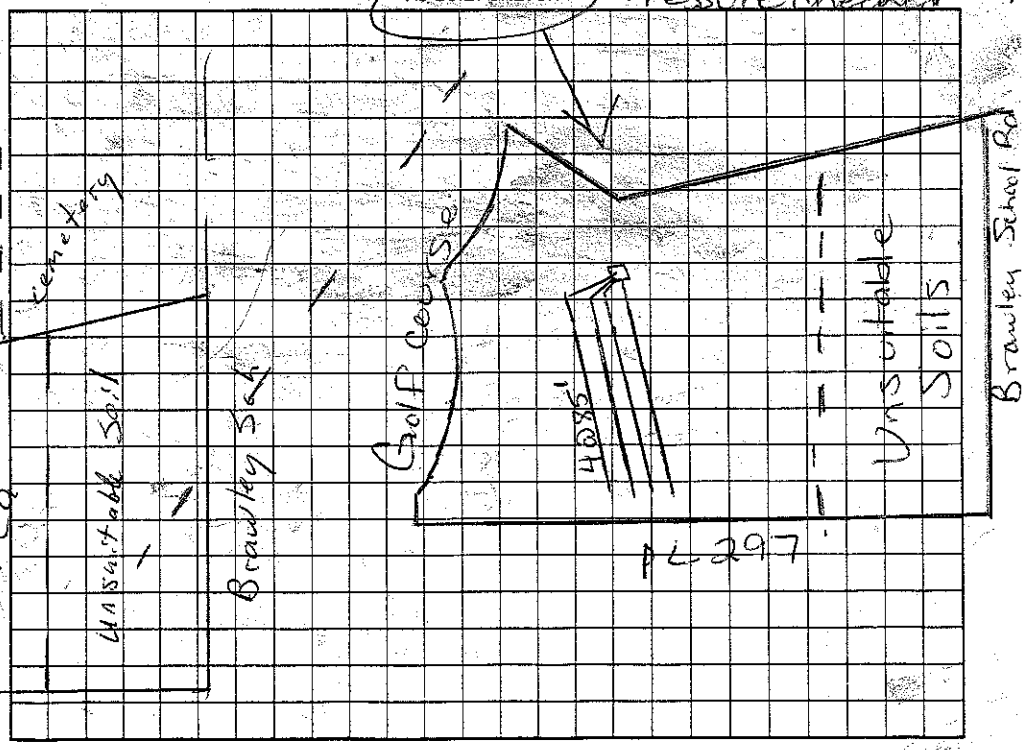

Permit can be suspended or revoked if any false information is supplied toward securing the permit/any unauthorized changes are made to the site/any unauthorized changes are made in the installation of the system. Improvement Permit with plat valid without expiration. Improvement Permit with site plan valid for sixty months. Authorization to Construct is valid for a period equal to that of Improvement Permit – not to exceed sixty months.

Signed: [signature] date 10/21/02 Installed by: R&H Inc

Improvement Permit by: [signature] RS date 10/16/02 Operation Permit by: [signature] RS date 8/24/03

Authorization to Construct by: [signature] RS date 10/16/02 Existing System Inspection by: date

HEALTH DEPT. COPY: WHITE OWNER COPY (FINAL): YELLOW OWNER COPY (INITIAL): PINK