IREDELL COUNTY HEALTH DEPARTMENT

Statesville Office (704) 878-5305 Mooresville Office (704) 660-3625 PERMIT # 17806 11:30

IMPROVEMENT PERMIT / AUTHORIZATION TO CONSTRUCT / OPERATION PERMIT / EXISTING SYSTEM

PIN # 4625 737422

APPLICANT: BLUEFIELD BUILDERS APPLICANT ADDRESS: 127 PROMENADE DR. MOORESVILLE 28117

SITE ADDRESS: 2016 BRAWLEY SCHOOL RD. - MOORESVILLE PHONE: ALT. PHONE:

SITE DIRECTIONS: BRAWLEY SCHOOL - PAST TRAFFIC CIRCLE & STONEWALL BEACH - ACCESS ROAD ON RT

SUBDIVISION: POINT SECTION: 6 LOT # 640 LOT AREA: 1.219AC DESIGN FLOW: 360 GPD L.T.A.R.: .36 APPLIED


Septic Tank	~~1000~~ 1500 (gal)	STB	338	Date	11-10-11	☑ New System ☐ Repair ☐ Expansion	System Type: I II III IV V VI	☑ Residence	No. Bedrooms	3	Water Supply
Pump Tank	(gal)	PT		Date		System Description:	GRAVITY 25% REDUCTION	☐ Business	No. Persons	6	☐ Private
Pump Make	Model		Serial #			Repair System Description:	SAME PUMP	☐ Other	No. Employees		☐ Public
# Nitrification Fields	1 # Lines	3	Linear Ft:	300		Maintenance Agreement Required:	☐ YES ☑ NO	☐ Slab	☑ Crawl Space		☑ Community
Trench Width	36" Max. Trench Bottom Depth	36"	Gravel Depth	N/A		☑ GRAVITY ☐ PRESSURE		☐ Basement w/plumbing		☐ Basement w/o plumbing	

Comments / Conditions:


ST 11-10-11

Quick & installed essentially as drawn

INITIAL SITE SKETCH

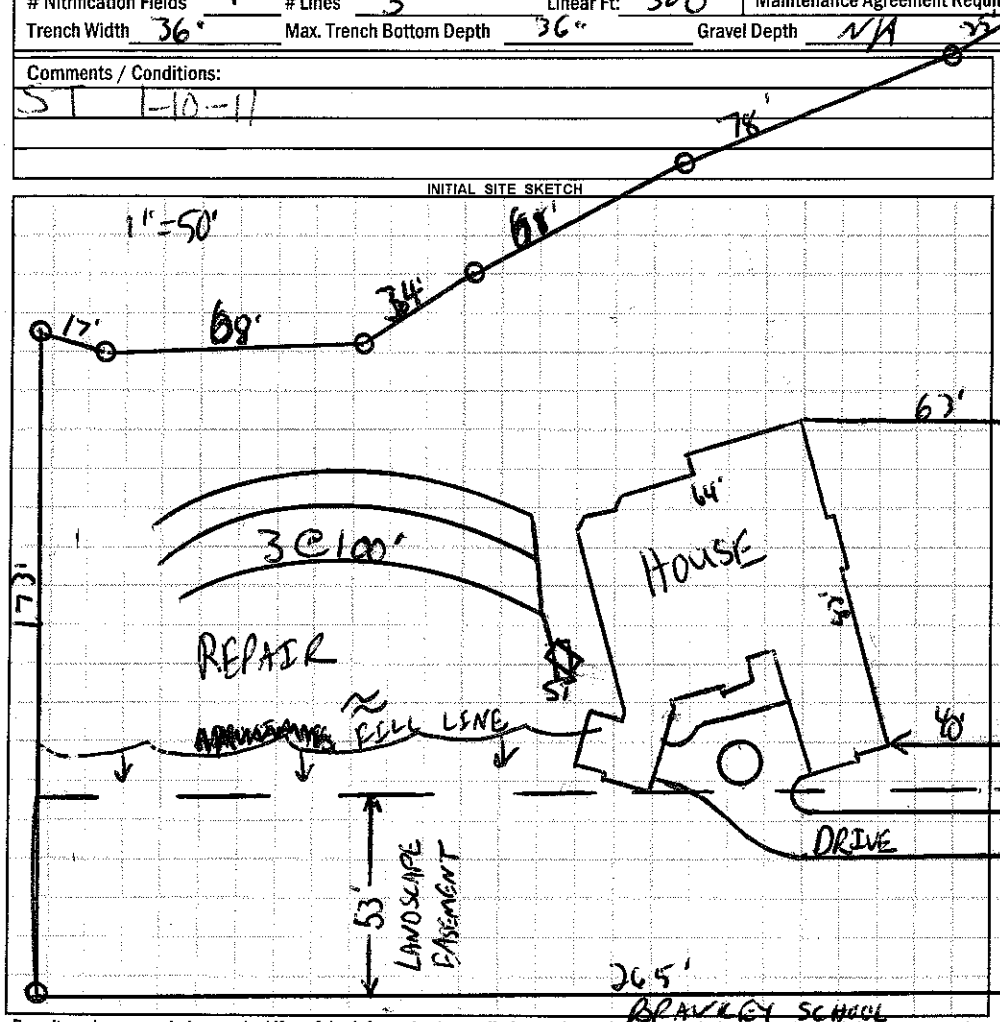

AS BUILT SKETCH

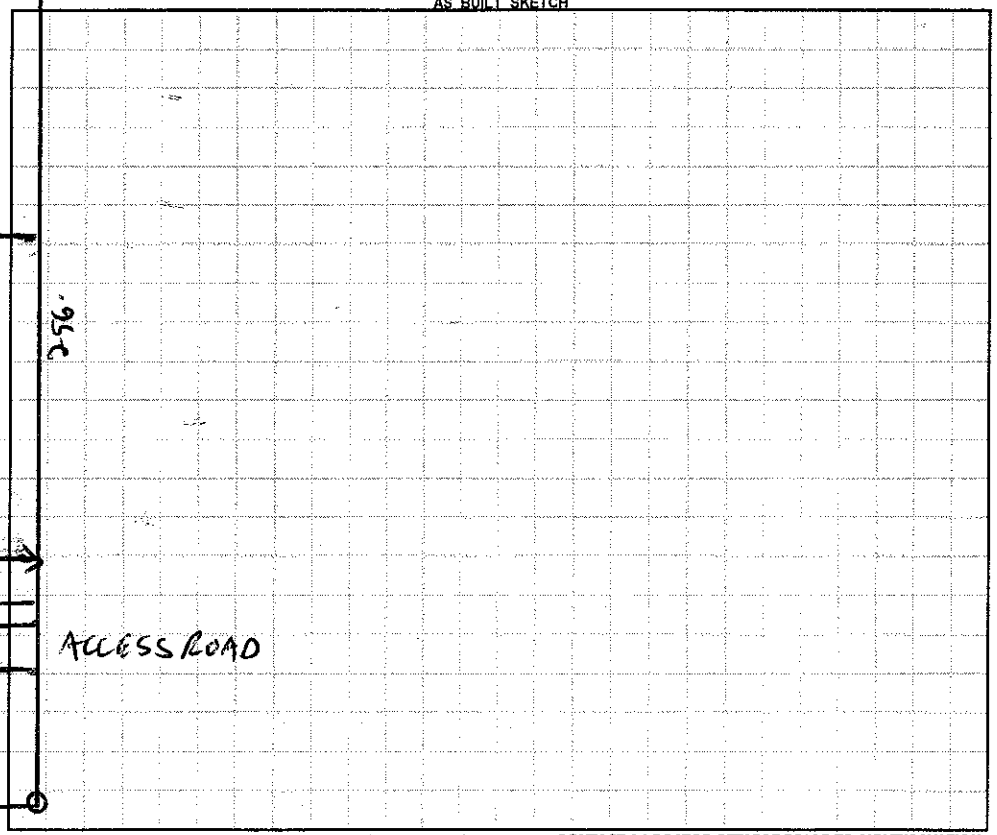

Permit can be suspended or revoked if any false information is supplied toward securing the permit / any unauthorized changes are made to the site / any unauthorized changes are made in the installation of the system. **CONTACT A LOCATOR SERVICE PRIOR TO ANY EXCAVATION**

☐ **IMPROVEMENT PERMIT** ***with plat*** *valid without expiration.* ☑ **IMPROVEMENT PERMIT** ***with site plan*** *valid for 60 mos.* ☐ **AUTHORIZATION TO CONSTRUCT** *valid for period equal to IMPROVEMENT PERMIT--not to exceed 60 mo.*

Owner / Applicant Signature: Date: Installed by: Richard Abernathy

IMPROVEMENT PERMIT by: Date: 5/29/13 OPERATION PERMIT by: Maria H. Wilson RS. Date: 3/5/14

AUTHORIZATION TO CONSTRUCT by: Date: 5/29/13 Existing System Inspected by: Date:

Health Dept. Copy - WHITE Applicant (Final Approval) - YELLOW Applicant (Conditional Approval) - PINK