IREDELL COUNTY HEALTH DEPARTMENT

Statesville Office (704) 878-5305 Mooresville Office (704) 660-3625

IMPROVEMENT PERMIT / AUTHORIZATION TO CONSTRUCT / OPERATION PERMIT / EXISTING SYSTEM

PERMIT # 17056

PIN # 4625737614

APPLICANT: Arthur Rutenberg Homes APPLICANT ADDRESS:

SITE ADDRESS: PHONE: ALT. PHONE:

SITE DIRECTIONS:

SUBDIVISION: The Point SECTION: 6 LOT # 639 LOT AREA: 44,433ft² DESIGN FLOW: 480gpd L.T.A.R.: .3-.25

Septic Tank 1500 (gal) STB 338 Date

Pump Tank 1000 (gal) PT 27 Date

Pump Make Gould's Model WE0312MV Serial #

Nitrification Fields # Lines Linear Ft:

Trench Width Max. Trench Bottom Depth Gravel Depth

☒ New System ☐ Repair ☐ Expansion System Type: I II III (IV) V VI

System Description: Pump - LP - Panel Blk

Repair System Description: Same

Maintenance Agreement Required: ☒ YES ☐ NO

☐ GRAVITY ☒ PRESSURE

☒ Residence No. Bedrooms

☐ Business No. Persons

☐ Other No. Employees

☐ Slab ☒ Crawl Space


☐ Basement w/ plumbing ☐ Basement w/o plumbing

Water Supply: ☐ Private ☐ Public ☒ Community

Comments / Conditions:

INITIAL SITE SKETCH

AS BUILT SKETCH

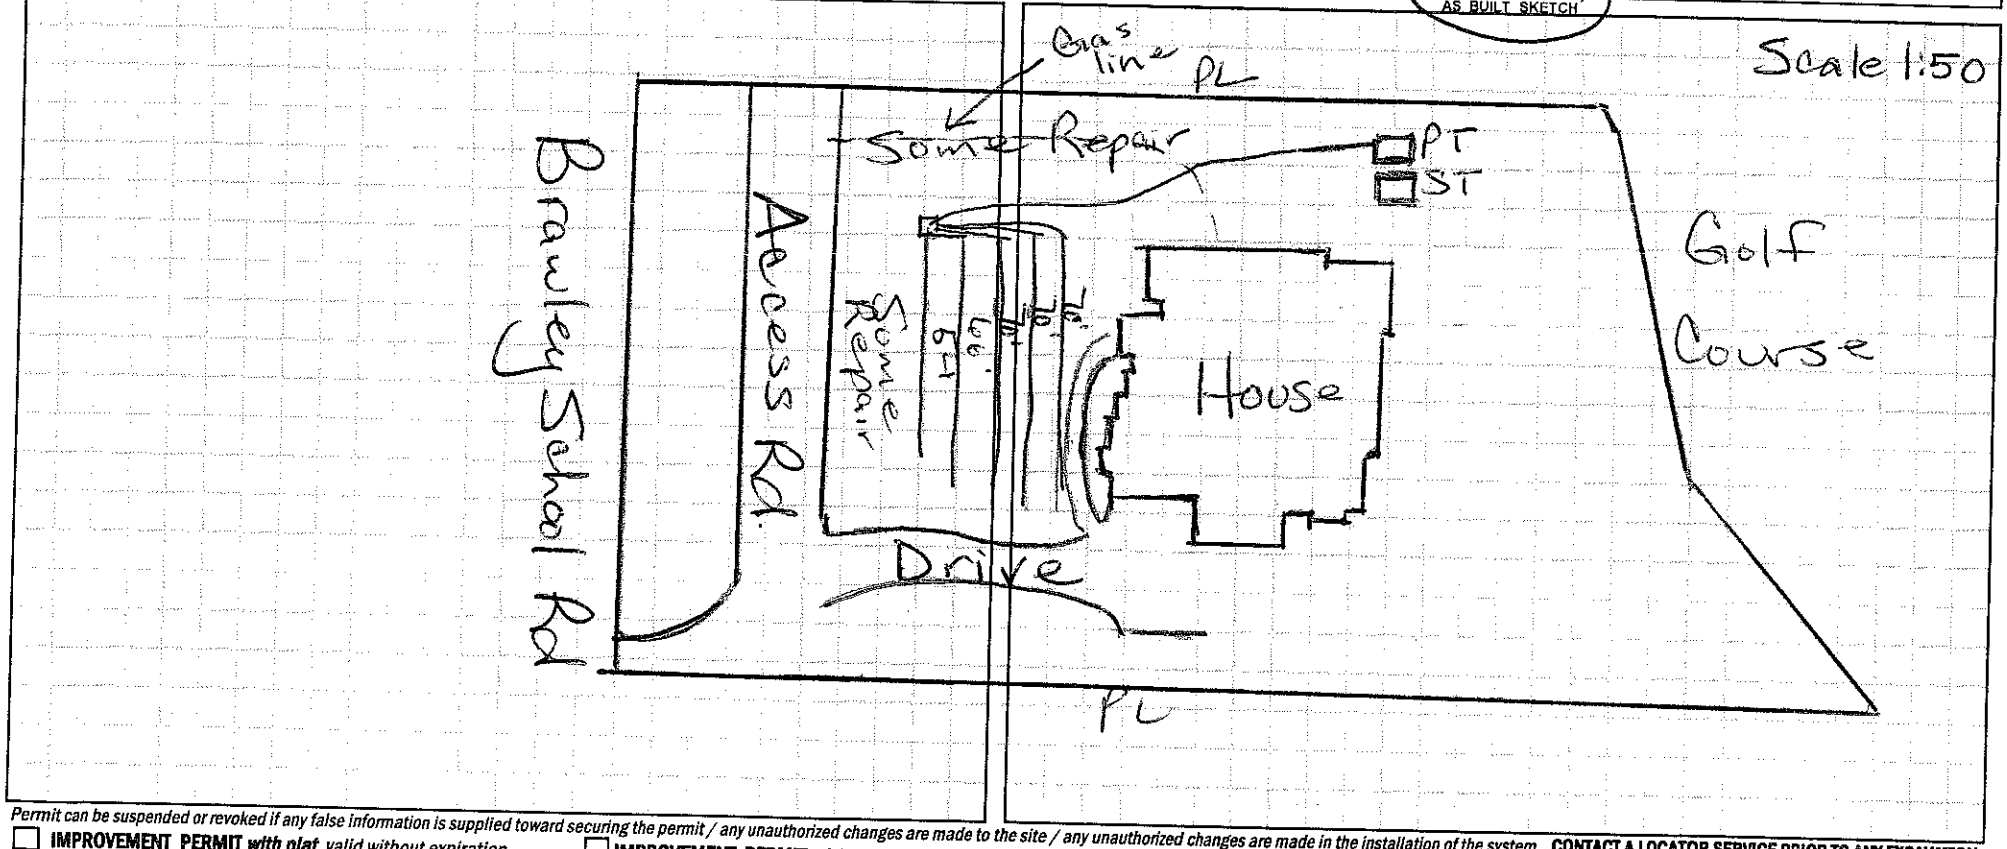

Permit can be suspended or revoked if any false information is supplied toward securing the permit / any unauthorized changes are made to the site / any unauthorized changes are made in the installation of the system. **CONTACT A LOCATOR SERVICE PRIOR TO ANY EXCAVATION**

☐ **IMPROVEMENT PERMIT** ***with plat*** *valid without expiration.* ☐ **IMPROVEMENT PERMIT** ***with site plan*** *valid for 60 mos.* ☐ **AUTHORIZATION TO CONSTRUCT** *valid for period equal to IMPROVEMENT PERMIT--not to exceed 60 mo.*

Owner / Applicant Signature: Date:

IMPROVEMENT PERMIT by: Date:

AUTHORIZATION TO CONSTRUCT by: Date:

Installed by: Richard Abernathy

OPERATION PERMIT by: Date: 3/25/13

Existing System Inspected by: Date:

Health Dept. Copy - WHITE Applicant (Final Approval) - YELLOW Applicant (Conditional Approval) - PINK