IREDELL COUNTY HEALTH DEPARTMENT

STATESVILLE 704-878-5305 MOORESVILLE 704-664-5281

IMPROVEMENT PERMIT / AUTHORIZATION TO CONSTRUCT / OPERATION PERMIT / EXISTING SYSTEM INSPECTI

2100

PERMIT# 90768 PIN# 4625941684 PT 4625 73 8918 DATE 10/23/00

OWNER OR CONTRACTOR CRESCENT RESOURCES/Hughes, Hamelink & PHONE: Business 663 6405 Home

ADDRESS PO Box 1003 CHARLOTTE NC 28201 Zander

LOCATION BRAWLEY SCHOOL TR STONEWALL BEACH - CORNER ON LT 107 Stonewall Beach

SUBDIVISION POINT BLOCK / SECTION 6 LOT 637 LOT AREA 5463 sq ft SITE CLASS. PS DESIGN FLOW 480 GPD L.T.A.R. .30 gpd/ft²

Septic Tank: 1000+ Gallons; STB 338 Date 10-28-02

Pump Tank: Gallons; PT Date

Pump Make: Model Serial No.

Nitrification Field: No Fields 1 Square Feet 1200 Linear Feet 400

No Lines 4 @ 100' Trench Width 36" Max Trench Bottom Depth 36"

☑ New System ☐ Repair System Type: I, II, III, IV, V, VI

System Description: GRAVITY 25% REDUCTION

Repair System Description: SAME

Maintenance Agreement Required: ☐ Yes ☑ No

Gravel Depth N/A

☑ House/Mod. Home No. Bedrooms 4

☐ Mobile Home No. Bathrooms 4

☐ Business No. Employees

☐ Other


☐ Slab ☑ Crawl Space ☐ Basement w/plumbing ☐ Basement wo/plumbing

Water Supply: ☐ Individual ☐ Public ☑ Community


Comments:/Conditions:

1) REMOVE TERRACES AND BERMS
2) NO AUTHORIZATION TO CONSTRUCT UNTIL OLD 2" WELL IS ABANDONED 11-7-2000
Reviewed Building Plans 6/25/2002
Plans in compliance with Septic permit
* Well abandonment forms attached.

INITIAL SITE SKETCH

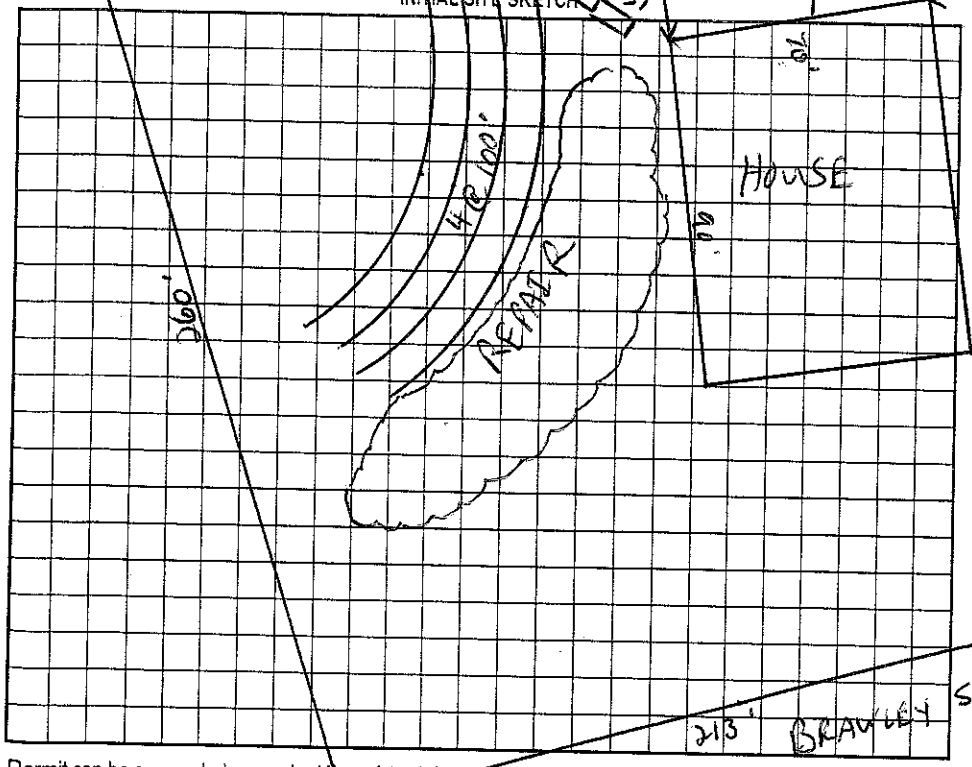

AS BUILT SKETCH

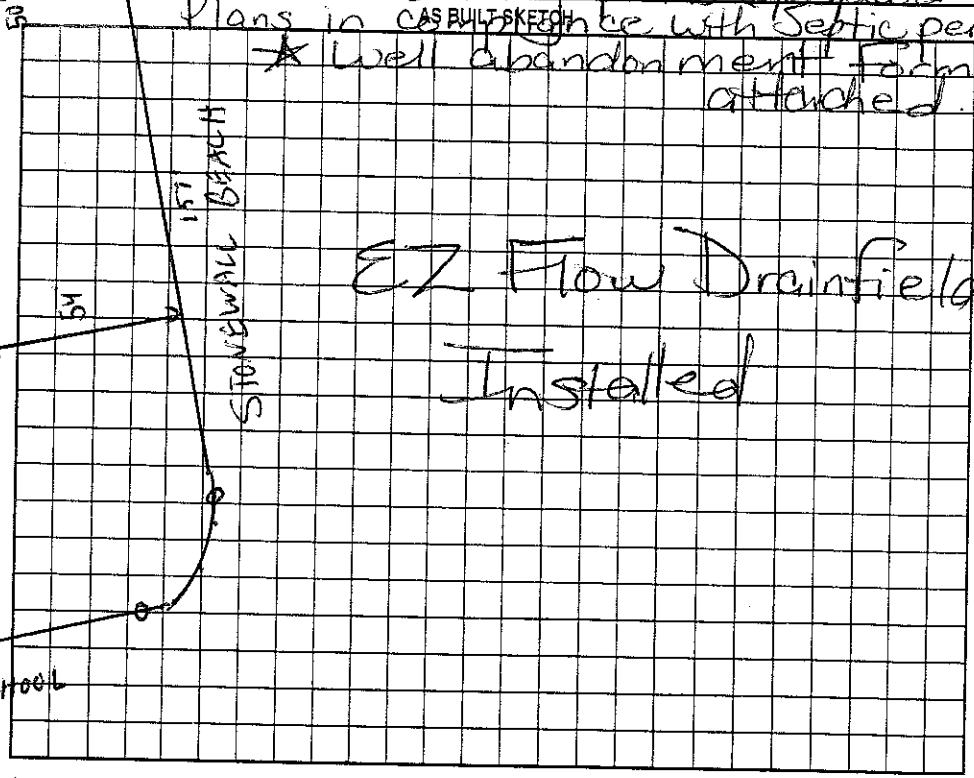

Permit can be suspended or revoked if any false information is supplied toward securing the permit/any unauthorized changes are made to the site/any unauthorized changes are made in the installation of the system. Improvement Permit with plat valid without expiration/Improvement Permit with site plan valid for sixty months. Authorization to Construct is valid for a period equal to that of Improvement Permit – not to exceed sixty months.

Signed: date 10/25/00

Improvement Permit by: RS date 10/27/00

Authorization to Construct by: RS date 6/25/2002

Installed by: Mayhew RS

Operation Permit by: RS date 1/13/2002

Existing System Inspection by: date

HEALTH DEPT. COPY: WHITE OWNER COPY (FINAL): YELLOW OWNER COPY (INITIAL): PINK