IREDELL COUNTY HEALTH DEPARTMENT

STATESVILLE 704-878-5305 245.00 Paid MOORESVILLE 704-664-5281 2500

IMPROVEMENT PERMIT / AUTHORIZATION TO CONSTRUCT / OPERATION PERMIT / EXISTING SYSTEM INSPECTION

PERMIT# ~~907-LT~~ 11756 PIN# ~~4625941684 PT~~ 4625-74-0348 DATE 11-24-03

OWNER OR CONTRACTOR Brian Hall (Simonini) PHONE: Business 704 309-3253 Home

ADDRESS 101 Canopy Ct. Mooresville, NC 28117

LOCATION Brawley School Rd TR Stone wall Beech on the left

SUBDIVISION The Point BLOCK / SECTION 6 LOT 630 LOT AREA .85 Acre SITE CLASS. PS DESIGN FLOW 600gpd L.T.A.R. .3

Septic Tank: 1500 Gallons; STB 338 Date 3-23-04
Pump Tank: 1500 Gallons; PT 421 Date 4-03-04
Pump Make: Myers Model ME.505-21 Serial No.
Nitrification Field(s) No. Fields 1 Square Feet 1005 Linear Feet 335
No. Lines 5@67' Trench Width 24"-36" Max Trench Bottom Depth 36" Gravel Depth N/A

☒ New System ☐ Repair System Type: I, II, III, IV, V, VI
System Description: Pump-LP-Panel Block
Repair System Description: Same
Maintenance Agreement Required: ☒ Yes ☐ No

☒ House/Mod. Home No. Bedrooms 5
☐ Mobile Home No. Bathrooms 4 Full 2 half
☐ Business No. Employees
☐ Other
☐ Slab ☐ Crawl Space ☒ Basement w/plumbing ☐ Basement wo/plumbing


Water Supply: ☐ Individual ☒ Public ☒ Community

Comments:/Conditions: Remove old terraces and berms
Keep Septic System at least 10' From PL & 15' From Future pool.


Comments:/Conditions: ~~&~~ 4 Full baths & 2 1/2 baths
Checked tanks & lines 5/20/04
Pressure, float & alarm
~~&~~ will change out pump floats & wire to make longer

Scale 1:50

INITIAL SITE SKETCH

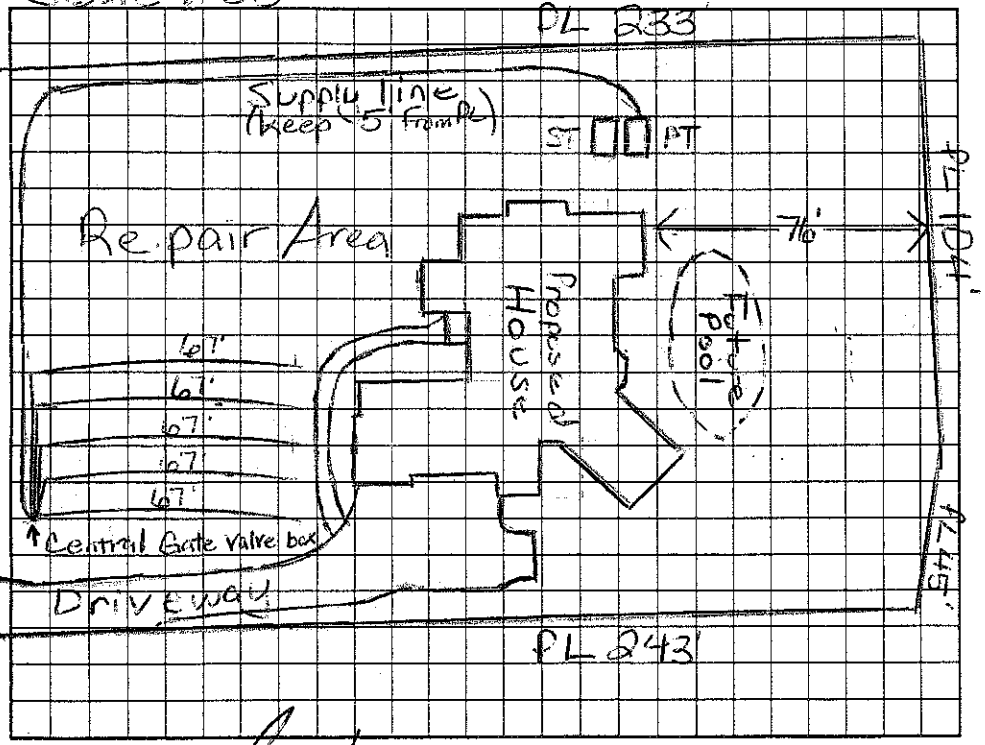

AS BUILT SKETCH

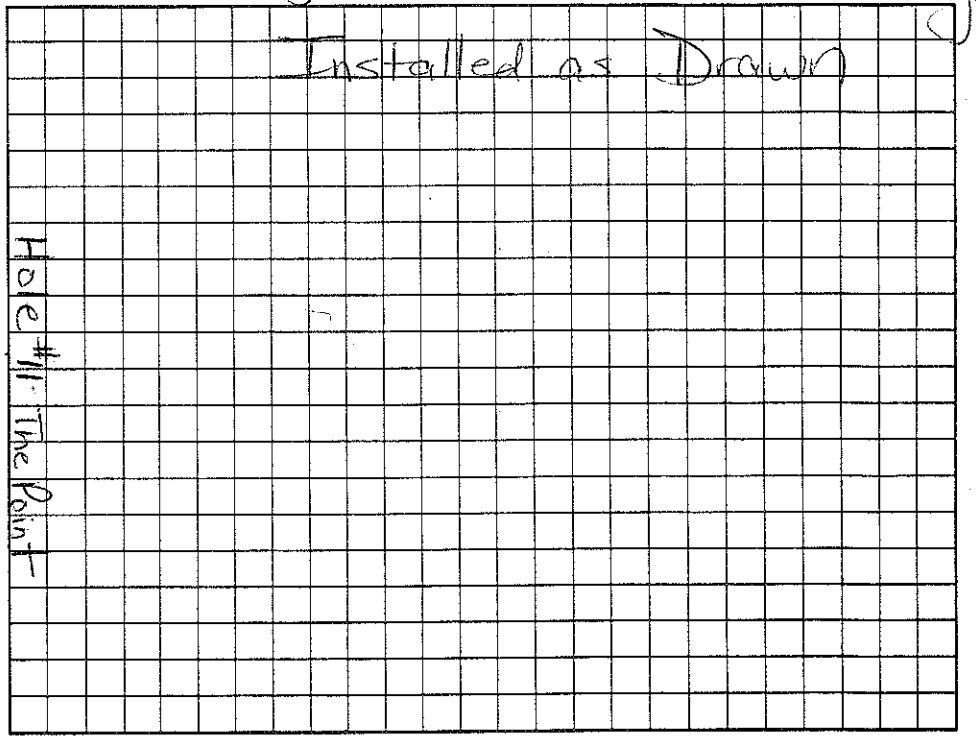

Permit can be suspended or revoked if any false information is supplied toward securing the permit/any unauthorized changes are made to the site/any unauthorized changes are made in the installation of the system. Improvement Permit with plat valid without expiration. Improvement Permit with site plan valid for sixty months. Authorization to Construct is valid for a period equal to that of Improvement Permit – not to exceed sixty months.

Signed: [signature] date 11/26/03 Installed by: R & H Inc

Improvement Permit by: Maina H H Dotson RS date 11/24/03 Operation Permit by: Maina H H Dotson RS date 7/21/04

Authorization to Construct by: Maina H H Dotson RS date 11/24/03 Existing System Inspection by: date

HEALTH DEPT. COPY: WHITE / OWNER COPY (FINAL): YELLOW OWNER COPY (INITIAL): PINK