IREDELL COUNTY HEALTH DEPARTMENT

STATESVILLE 704-878-5305 MOORESVILLE 704-664-5281

IMPROVEMENT PERMIT / AUTHORIZATION TO CONSTRUCT / OPERATION PERMIT / EXISTING SYSTEM INSPECTION

9:00

PERMIT# 90762 PIN# ~~4625941654~~ 4625-74-0547 DATE 10/23/00

OWNER OR CONTRACTOR CRESCENT RESOURCES / Hughes & Assoc PHONE: Business 6636905 Home

ADDRESS PO Box 1003 CHARLOTTE NC 28201

LOCATION BRANLEY SCHOOL - TR STONEWALL BEACH - AT END OF LT

SUBDIVISION POINT BLOCK / SECTION 6 LOT 631 LOT AREA 39990 SITE CLASS. RS DESIGN FLOW ~~450GPD~~ L.T.A.R. .36GPD/FT²

Septic Tank: 1000+ Gallons; STB ~~3383~~ 3338 Date 2-18-05

Pump Tank: 1000+ Gallons; PT 3283 Date 2-14-05

Pump Make: Model Serial No.

Nitrification Field: No Fields 1 Square Feet 840 Linear Feet 280

No Lines 4@70' Trench Width 36" Max Trench Bottom Depth 36" Gravel Depth N/A

☒ New System ☐ Repair System Type: I, II, III, IV, V, VI

System Description: PUMP UP PANEL

Repair System Description: SAME

Maintenance Agreement Required: ☒ Yes ☐ No

☒ House/Mod. Home ☐ Mobile Home ☐ Business ☐ Other

No. Bedrooms 4 No. Bathrooms 4 No. Employees


☐ Slab ☒ Crawl Space ☐ Basement w/plumbing ☐ Basement wo/plumbing

Water Supply: ☐ Individual ☐ Public ☒ Community

Comments:/Conditions:

REMOVE TERRACES AND BERMS

1"=50' INITIAL SITE SKETCH

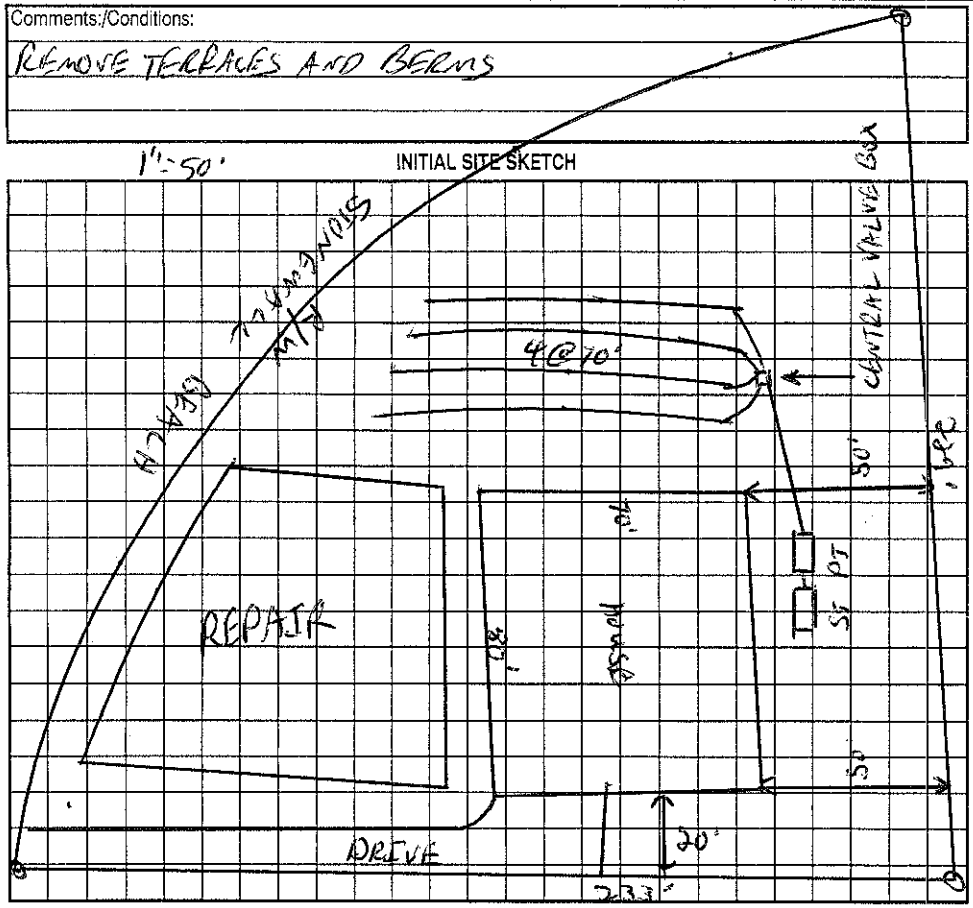

Comments:/Conditions: Reviewed plans & everything seems in compliance with IPS Installed Checked lines As Drawn 11/18/04

AS BUILT SKETCH

Pressure, elect & alarm

Permit can be suspended or revoked if any false information is supplied toward securing the permit/any unauthorized changes are made to the site/any unauthorized changes are made in the installation of the system. Improvement Permit with plat valid without expiration. Improvement Permit with site plan valid for sixty months. Authorization to Construct is valid for a period equal to that of Improvement ~~Permit~~ – not to exceed sixty months.

Signed: [signature] date 10/25/00 Installed by: R&H Inc RS

Improvement Permit by: [signature] date 10/23/00 Operation Permit by: [signature] date 6/3/05

Authorization to Construct by: [signature] date 5/7/04 Existing System Inspection by: date

HEALTH DEPT. COPY: WHITE OWNER COPY (FINAL): YELLOW OWNER COPY (INITIAL): PINK