IREDELL COUNTY HEALTH DEPARTMENT

STATESVILLE 704-878-5305 MOORESVILLE 704-664-5281

IMPROVEMENT PERMIT / AUTHORIZATION TO CONSTRUCT / OPERATION PERMIT / EXISTING SYSTEM INSPECTION

PERMIT# 140339 PIN# 4625-740875 DATE 8-2-07

OWNER OR APPLICANT Arcadia Homes PHONE: Business 662-6631 Home 201-7181

ADDRESS P.O. Box 471941 Charlotte NC 28247

LOCATION Brawley School Rd TR Stonewall Beach on right

SUBDIVISION Point BLOCK / SECTION 6 LOT 609 LOT AREA 41757± SITE CLASS. PS DESIGN FLOW 600gpd L.T.A.R. .3

Septic Tank: 1500 Gallons; STB 338 Date 5-7-07
Pump Tank: 1500 Gallons; PT 471 Date 9-13-07
Pump Make: Myers Model ME50DS Serial No.
Nitrification Field: No Fields 1 Square Feet 1017 Linear Feet 339
No Lines 5 Trench Width *See Note Max Trench Bottom Depth 36" Gravel Depth N/A ☐ Gravity ☒ Pressure ☐ Slab ☒ Crawl Space ☒ Basement w/plumbing ☐ Basement wo/plumbing


☒ New System ☐ Repair ☐ Expansion System Type: I, II, III, IV, V, VI
System Description: Pump-Ch-Panel Blk
Repair System Description: Same
Maintenance Agreement Required: ☒ Yes ☐ No

☒ House/Mod. Home No. Bedrooms 5
☐ Mobile Home No. Persons
☐ Business No. Employees
☐ Other

Water Supply: ☐ Individual ☒ Public ☒ Community

Comments/Conditions:

Lake Norman

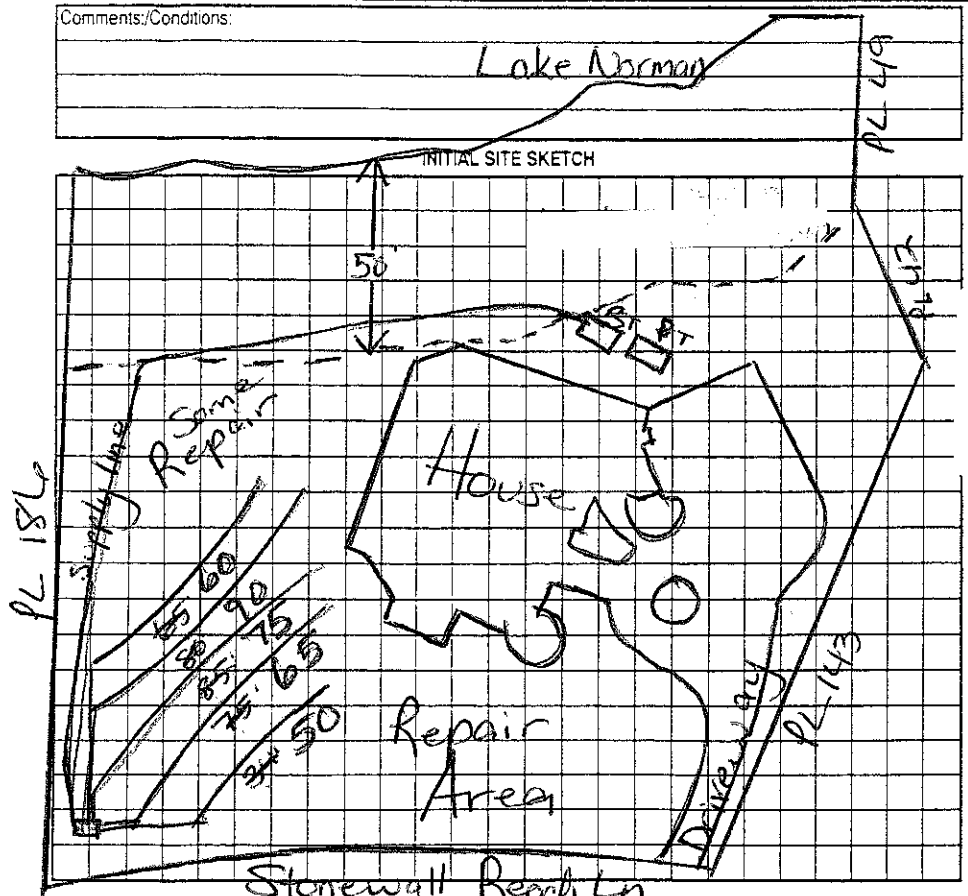

Comments/Conditions: *Note: Use trench width as specified in Crescent Communities Manual

AS BUILT SKETCH

8/20/07 Checked tanks
11/14/07 Checked lines

The proposed / existing Finishing of Basement addition does not appear to impact the existing septic system.
**NOTE: Number of Bedrooms remains 5.

Maria H. Dobson R.S.
Date: 9/3/09
ICHD-Environmental Health Division

Permit can be suspended or revoked if any false information is supplied toward securing the permit/any unauthorized changes are made to the site/any unauthorized changes are made in the installation of the system. Improvement Permit with plat valid without expiration ☐ Improvement Permit with site plan valid for sixty months ☐ Authorization to Construct is valid for a period equal to that of Improvement Permit – not to exceed sixty months.

Signed: X

Improvement Permit by: Maria H. Dobson RS date 8/2/07

Authorization to Construct by: Maria H. Dobson RS date 8/2/07

Installed by: R & H RS

Operation Permit by: Maria H. Dobson date 4/21/08

Existing System Inspection by: date

HEALTH DEPT. COPY: WHITE OWNER COPY (FINAL): YELLOW OWNER COPY (INITIAL): PINK