IREDELL COUNTY HEALTH DEPARTMENT

STATESVILLE 704-878-5305 MOORESVILLE 704-664-5281

IMPROVEMENT PERMIT / AUTHORIZATION TO CONSTRUCT / OPERATION PERMIT / EXISTING SYSTEM INSPECT

PERMIT# 90763 PIN# 4625 94 1684 PT 4625 74 4600 DATE 10/23/00

OWNER OR CONTRACTOR CRESCENT RESOURCES/Hughes, Hamby, Zinke & Wilson PHONE: Business 663-6905 Home

ADDRESS PO BOX 1003 CHARLOTTE NC 28201

LOCATION BRAWLEY SCHOOL - TR STONEWALL BEACH - AT END ON LT

SUBDIVISION POINT BLOCK / SECTION 6 LOT 632 LOT AREA 45742 SF SITE CLASS. PS DESIGN FLOW 480 GPD L.T.A.R. .36 GPD/FT²

Septic Tank: ~~1000~~ 1500 Gallons; STB 338 Date 5-21-02

Pump Tank: Gallons; PT Date

Pump Make: Model Serial No.

Nitrification Field: No Fields 1 Square Feet 1200 Linear Feet 400

No Lines 3@133' Trench Width 36" Max Trench Bottom Depth 36" Gravel Depth N/A

☑ New System ☐ Repair System Type: I, II, (III), IV, V, VI

System Description: GRAVITY 25% REDUCTION

Repair System Description: SAME

Maintenance Agreement Required: ☐ Yes ☑ No

☑ House/Mod. Home No. Bedrooms 4

☐ Mobile Home No. Bathrooms 4

☐ Business No. Employees

☐ Other


☐ Slab ☐ Crawl Space ☐ Basement w/plumbing ☐ Basement wo/plumbing

Water Supply: ☐ Individual ☐ Public ☑ Community


Comments:/Conditions: REMOVE TERRACES AND BERMS

Comments:/Conditions: Site Plan significantly in compliance with permit

INITIAL SITE SKETCH

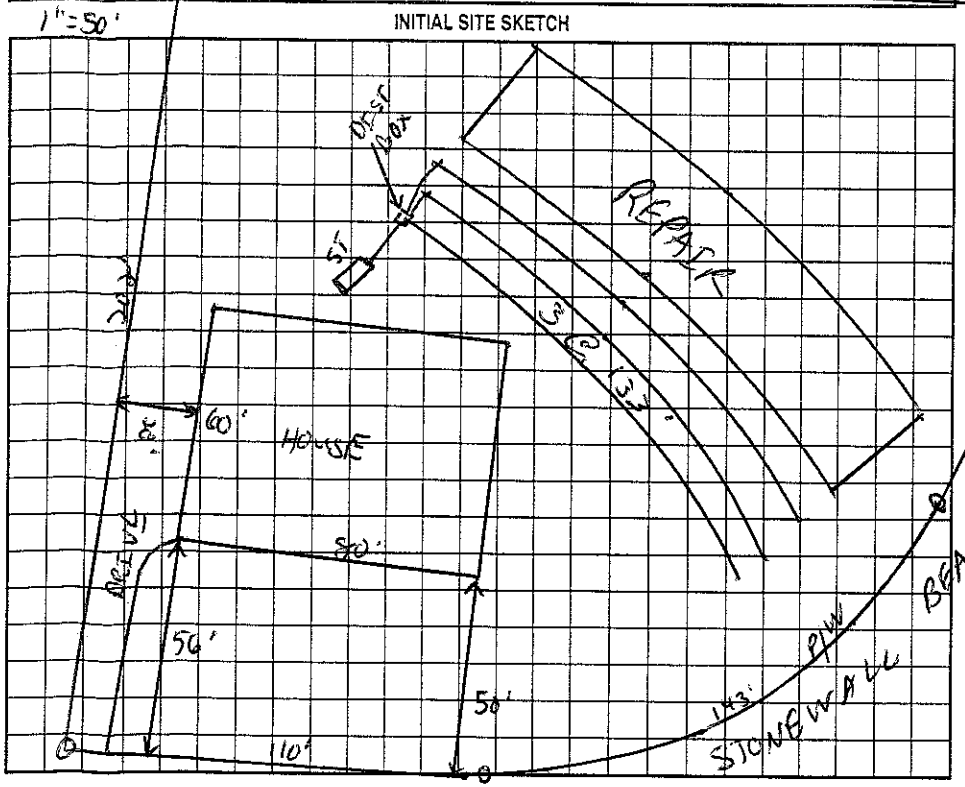

AS BUILT SKETCH

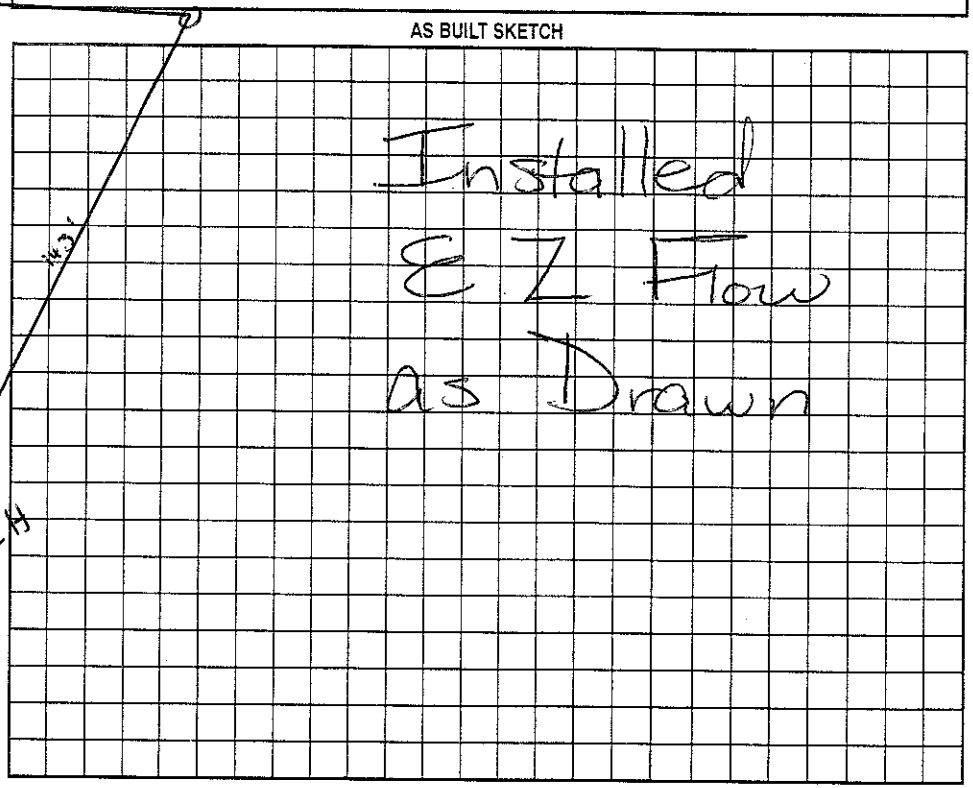

Permit can be suspended or revoked if any false information is supplied toward securing the permit/any unauthorized changes are made to the site/any unauthorized changes are made in the installation of the system. Improvement Permit with plat valid without expiration. Improvement Permit with site plan valid for sixty months. Authorization to Construct is valid for a period equal to that of Improvement Permit – not to exceed sixty months.

Signed: date 10/25/00 Installed by: Bobby Mayhew RS

Improvement Permit by: date 10/23/00 Operation Permit by: date 7/2/2002

Authorization to Construct by: RS date 1/28/02 Existing System Inspection by: date

HEALTH DEPT. COPY: WHITE OWNER COPY (FINAL): YELLOW OWNER COPY (INITIAL): PINK