IREDELL COUNTY HEALTH DEPARTMENT

STATESVILLE 704-878-5305 50.00 Paid MOORESVILLE 704-664-5281

IMPROVEMENT PERMIT / AUTHORIZATION TO CONSTRUCT / OPERATION PERMIT / EXISTING SYSTEM INSPECTION

PERMIT# 90700 PIN# ~~4625 94 1084 Pt.~~ 4625-74-9203 DATE 10/26/03

OWNER OR CONTRACTOR Kingswood Custom Homes PHONE: Business 704-506-3456 Home

ADDRESS 8033 Corp. Dr. Ste 400 Charlotte, NC. 28226

LOCATION 1100 TR Stonewall Beach on Rt. Corner

SUBDIVISION Point BLOCK / SECTION 6 LOT 606 LOT AREA 39,375 Ft² SITE CLASS. PS DESIGN FLOW 480 L.T.A.R. .3

Septic Tank: 1500 Gallons; STB 338 Date 3/8/04
Pump Tank: 1000 Gallons; PT 283 Date 3/15/04
Pump Make: Goulds Model WE0 - 712 Hu Serial No. G0496338
Nitrification Field: No Fields 1 Square Feet 1050 Linear Feet 350
No Lines 5 @ 70' Trench Width 2-3' Max Trench Bottom Depth 3' Gravel Depth N/A

☒ New System ☐ Repair System Type: I, II, III, ⓘ V, VI
System Description: Pres Dosed - 16" PPBPS
Repair System Description: Same Type
Maintenance Agreement Required: ☒ Yes ☐ No

☒ House/Mod. Home No. Bedrooms 4
☐ Mobile Home No. Bathrooms 4
☐ Business No. Employees
☐ Other


☐ Slab ☑ Crawl Space ☐ Basement w/plumbing ☐ Basement wo/plumbing

Water Supply: ☐ Individual ☐ Public ☒ Community Point


Comments/Conditions: 2'-8' ON CNTR / 3'-9' ON CNTR.

Comments/Conditions: 10/28/03 - Tanks may be located to right side of house 5' from foundation Aws.

INITIAL SITE SKETCH

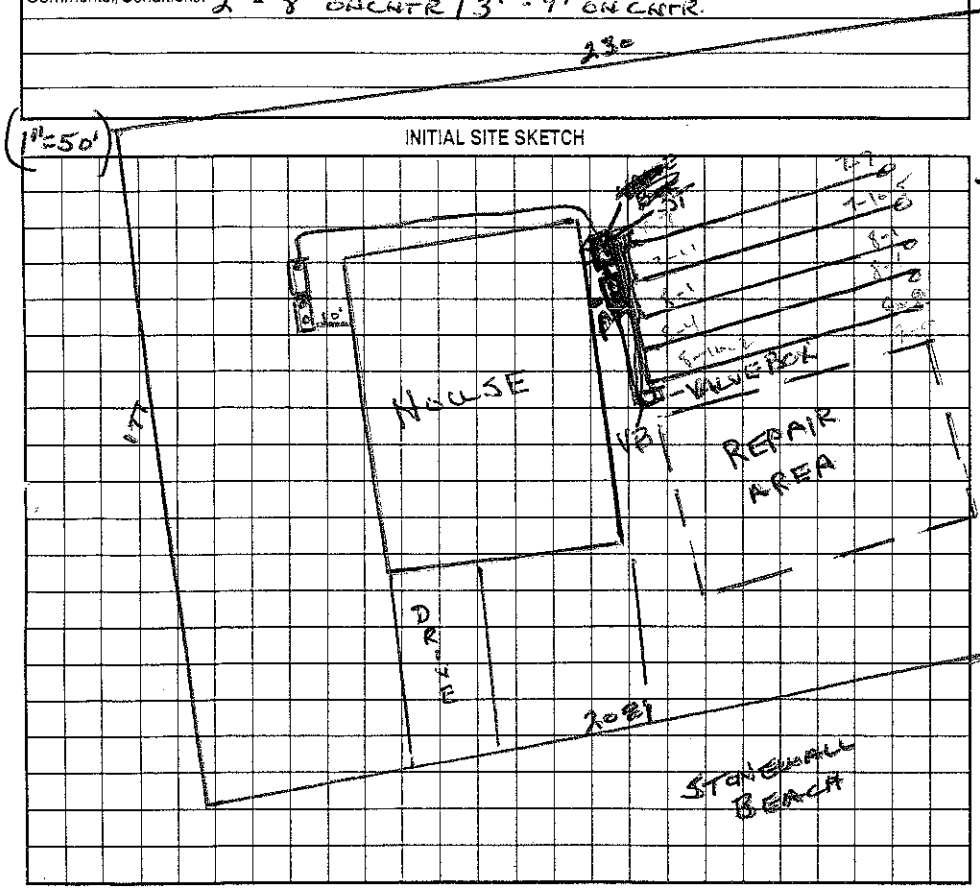

AS BUILT SKETCH

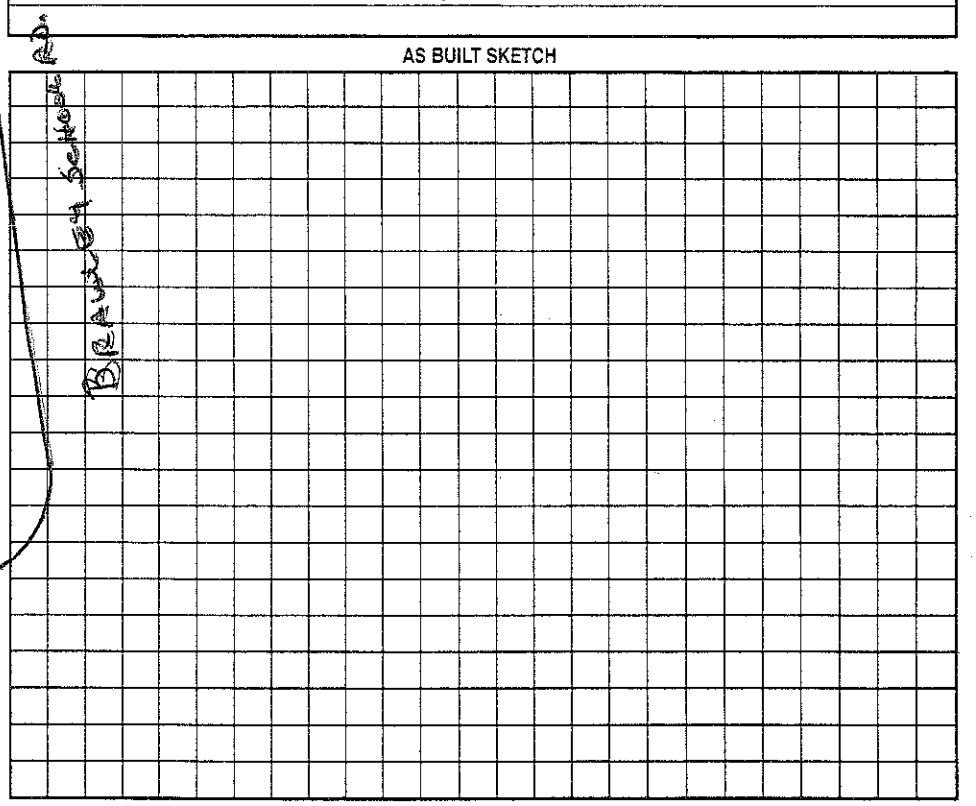

Permit can be suspended or revoked if any false information is supplied toward securing the permit/any unauthorized changes are made to the site/any unauthorized changes are made in the installation of the system. Improvement Permit with plat valid without expiration. Improvement Permit with site plan valid for sixty months. Authorization to Construct is valid for a period equal to that of Improvement Permit – not to exceed sixty months.

Signed: * date 10-21-03 Installed by: Hallman Const Inc.

Improvement Permit by: Wesley Sparks R.S. date 10/20/03 Operation Permit by: Wesley Sparks R.S. date 4/23/04

Authorization to Construct by: Wesley Sparks R.S. date 10/20/03 Existing System Inspection by: date

HEALTH DEPT. COPY: WHITE OWNER COPY (FINAL): YELLOW OWNER COPY (INITIAL): PINK