IREDELL COUNTY HEALTH DEPARTMENT

STATESVILLE 704-878-3305 MOORESVILLE 704-664-5281

IMPROVEMENT PERMIT / AUTHORIZATION TO CONSTRUCT / OPERATION PERMIT / EXISTING SYSTEM INSPECTION

PERMIT# 90699 PIN# ~~4625-44-1684-ct~~ 4625-74-9367 DATE 11/24/04

OWNER OR CONTRACTOR Lake Norman Signature Homes LLC PHONE: Business 704-361-5041 Home

ADDRESS 594 Brawley School Rd Suite 104 Mooresville NC 28117

LOCATION BSR, Thru Traffic Cir, TR Access Rd

SUBDIVISION Point BLOCK / SECTION 6 LOT 605 LOT AREA 34,530 SITE CLASS PS DESIGN FLOW 600 L.T.A.R. 0.25

Septic Tank: 1500 Gallons; STB 338 Date 11/15/04
Pump Tank: 1500 Gallons; PT 497 Date 11/21/04
Pump Make: GOULDS Model WE0 712 Serial No. M045267
Nitrification Field: No Fields 1 Square Feet 1200 Linear Feet 400
No Lines 4@100' Trench Width 36" Max Trench Bottom Depth 36" Gravel Depth —

☒ New System ☐ Repair System Type: I, II, III, IV, V, VI
System Description: LP Panel Block
Repair System Description: Same
Maintenance Agreement Required: ☒ Yes ☐ No


☒ House/Mod. Home No. Bedrooms 5
☐ Mobile Home No. Bathrooms
☐ Business No. Employees
☐ Other
☐ Slab ☒ Crawl Space ☒ Basement w/plumbing ☐ Basement wo/plumbing

Water Supply: ☐ Individual ☐ Public ☒ Community


Comments:/Conditions:
1"=50'

Comments:/Conditions:

INITIAL SITE SKETCH

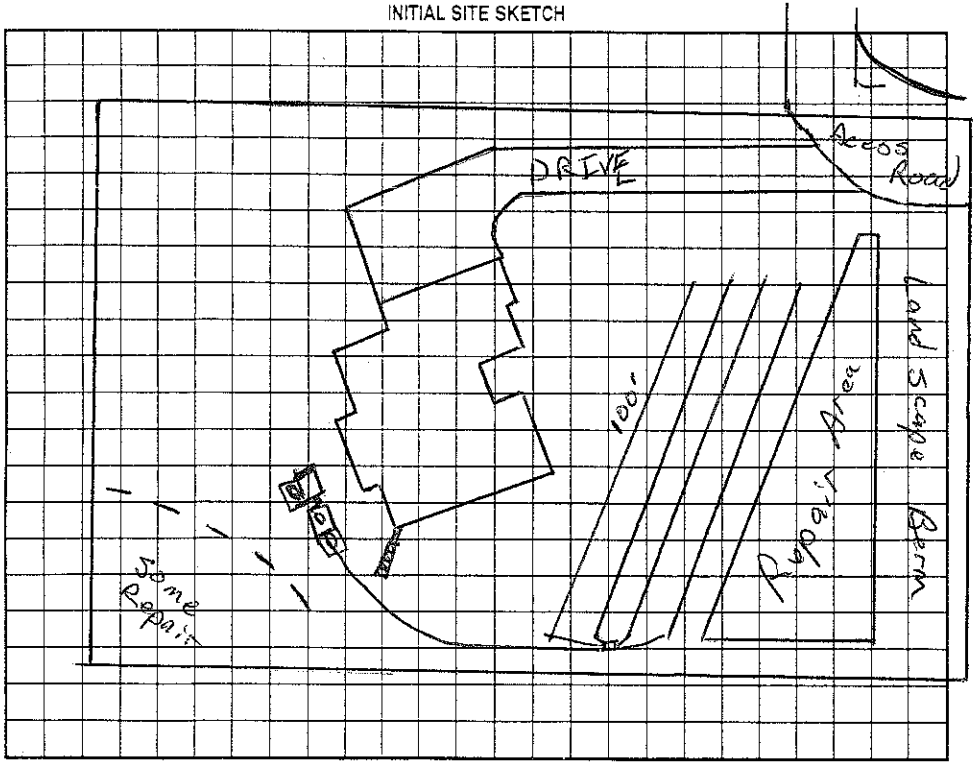

AS BUILT SKETCH

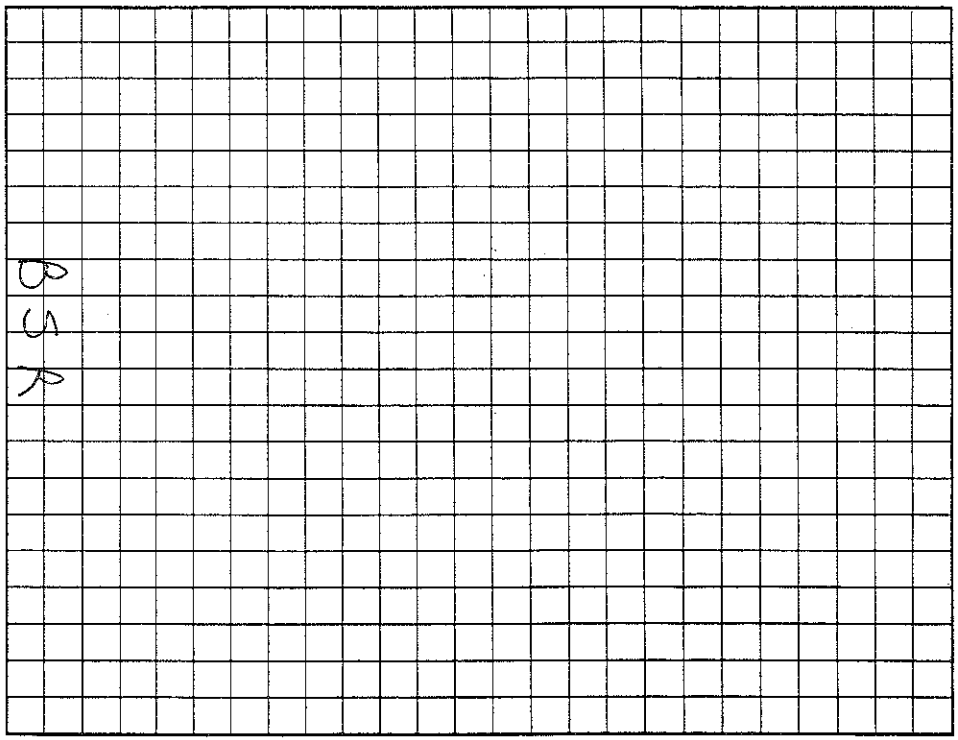

Permit can be suspended or revoked if any false information is supplied toward securing the permit/any unauthorized changes are made to the site/any unauthorized changes are made in the installation of the system. Improvement Permit with plat valid without expiration. Improvement Permit with site plan valid for sixty months. Authorization to Construct is valid for a period equal to that of Improvement Permit – not to exceed sixty months.

Signed: Tony Jacobs date 11-25-04 Installed by: Kevin Hallman

Improvement Permit by: RS date 11/24/04 Operation Permit by: RS date 2/16/05

Authorization to Construct by: RS date 11/24/04 Existing System Inspection by: date

HEALTH DEPT. COPY: WHITE OWNER COPY (FINAL): YELLOW OWNER COPY (INITIAL): PINK