IREDELL COUNTY HEALTH DEPARTMENT

STATESVILLE 704-878-5305 MOORESVILLE 704-664-5281

IMPROVEMENT PERMIT / AUTHORIZATION TO CONSTRUCT / OPERATION PERMIT / EXISTING SYSTEM INSPECTION

$125

PERMIT# 081374 PIN# 4625941684 (pt) 4625750215 DATE Sept. 3, '99

OWNER OR CONTRACTOR Crescent Resources dba/ The Point on Norman PHONE: Business 660-1185 Home

ADDRESS 2214 Brawley Sch Rd. John Poore Builders

LOCATION Brawley Sch Rd. TR Polaris TL Jeremy Pt. TR Brick Kiln TL Union Chapel Road on left

SUBDIVISION The Point BLOCK/ SECTION 5 LOT 544 LOT AREA 86,001 ft² SITE CLASS. FS DESIGN FLOW 460 gpd L.T.A.R. .03

Septic Tank: 1500 ~~1000~~ Gallons; STB 338 Date 3-17-01

Pump Tank: 1000 Gallons; PT 283 Date 3-19-01

Pump Make: ME50 Model Serial No.

Nitrification Field: No Fields 1 Square Feet 1200 Linear Feet 400

No Lines 4 @ 100' Trench Width 36" Max Trench Bottom Depth 36"

☑ New System ☐ Repair System Type: I, II, (III) IV, V, VI

System Description: PM - Innovative - 25% Reduction

Repair System Description: LP Panel Block

Maintenance Agreement Required: ☐ Yes ☑ No

Gravel Depth NA

☑ House/Mod. Home ☐ Mobile Home ☐ Business ☐ Other

No. Bedrooms 4 No. Bathrooms 4 No. Employees

☑ Slab ☑ Crawl Space ☑ Basement w/plumbing ☐ Basement wo/plumbing

Water Supply: ☐ Individual ☑ Public ☑ Community

Comments/Conditions: * ONE INSpection port PER LATERAL

Building plans & site plan reviewed 8/3/2000, it seems in compliance with Septic permit.


Comments/Conditions: (PARTIAL)

E/Z Flow lines installed & checked 4/16/2001


Filter & riser installed.

1"=50'

INITIAL SITE SKETCH

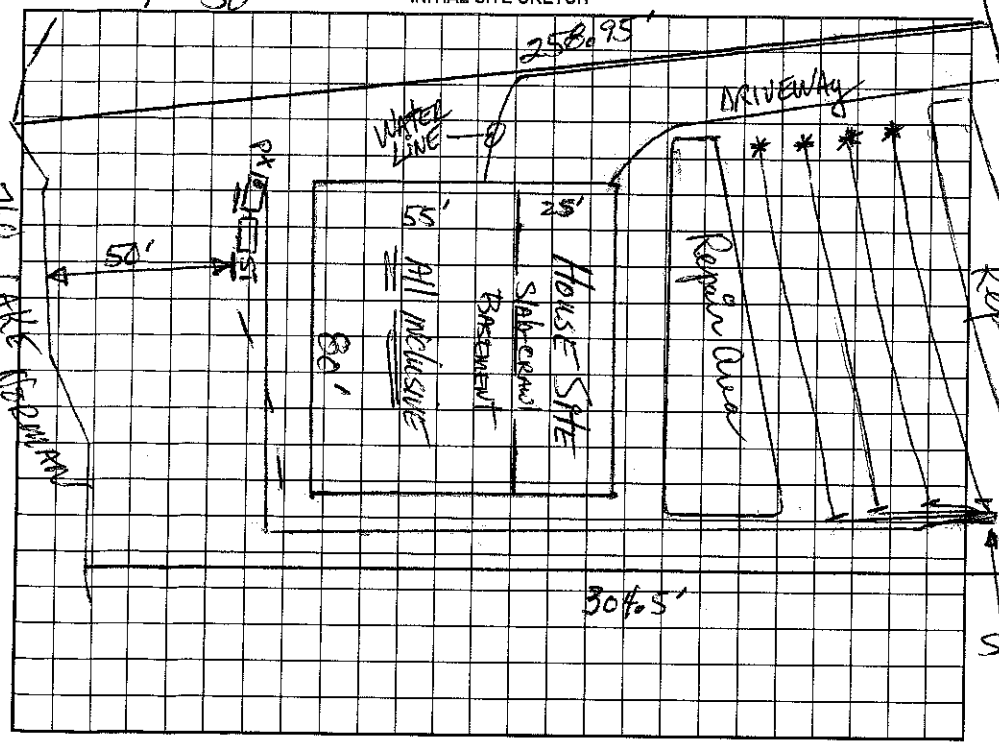

AS BUILT SKETCH

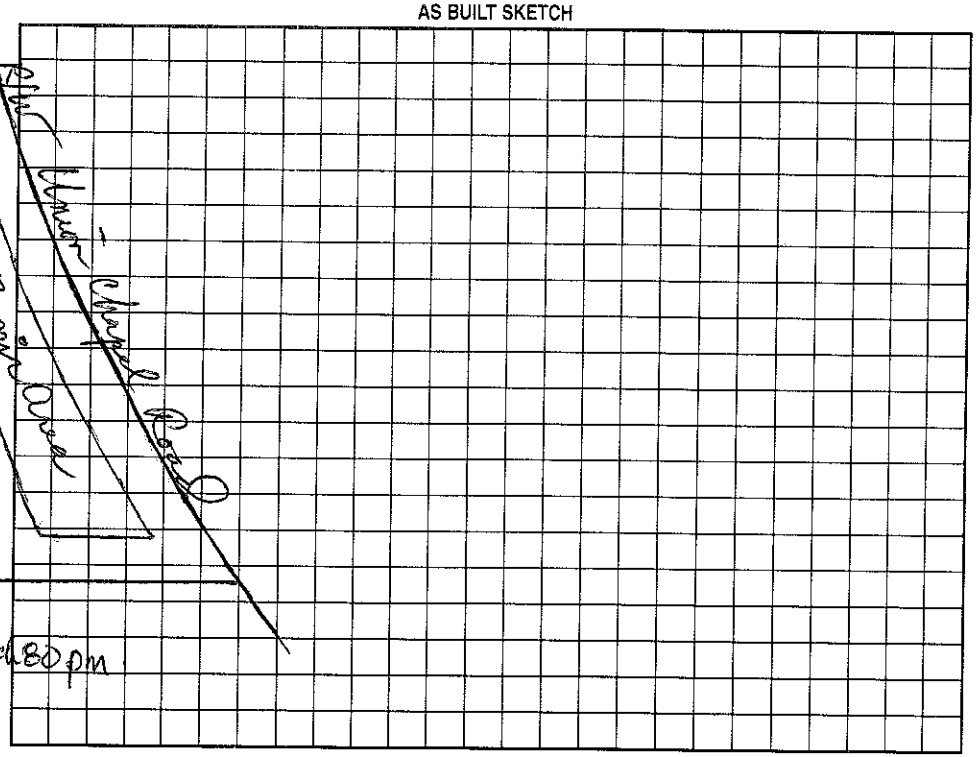

Permit can be suspended or revoked if any false information is supplied toward securing the permit/any unauthorized changes are made to the site/any unauthorized changes are made in the installation of the system. Improvement Permit with plat valid without expiration. Improvement Permit with site plan valid for sixty months. Authorization to Construct is valid for a period equal to that of Improvement Permit – not to exceed sixty months.

Signed: date 9-10-99 Installed by: R & H INC.

Improvement Permit by: date 9-3-99 Operation Permit by: RSI date 5/14/01

Authorization to Construct by: RS date 8/3/2000 Existing System Inspection by: date

HEALTH DEPT. COPY: WHITE OWNER COPY (FINAL): YELLOW OWNER COPY (INITIAL): PINK