IREDELL COUNTY HEALTH DEPARTMENT

STATESVILLE 704-878-5305 MOORESVILLE 704-664-5281

IMPROVEMENT PERMIT / AUTHORIZATION TO CONSTRUCT / OPERATION PERMIT / EXISTING SYSTEM INSPECTION

2:30 Start

$325

PERMIT# 08127A PIN# 4625941684 (pt) Brookshire Const. 4625-75-0680 DATE Sept 22, '99

OWNER OR CONTRACTOR Crescent Resources Inc. // The Hamilton Norman // PHONE: Business 660-1185 Home

ADDRESS 2214 Brawley Sch. Rd. Mooresville

LOCATION Brawley Sch. Rd. TR Volpis TL Jeremy Pt. TR Brick Kiln TL Union Chapel 2nd on Right

SUBDIVISION The Point BLOCK / SECTION 5 LOT 531 LOT AREA 37,836 + SFE 531A SITE CLASS. PS DESIGN FLOW 480 gpd L.T.A.R. .025±

Septic Tank: 1000+ Gallons; STB 338 5-9-00 Date ~~3-17-00~~

Pump Tank: 1000 Gallons; PT 27 Date 3-18-00

Pump Make: Gould's Model WE05J2HH0 Pump No.

Nitrification Field: No Fields 1 Square Feet 1020 Linear Feet 340 +

No Lines 4 Trench Width 36" Max Trench Bottom Depth 36"

☐ New System ☐ Repair System Type: I, II, III, (V) V, VI

System Description: LP Panel Block

Repair System Description: pm Innov 125% Rdn on 531A

Maintenance Agreement Required: ☑ Yes ☐ No

Gravel Depth NA

☑ Slab ☐ Crawl Space ☑ Basement w/plumbing ☐ Basement wo/plumbing

☑ House/Mod. Home No. Bedrooms 4

☐ Mobile Home No. Bathrooms 4

☐ Business No. Employees


☐ Other

Water Supply:
☐ Individual
~~☐ Public~~
☑ Community


Comments:/Conditions: 3-7-2000 Reviewed house site plan - 1"=100' appears in compliance w/ IP DAH

Comments:/Conditions: (PARTIAL) Tanks & lines checked 10/5/00 PM - 10' Below tree and Lofine pines —

INITIAL SITE SKETCH

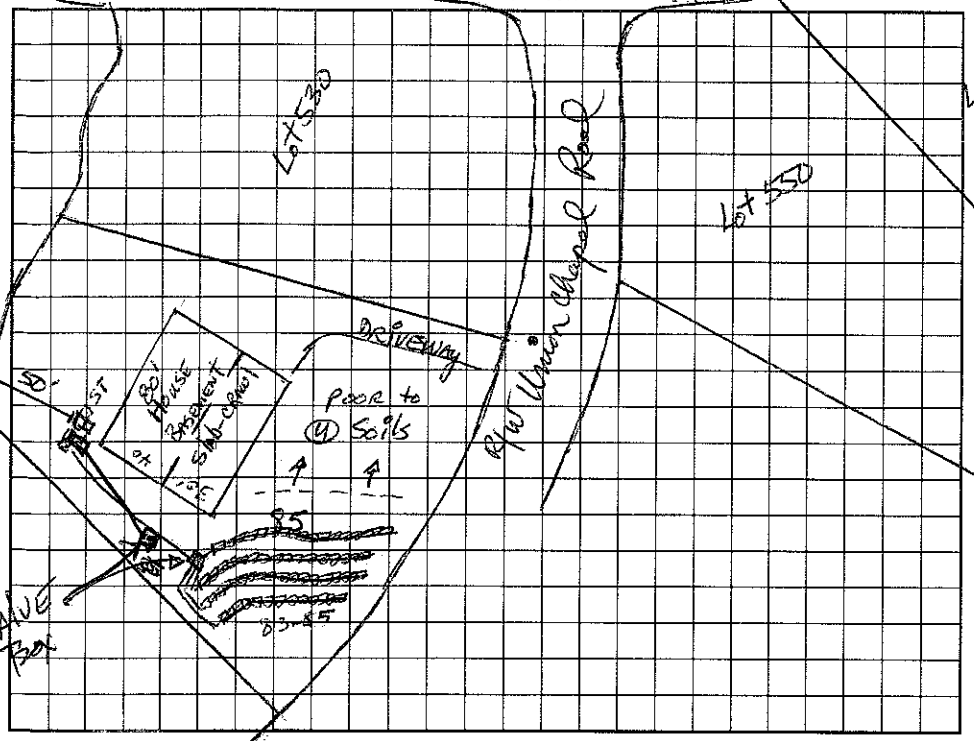

AS BUILT SKETCH

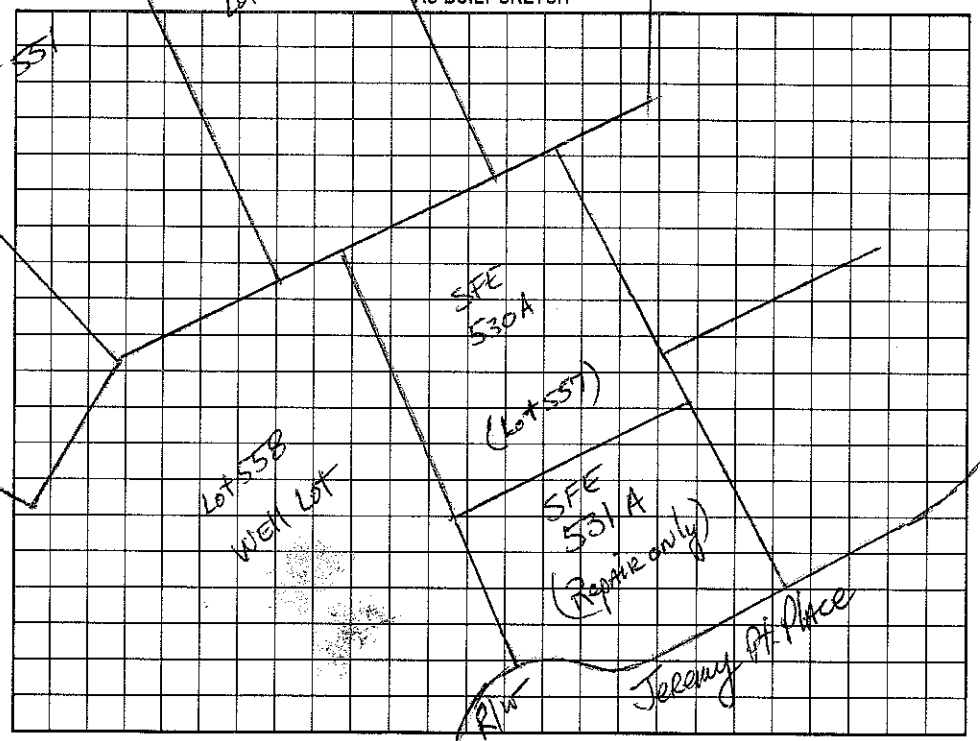

Permit can be suspended or revoked if any false information is supplied toward securing the permit/any unauthorized changes are made to the site/any unauthorized changes are made in the installation of the system. Improvement Permit with ~~plat valid~~ without expiration. Improvement Permit with site plan valid for sixty months. Authorization to Construct is valid for a period equal to that of Improvement Permit – not to exceed sixty months.

Signed: [signature] date 9-24-99

Improvement Permit by: Wade R. Hamm, RS date 9-22-99

Authorization to Construct by: Wade R. Hamm, RS date 3-7-2000

Installed by: Stanley Septic

Operation Permit by: Wesley Sparks RS. date 2/16/01

Existing System Inspection by: date

HEALTH DEPT. COPY: WHITE OWNER COPY (FINAL): YELLOW OWNER COPY (INITIAL): PINK