IREDELL COUNTY HEALTH DEPARTMENT

STATESVILLE 704-878-5305 50.00 Paid MOORESVILLE 704-664-5281

E

IMPROVEMENT PERMIT / AUTHORIZATION TO CONSTRUCT / OPERATION PERMIT / EXISTING SYSTEM INSPECTION

PERMIT# 81375 PIN# 4625 94 1684 PT 4625751249 DATE 9/24/01

OWNER OR CONTRACTOR John R. Poore Build. Inc. PHONE: Business 704-847-0496 Home

ADDRESS PO Box 1437 Matthews, NC 28106 # 104

LOCATION Brawley Sch, R Polo's, L Jeremy Pt, R Brick Kiln, L Union Chapel, L Wescoe on Corner

SUBDIVISION The Point BLOCK / SECTION 5 LOT 145 LOT AREA 42,156 ft² SITE CLASS. AS DESIGN FLOW 660 L.T.A.R. 0.3

Septic Tank: 1500 Gallons; STB 338 Date 12-8-03

Pump Tank: 1500 Gallons; PT 421 Date 8-9-03

Pump Make: Model Serial No.

Nitrification Field: No Fields 1 Square Feet 1500 Linear Feet 500

No Lines 5 @ 100' Trench Width 36" Max Trench Bottom Depth 36" Gravel Depth —

☒ New System ☐ Repair System Type: I, II, (III), IV, V, VI

System Description: Pump 25% Reduction

Repair System Description: Same

Maintenance Agreement Required: ☐ Yes ☒ No

☒ House/Mod. Home ☐ Mobile Home ☐ Business ☐ Other

No. Bedrooms 5 No. Bathrooms 5 No. Employees


☐ Slab ☐ Crawl Space ☒ Basement w/plumbing ☐ Basement wo/plumbing

Water Supply: ☐ Individual ☐ Public ☒ Community


Comments:/Conditions:

Comments:/Conditions: Checked drain lines 1/8/04
EZ Flow installed
Checked tanks 1/13/04

INITIAL SITE SKETCH 1" = 50'

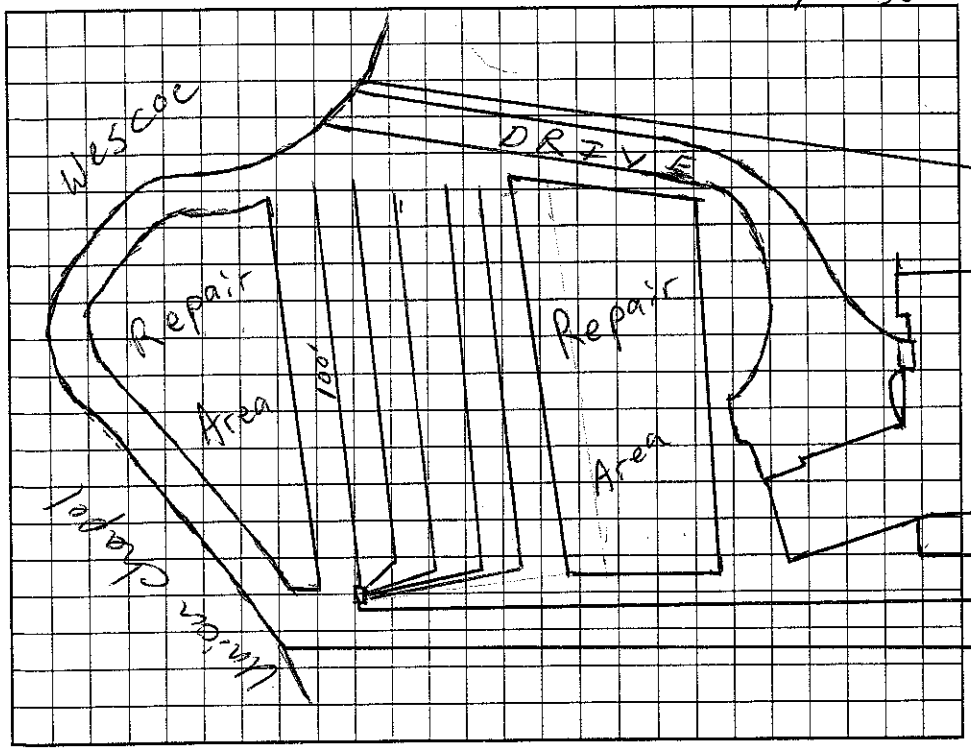

AS BUILT SKETCH

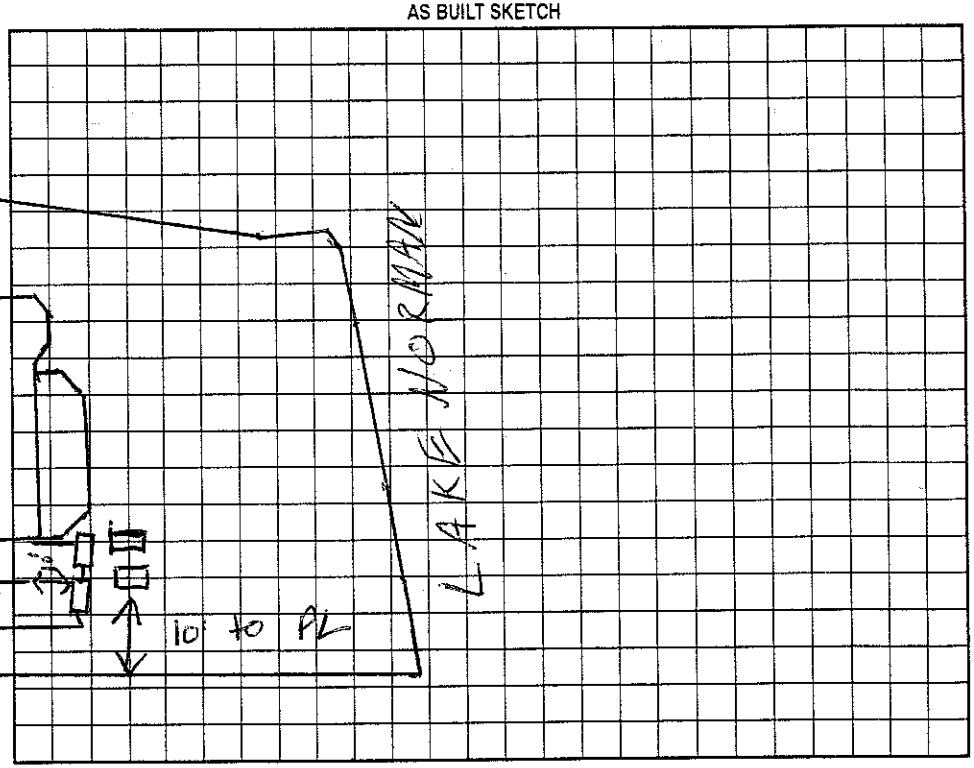

Permit can be suspended or revoked if any false information is supplied toward securing the permit/any unauthorized changes are made to the site/any unauthorized changes are made in the installation of the system. Improvement Permit with plat valid without expiration. Improvement Permit with site plan valid for sixty months. Authorization to Construct is valid for a period equal to that of Improvement Permit – not to exceed sixty months.

Signed: Debra Patto date 9-27-01

Improvement Permit by: RSF date 9/24/01

Authorization to Construct by: RSF date 9/24/01

Installed by: R.H. RS

Operation Permit by: date 2/17

Existing System Inspection by: date

HEALTH DEPT. COPY: WHITE OWNER COPY (FINAL): YELLOW OWNER COPY (INITIAL): PINK