IREDELL COUNTY HEALTH DEPARTMENT

550.00

STATESVILLE 704-878-5305 MOORESVILLE 704-664-5281

IMPROVEMENT PERMIT / AUTHORIZATION TO CONSTRUCT / OPERATION PERMIT / EXISTING SYSTEM INSPECTION

PERMIT# 1409320 PIN# 4625751728

OWNER OR APPLICANT Kingswood Custom Homes DATE 3/7/07

ADDRESS 8033 Corp Centers Dr. PHONE: Business Home

LOCATION Krawley Sch Rd @ at Traffic Cr, L on Jeremy Pt, R Brick Run Lane L Union Chapel

SUBDIVISION POINT BLOCK / SECTION 5 LOT 530 LOT AREA SITE CLASS. P3 DESIGN FLOW 480 gpd L.T.A.R. .25 (Septic Easement)

Septic Tank: 1000+ Gallons: STB 338 Date 7/21/07

Pump Tank: 1000+ Gallons: PT 27 Date 2/6/07

Pump Make: Gould 1.5 Model WE1512HV Serial No. 8078833

Nitrification Field: No Fields 1 Square Feet 1440 Linear Feet 480

No Lines 4@120' Trench Width 36" Max Trench Bottom Depth 36" Gravel Depth N/A

☒ New System ☐ Repair ☐ Expansion System Type: I II III IV V VI

System Description: PM → 25% Reduction

Repair System Description: LP Panel

Maintenance Agreement Required: ☐ Yes ☒ No

☒ House/Mod. Home ☐ Mobile Home ☐ Business ☐ Other

No. Bedrooms 4 No. Persons No. Employees

Water Supply: ☐ Individual ☐ Public ☒ Community


☐ Gravity ☐ Pressure ☐ Slab ☒ Crawl Space ☐ Basement w/plumbing ☐ Basement wo/plumbing

Comments:/Conditions:

Comments:/Conditions: Electrical Alarm checked 10/29/07 A.C.

1"=100'

INITIAL SITE SKETCH

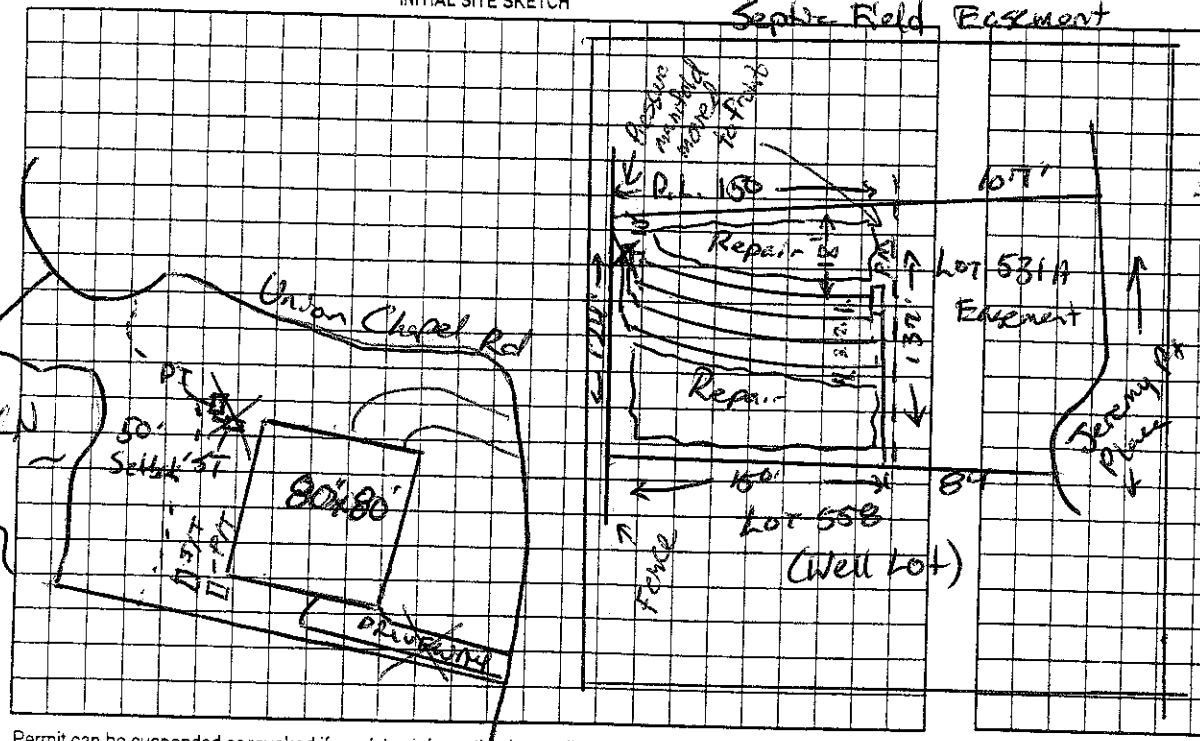

AS BUILT SKETCH

*EZ Flow 1203ft installed. Tanks and Driveway switched from original permit.

*Pressure manifold moved to front of lines ≈18' from P/L

Line elevations

1 120' = ~~10'5½~~, 10' 8", 8'11, 8'11

2 120' = ~~10'4~~ 9'2, 9'2½, 9'2

3 120' = 9'10, 9'10½ 9'11

4 120' = 10'5½, 10'4, 10'5¼

Permit can be suspended or revoked if any false information is supplied toward securing the permit/any unauthorized changes are made to the site/any unauthorized changes are made in the installation of the system. Improvement Permit with plat valid without expiration ☐ Improvement Permit with site plan valid for sixty months ☒ Authorization to Construct is valid for a period equal to that of Improvement Permit – not to exceed sixty months.

Signed: date 3/7/07 Installed by: Kevin Hallman

Improvement Permit by: date 3/7/07 Operation Permit by: Anthony Coker Jr. date 10/29/07

Authorization to Construct by: date 3/7/07 Existing System Inspection by: date

HEALTH DEPT. COPY: WHITE OWNER COPY (FINAL): YELLOW OWNER COPY (INITIAL): PINK