IREDELL COUNTY HEALTH DEPARTMENT

122347

STATESVILLE 704-878-5305 245.00 Paid MOORESVILLE 704-664-5281

IMPROVEMENT PERMIT / AUTHORIZATION TO CONSTRUCT / OPERATION PERMIT / EXISTING SYSTEM INSPECTION

PERMIT# 081377 PIN# 4625 94 1684 4625-75-4233 DATE 6/23/04

OWNER OR CONTRACTOR Kenneth Beaver Homes PHONE: Business 704-662-6400 Home

ADDRESS PO Box 3398 Mooresville, NC. 28117

LOCATION 1100 TR Polaris TL Jeremy Pt. TR Brick Kiln Tr Union Chapel Tr Wescott Ct. on R

SUBDIVISION Point BLOCK / SECTION 5 LOT 547 LOT AREA 5c 242 Ft² SITE CLASS. PS DESIGN FLOW 720 L.T.A.R. c3

Septic Tank: 1500 Gallons; STB 338 Date 10-20-04
Pump Tank: 1500 Gallons; PT 477 Date 2-5-05
Pump Make: Model Serial No.
Nitrification Field: No Fields 1 Square Feet 800/1200 Linear Feet 400
No Lines 4@100 Trench Width 2-3 Max Trench Bottom Depth 3' Gravel Depth N/A

☒ New System ☐ Repair System Type: I, II, III, ⓘ, V, VI
System Description: Pres Dosed - 16" PPBPS
Repair System Description: Same
Maintenance Agreement Required: ☒ Yes ☐ No


☒ House/Mod. Home No. Bedrooms 6
☐ Mobile Home No. Bathrooms 5
☐ Business No. Employees
☐ Other
☐ Slab ☐ Crawl Space ☒ Basement w/plumbing ☐ Basement wo/plumbing

Water Supply:
☐ Individual
☐ Public
☒ Community
CL+T


Comments:/Conditions:

Comments:/Conditions: Checked lines 11/6/05
Checked tanks 6/6/05
Pressure, elect & alarm 11/16/05

INITIAL SITE SKETCH (1" = 50')

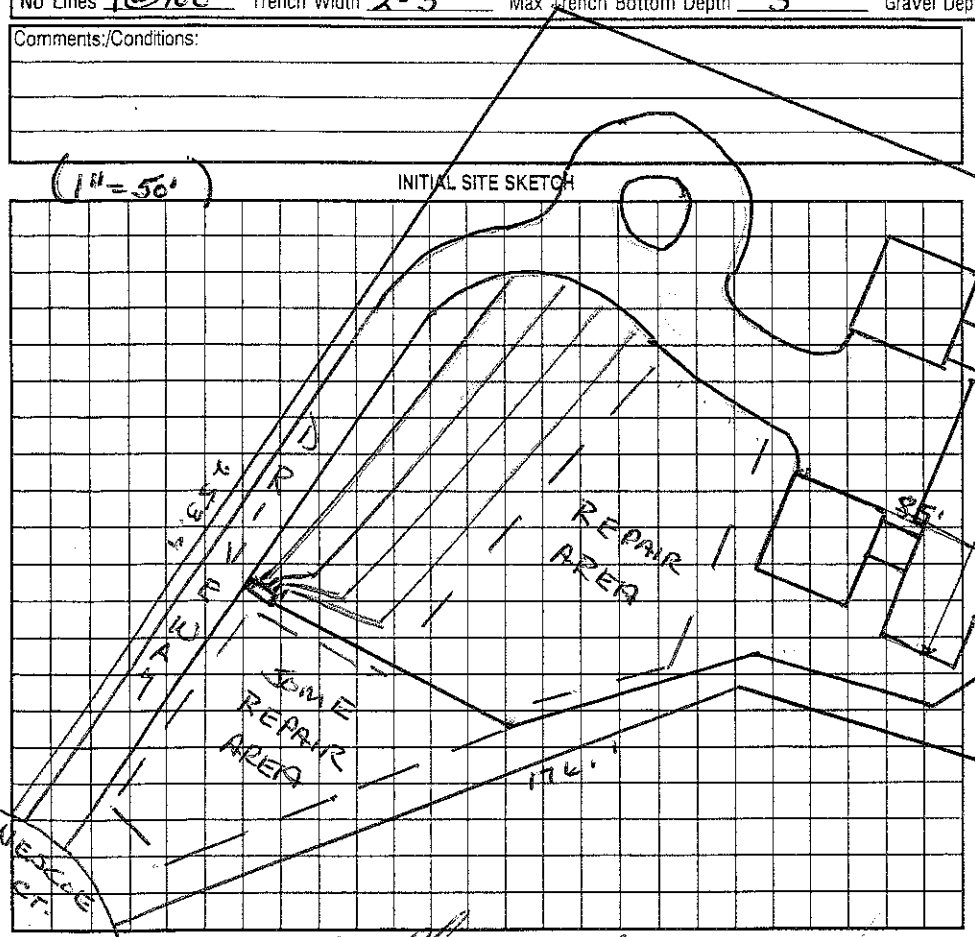

AS BUILT SKETCH

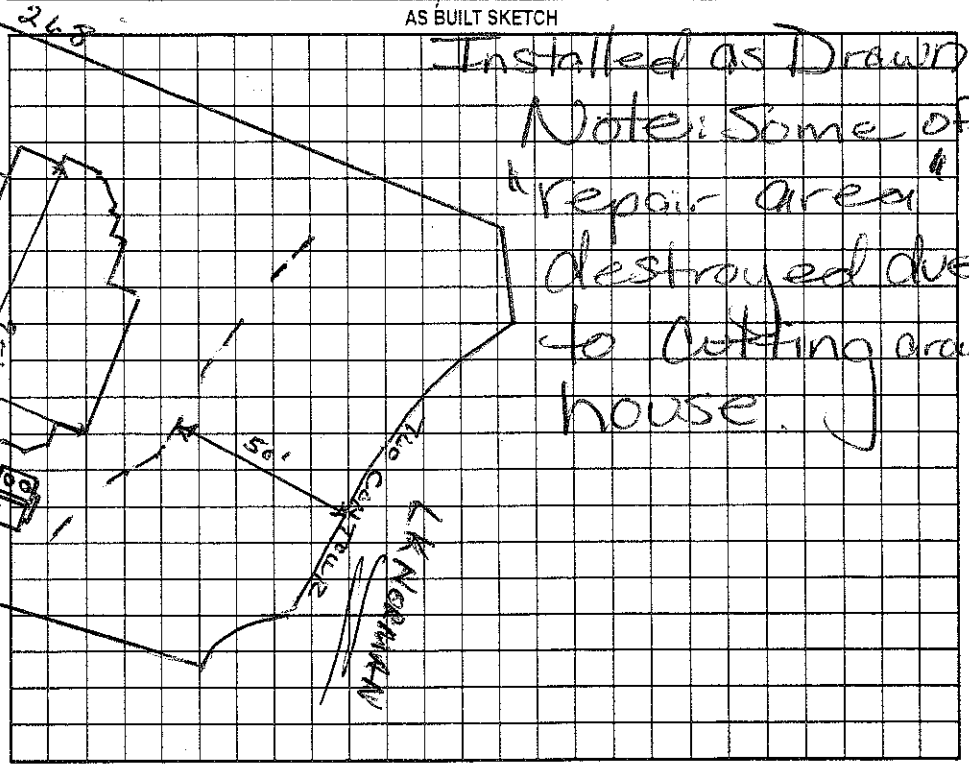

Installed as Drawn
Note: Some of "repair area" destroyed due to cutting around house.

Permit can be suspended or revoked if any false information is supplied toward securing the permit/any unauthorized changes are made to the site/any unauthorized changes are made in the installation of the system. Improvement Permit with plat valid without expiration. Improvement Permit with site plan valid for sixty months. Authorization to Construct is valid for a period equal to that of Improvement Permit – not to exceed sixty months.

Signed: [signature] date 6/24/04 Installed by: R&H RS

Improvement Permit by: Wesley Sparks R.S. date 6/23/04 Operation Permit by: [signature] date 11/16/05

Authorization to Construct by: Wesley Sparks RS date 6/23/04 Existing System Inspection by: date

HEALTH DEPT. COPY: WHITE OWNER COPY (FINAL): YELLOW OWNER COPY (INITIAL): PINK