4625754414

EDELL COUNTY HEALTH DEPARTMENT

STATESVILLE 704-878-5305 MOORESVILLE 704-664-5281

IMPROVEMENT PERMIT / AUTHORIZATION TO CONSTRUCT / OPERATION PERMIT / EXISTING SYSTEM INSPECTION

PERMIT# 08137813506 4 PIN# ~~4655 94 1589~~ DATE 11/1/06

OWNER OR APPLICANT Dibble Custom Homes PHONE: Business 764-791-1688 Home

ADDRESS PO Box 4717 Mooresville, NC 28117

LOCATION 107 Wescoe Ct. Brawley Sch Rd TR Polaris (at circle)

SUBDIVISION Point BLOCK / SECTION 5 LOT 548 LOT AREA .85Ac SITE CLASS PS DESIGN FLOW 480 L.T.A.R. .93

Septic Tank: 1500 Gallons; STB 444 Date 9/23/06
Pump Tank: 1000 Gallons; PT 282 Date 6/24/06
Pump Make: Gould's Model WJ20-511 Serial No.
Nitrification Field: No Fields 1 Square Feet 1200 Linear Feet 400
No Lines 5@80' Trench Width 3 Max Trench Bottom Depth 3'

[X] New System [ ] Repair [ ] Expansion System Type: I II [III] IV V VI
System Description: PM - 2590 Reduced.
Repair System Description: LP - 16" PPBPS
Maintenance Agreement Required: [ ] Yes [X] No

[X] House/Mod. Home No. Bedrooms 4
[ ] Mobile Home No. Persons
[ ] Business No. Employees
[ ] Other


Water Supply: [ ] Individual [X] Public [X] Community

Gravel Depth No [ ] Gravity [X] Pressure [ ] Slab [X] Crawl Space [ ] Basement w/plumbing [ ] Basement wo/plumbing

Comments:/Conditions:


1" = 50'

INITIAL SITE SKETCH

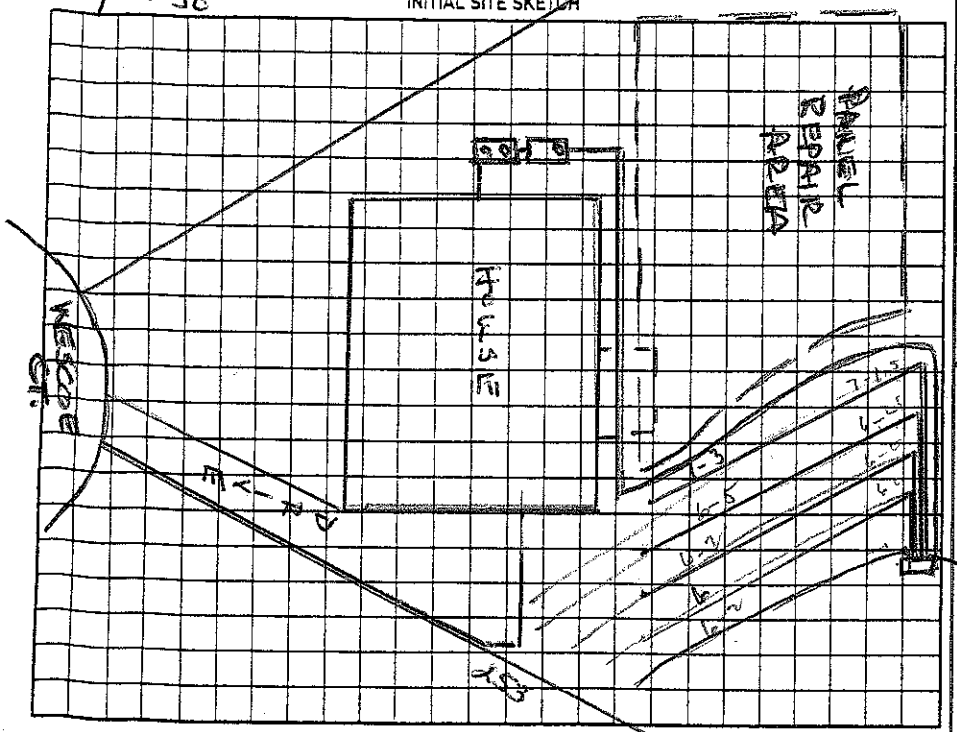

Comments:/Conditions:

AS BUILT SKETCH

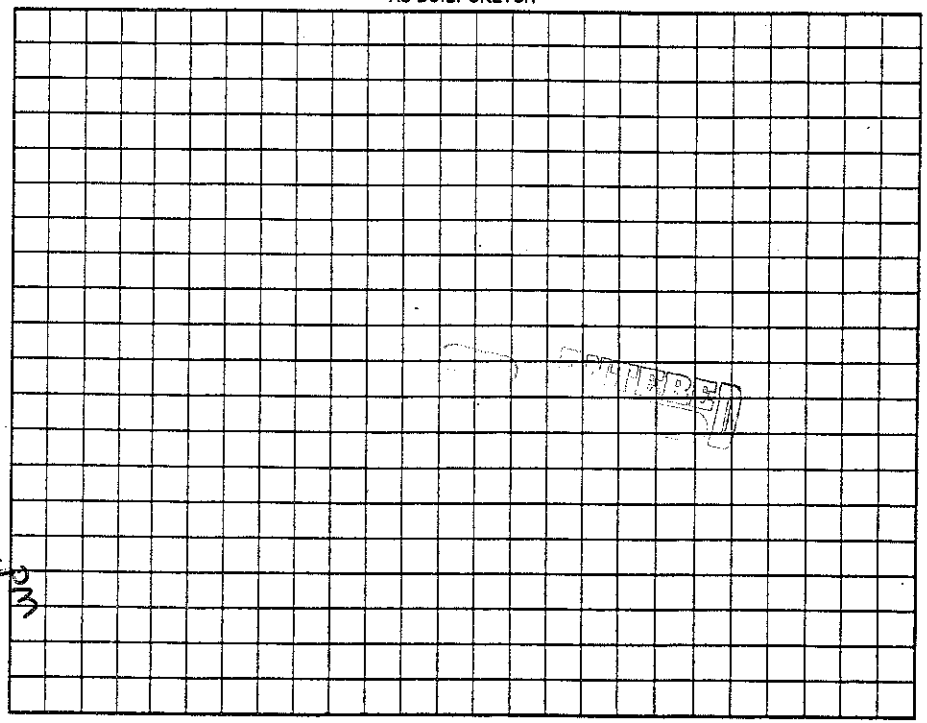

Permit can be suspended or revoked if any false information is supplied toward securing the permit/any unauthorized changes are made to the site/any unauthorized changes are made in the installation of the system. Improvement Permit with plat valid without expiration [ ] Improvement Permit with site plan valid for sixty months [ ]

Signed: X date

Improvement Permit by: Wesley Sparks RS. date 11/1/06

Authorization to Construct by: Wesley Sparks RS. date 11/1/06

Installed by: Orbison + Sons.

Operation Permit by: Wesley Sparks RS. date 11/2/06

Existing System Inspection by: date

HEALTH DEPT. COPY: WHITE OWNER COPY (FINAL): YELLOW OWNER COPY (INITIAL): PINK