IREDELL COUNTY HEALTH DEPARTMENT

Statesville Office (704) 878-5305 Mooresville Office (704) 660-3625 PERMIT # 200162

IMPROVEMENT PERMIT / AUTHORIZATION TO CONSTRUCT / OPERATION PERMIT / EXISTING SYSTEM

PIN # 4625-75-4414

APPLICANT: RICHARD CARR APPLICANT ADDRESS: 7209 HARRIS BLVD CLT

SITE ADDRESS: 107 WESCOE CT PHONE: 704-363-9999 ALT. PHONE:

SITE DIRECTIONS: BSR, TR POLPIS, TL JEREMY POINT, TR BRICK KILN, TL UNION CHAPEL, TL WISCOE

SUBDIVISION: THE POINT SECTION: 5 LOT # 548 LOT AREA: .853 AC DESIGN FLOW: 480 L.T.A.R.: .3

Septic Tank 1500 (gal) STB 444 Date 9-23-06
Pump Tank 1000 (gal) PT 282 Date 10-24-06
Pump Make GOULDS Model W150 Serial #
Nitrification Fields 1 # Lines 5@80' Linear Ft: 400'
Trench Width 36" Max. Trench Bottom Depth 36" Gravel Depth


☐ New System ☐ Repair ☐ Expansion System Type: I II (III)B IV V VI
System Description: PM - 25% RED.
Repair System Description: PANEL BLOCK
Maintenance Agreement Required: ☐ YES ☒ NO
☐ GRAVITY ☒ PRESSURE

☒ Residence No. Bedrooms 4
☐ Business No. Persons
☐ Other No. Employees
☐ Slab ☒ Crawl Space
☐ Basement w/plumbing ☐ Basement w/o plumbing


Water Supply
☐ Private
☐ Public
☒ Community

Comments / Conditions:

INITIAL SITE SKETCH

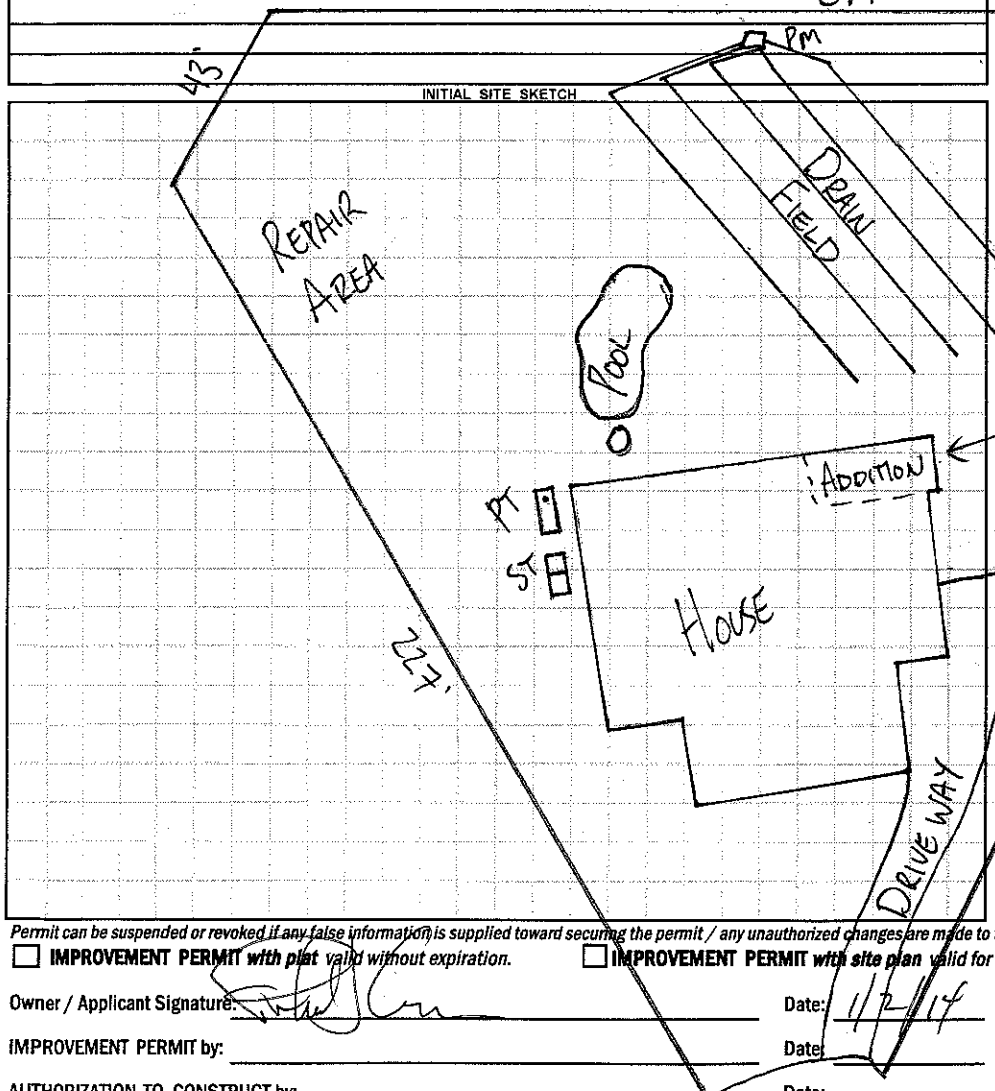

AS BUILT SKETCH

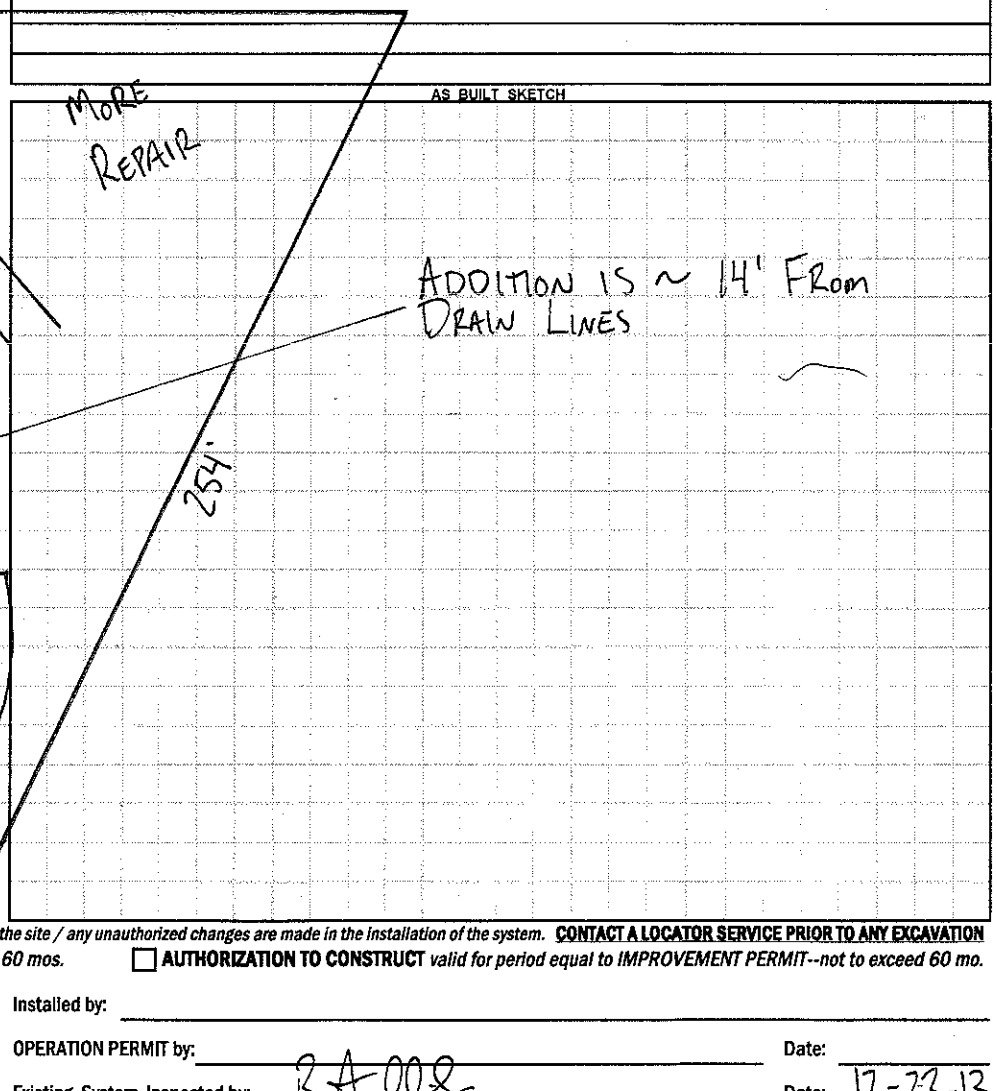

Permit can be suspended or revoked if any false information is supplied toward securing the permit / any unauthorized changes are made to the site / any unauthorized changes are made in the installation of the system. **CONTACT A LOCATOR SERVICE PRIOR TO ANY EXCAVATION**

☐ **IMPROVEMENT PERMIT** *with plat valid without expiration.* ☐ **IMPROVEMENT PERMIT** *with site plan valid for 60 mos.* ☐ **AUTHORIZATION TO CONSTRUCT** *valid for period equal to IMPROVEMENT PERMIT--not to exceed 60 mo.*

Owner / Applicant Signature: Date: 11/2/14 Installed by:

IMPROVEMENT PERMIT by: Date: OPERATION PERMIT by: Date:

AUTHORIZATION TO CONSTRUCT by: Date: Existing System Inspected by: RA Date: 12-23-13

Health Dept. Copy - WHITE Applicant (Final Approval) - YELLOW Applicant (Conditional Approval) - PINK