IREDELL COUNTY HEALTH DEPARTMENT

STATESVILLE 704-878-5305 MOORESVILLE 704-664-5281

IMPROVEMENT PERMIT / AUTHORIZATION TO CONSTRUCT / OPERATION PERMIT / EXISTING SYSTEM INSPECTION

PERMIT# Repair PIN# 4625-75-6832 DATE 3/17/05

OWNER OR CONTRACTOR Dennis Williams PHONE: Business _____ Home 704 799-2640

ADDRESS 133 Brick Kiln Way Mooresville NC 28117

LOCATION BSR, TR Polis, TL Jeremy Rt, TR Brick Kiln on Lt

SUBDIVISION The Point BLOCK / SECTION 5 LOT 552 LOT AREA 24,455SF SITE CLASS. PS DESIGN FLOW 450 L.T.A.R. 0.3

Septic Tank: Existing Gallons; ST8 _____ Date _____

Pump Tank: Existing Gallons; PT _____ Date _____

Pump Make: _____ Model _____ Serial No. _____

Nitrification Field: No Fields 1 Square Feet 1200 Linear Feet 400

No Lines 6 Trench Width 36" Max Trench Bottom Depth 36" Gravel Depth —

☐ New System ☒ Repair System Type: I, II, III, (IV), V, VI

System Description: PM 25% Reduction

Repair System Description: LP 25% Reduction

Maintenance Agreement Required: ☒ Yes ☐ No

☒ House/Mod. Home No. Bedrooms 4

☐ Mobile Home No. Bathrooms ____

☐ Business No. Employees ____

☐ Other _____

☐ Slab ☒ Crawl Space ☐ Basement w/plumbing ☐ Basement wo/plumbing


Water Supply: ☐ Individual ☐ Public ☒ Community

Comments:/Conditions:


1"=40'

Comments:/Conditions:

INITIAL SITE SKETCH

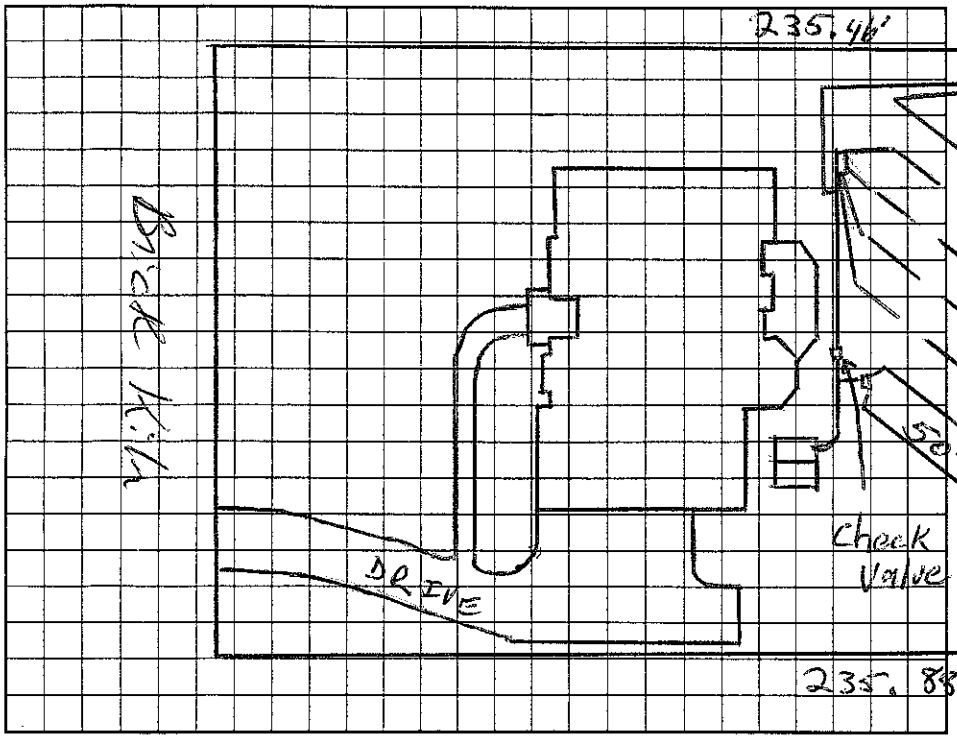

AS BUILT SKETCH

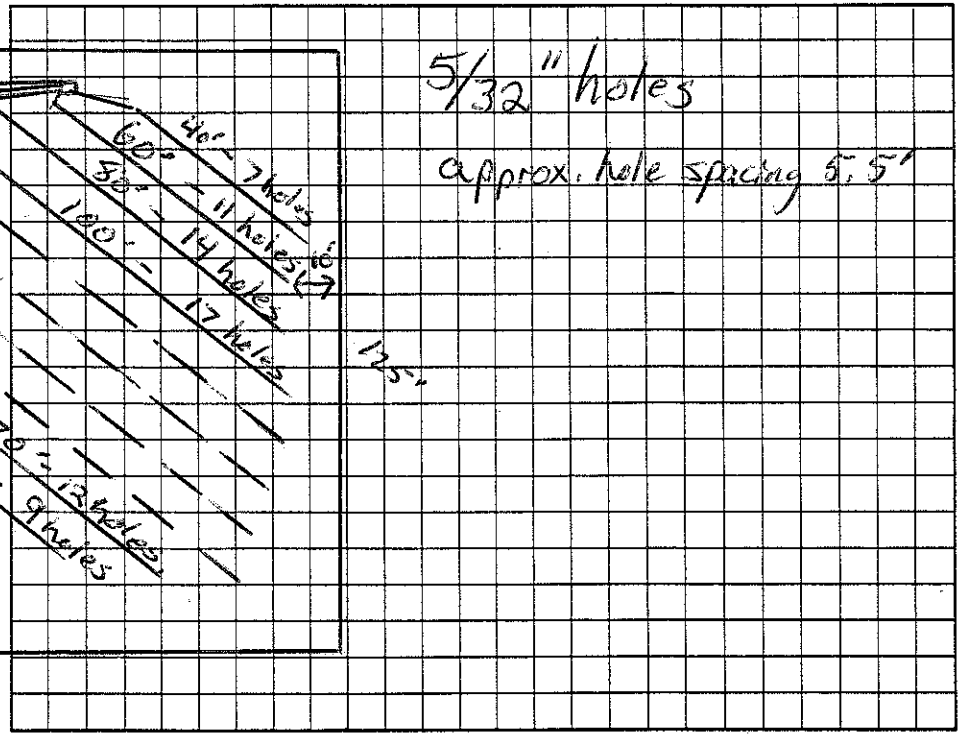

Permit can be suspended or revoked if any false information is supplied toward securing the permit/any unauthorized changes are made to the site/any unauthorized changes are made in the installation of the system. Improvement Permit with plat valid without expiration. Improvement Permit with site plan valid for sixty months. Authorization to Construct is valid for a period equal to that of Improvement Permit – not to exceed sixty months.

Signed: _____ date 3/22/05 Installed by: R+H

Improvement Permit by: _____ date 3/17/05 Operation Permit by: _____ date 11/9/05

Authorization to Construct by: _____ date 3/17/05 Existing System Inspection by: _____ date _____

HEALTH DEPT. COPY: WHITE OWNER COPY (FINAL): YELLOW OWNER COPY (INITIAL): PINK