IREDELL COUNTY HEALTH DEPARTMENT

STATESVILLE 704-878-5305 $125 MOORESVILLE 704-664-5021 3:30

IMPROVEMENT PERMIT / AUTHORIZATION TO CONSTRUCT / OPERATION PERMIT / EXISTING SYSTEM INSPECTION

PERMIT# 08/388 PIN# ~~4625741684 (pt)~~ GM Helms 4625756832 DATE Sept. 9, '99

OWNER OR CONTRACTOR Crescent Resources, Inc. // The Point on Norman PHONE: Business 660-1185 Home

ADDRESS 2214 Brawley Sch Rd. Mooresville

LOCATION Brawley Sch Rd. TR Polpis TL Jeremy Pt. TR Brick Kiln on left

SUBDIVISION The Point BLOCK / SECTION 5 LOT 552 LOT AREA 29,455 ft² SITE CLASS. PS DESIGN FLOW 480gpd L.T.A.R. .03

Septic Tank: ~~1000~~ 1500 Gallons; STB 338 Date 11-14-00

Pump Tank: 1000 Gallons; PT 283 Date 9-26-00

Pump Make: ME3F Model Serial No.

Nitrification Field: No Fields 1 Square Feet 1200 Linear Feet 400

No Lines 4 @ 100' Trench Width 36" Trench Bottom Depth 36" Gravel Depth NA

1/3

☑ New System ☐ Repair System Type: I, II, ☑ IV, V, VI

System Description: PM - INNOVATIVE - 25% Reduction

Repair System Description: LP Panel Block

Maintenance Agreement Required: ☐ Yes ☑ No Initially

☑ House/Mod. Home No. Bedrooms 4

☐ Mobile Home No. Bathrooms 4

☐ Business No. Employees

☐ Other

☑ Slab ☑ Crawl Space ☐ Basement w/plumbing ☐ Basement wo/plumbing


Water Supply: ☐ Individual ☑ Public ☑ Community

Comments/Conditions: Plans reviewed - Driveway change 8/18/00 - GM

Comments/Conditions: E.Z Flow Installed

INITIAL SITE SKETCH

1" = 50'

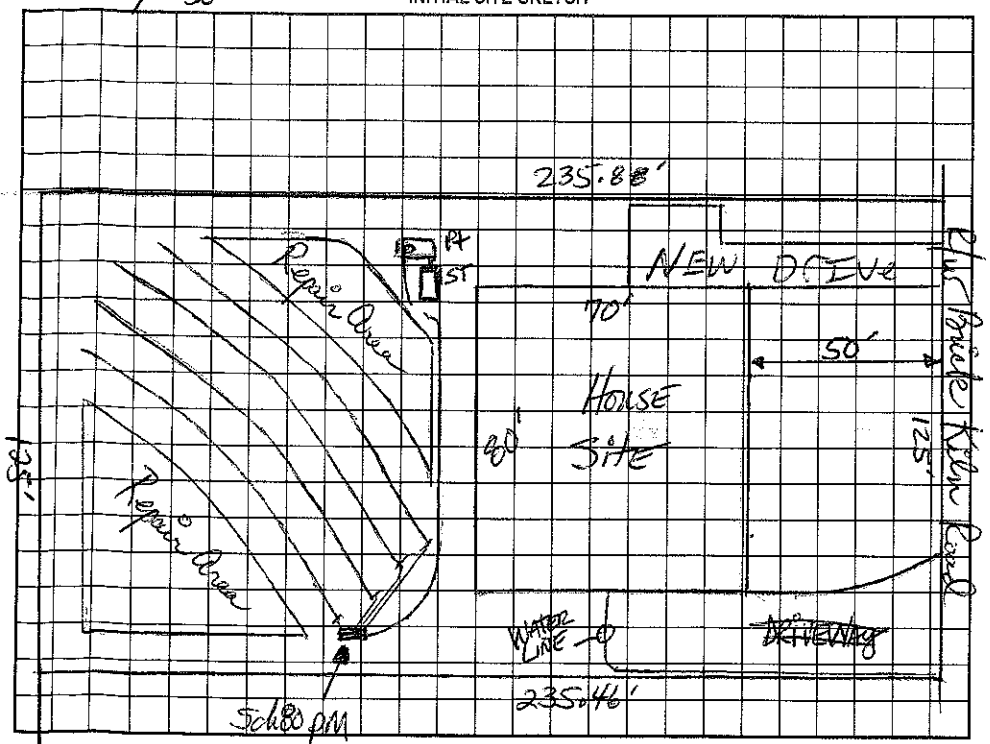

AS BUILT SKETCH

Permit can be suspended or revoked if any false information is supplied toward securing the permit/any unauthorized changes are made to the site/any unauthorized changes are made in the installation of the system. Improvement Permit with plat valid without expiration. Improvement Permit with site plan valid for sixty months. Authorization to Construct is valid for a period equal to that of Improvement Permit – not to exceed sixty months.

Signed: PGC date 9-10-99

Improvement Permit by: [illegible], RS date 9-9-99

Authorization to Construct by: [illegible] EST date 8/18/00

Installed by: R & H Inc

Operation Permit by: [illegible] RS date 3/12/2001

Existing System Inspection by: date

HEALTH DEPT. COPY: WHITE OWNER COPY (FINAL): YELLOW OWNER COPY (INITIAL): PINK