121175 4625-75-7159 5000

IREDELL COUNTY HEALTH DEPARTMENT

STATESVILLE 704-878-5305 MOORESVILLE 704-664-5281

IMPROVEMENT PERMIT / AUTHORIZATION TO CONSTRUCT / OPERATION PERMIT / EXISTING SYSTEM INSPECTION

PERMIT# ~~08~~1395 121175 PIN# 4625947684 Cell ~~Office~~ DATE 4-14-05

OWNER OR CONTRACTOR Tom Stevenson Builders PHONE: Business 201-7270 ~~Home~~ 660-6638

ADDRESS 570 Williamson Rd Suite E Mooresville, NC 28117

LOCATION Brawley School Rd R Pelpis TL Jeremy Pt at end

SUBDIVISION The Point BLOCK / SECTION 5 LOT 561 LOT AREA 64,953 ft² SITE CLASS. BS DESIGN FLOW 480 gpd L.T.A.R. .3 +

Septic Tank: 1000 Gallons; STB 338 Date 2-10-05
Pump Tank: 1000+ Gallons; PT 283 Date 2-14-05
Pump Make: Myers Model ME50 Serial No.
Nitrification Field: No fields 1 Square Feet 900 Linear Feet 300
No Lines 4 Trench Width 36" Max Trench Bottom Depth 36" Gravel Depth N/A

☒ New System ☐ Repair System Type: I, II, III, IV, V, VI
System Description: LPP Pined Blk
Repair System Description: Same
Maintenance Agreement Required: ☒ Yes ☐ No


☒ House/Mod. Home No. Bedrooms 4
☐ Mobile Home No. Bathrooms 4
☐ Business No. Employees
☐ Other
☐ Slab ☐ Crawl Space ☒ Basement w/plumbing ☐ Basement wo/plumbing

Water Supply: ☐ Individual ☒ Public ☒ Community


Comments/Conditions: Scale 1:50
* Permit redrawn due to change in driveway.

Comments/Conditions: Already installed tanks & lines & inspected 1/21/05 mt
Pressure, Elect & alarm 9/22/05

INITIAL SITE SKETCH

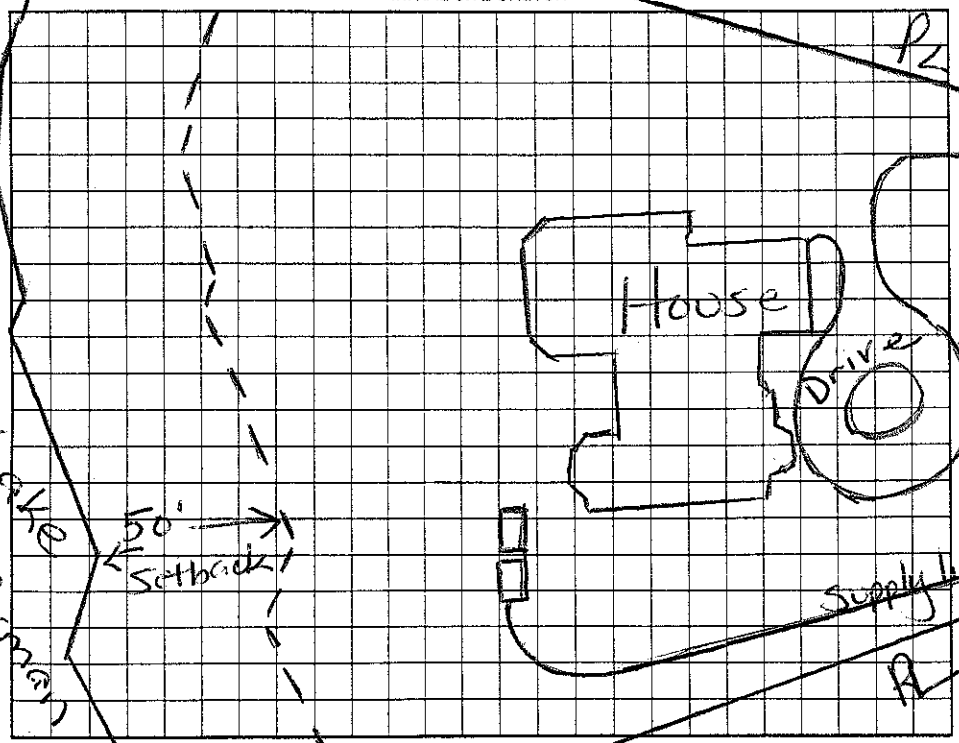

AS BUILT SKETCH

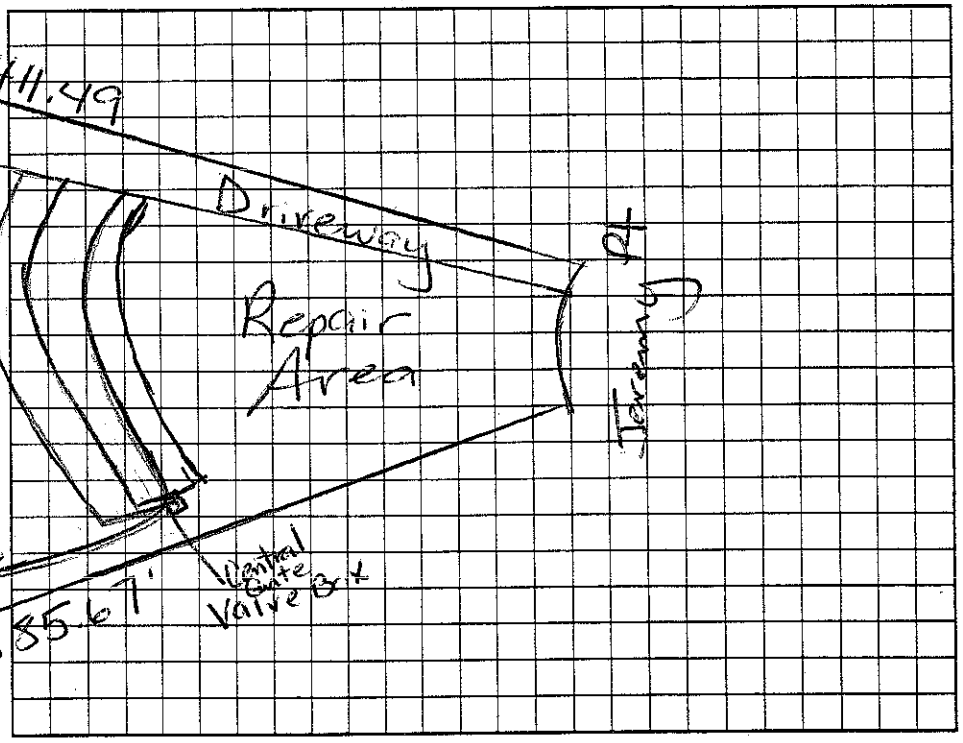

Permit can be suspended or revoked if any false information is supplied toward securing the permit/any unauthorized changes are made to the site/any unauthorized changes are made in the installation of the system. Improvement Permit with plat valid without expiration. Improvement Permit with site plan valid for sixty months. Authorization to Construct is valid for a period equal to that of Improvement Permit – not to exceed sixty months.

Signed: Ashley West date 4.15.05 Installed by: R&H RS

Improvement Permit by: Maria H Dolan RS date 4/14/05 Operation Permit by: Maria H Dolan date 9/22/05

Authorization to Construct by: Maria H Dolan RS date 4/14/05 Existing System Inspection by: date

HEALTH DEPT. COPY: WHITE OWNER COPY (FINAL): YELLOW OWNER COPY (INITIAL): PINK