$325

IREDELL COUNTY HEALTH DEPARTMENT

STATESVILLE 704-878-5305 MOORESVILLE 704-664-5281

IMPROVEMENT PERMIT / AUTHORIZATION TO CONSTRUCT / OPERATION PERMIT / EXISTING SYSTEM INSPECTIO

PERMIT# 081396 PIN# 4625944684 (pt.) (SIMONINI BUILDERS) 4625-75-8294 DATE Sept 9, '99

OWNER OR CONTRACTOR Crescent Resources Inc. / The Point on Norman PHONE: Business 660-1185 Home

ADDRESS 2214 Brawley School Rd. Mooresville #137

LOCATION Brawley School Rd. TR Polpis TL Jeremy Point Place at end on left

SUBDIVISION The Point BLOCK / SECTION 5 LOT 562 LOT AREA 52,906 ft² SITE CLASS. BS DESIGN FLOW 480gpd L.T.A.R. ~.25

Septic Tank: ~~1000+150~~ Gallons; STB 338 Date 10-29-03

Pump Tank: 1000 Gallons; PT 27 Date 1-5-04

Pump Make: Model Serial No.

Nitrification Field: No. Fields 1 Square Feet 1080 Linear Feet 360

No Lines 5 Trench Width 36" Max Trench Bottom Depth 36" Gravel Depth NA

☑ New System ☐ Repair System Type: I, II, III, ⓘ V, VI

System Description: LP PANEL Block

Repair System Description: SAME

Maintenance Agreement Required: ☑ Yes ☐ No

☑ House/Mod. Home No. Bedrooms 4

☐ Mobile Home No. Bathrooms 4

☐ Business No. Employees

☐ Other

☑ Slab ☑ Crawl Space ☑ Basement w/plumbing ☐ Basement wo/plumbing

Water Supply: ☐ Individual ☑ Public ☑ Community

Comments:/Conditions:


Comments:/Conditions: (prefinal) Checked lines 2/11/04

Installed 5 lines @ 72' each


*Drive on other side (per submitted plan)

3/16" hole drilled

INITIAL SITE SKETCH 1"=50'

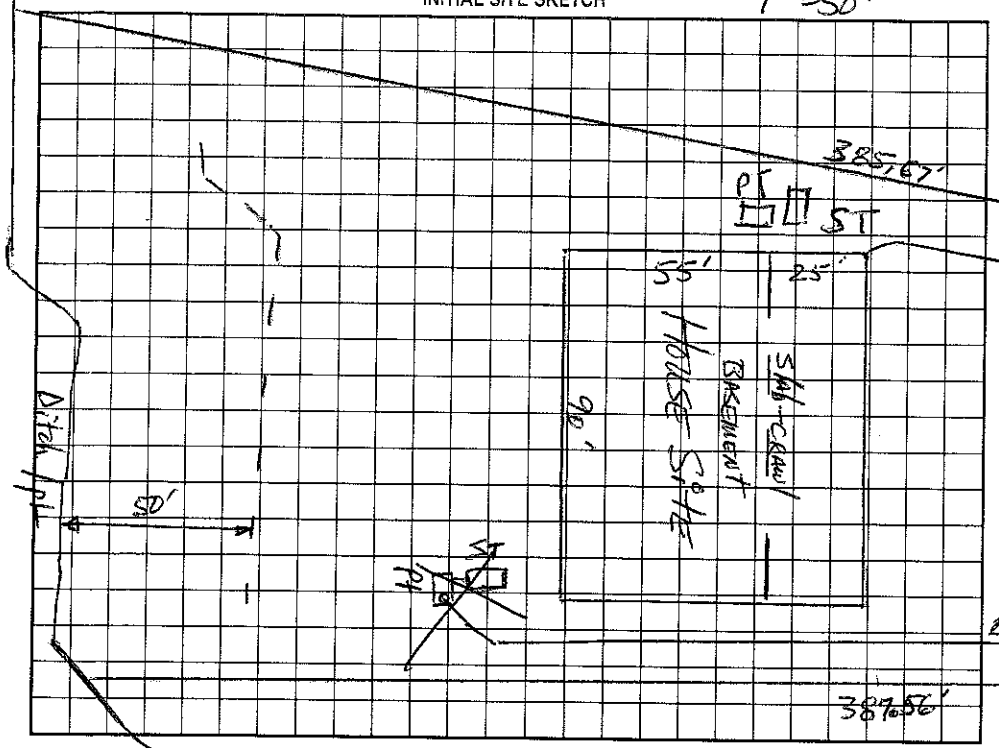

AS BUILT SKETCH

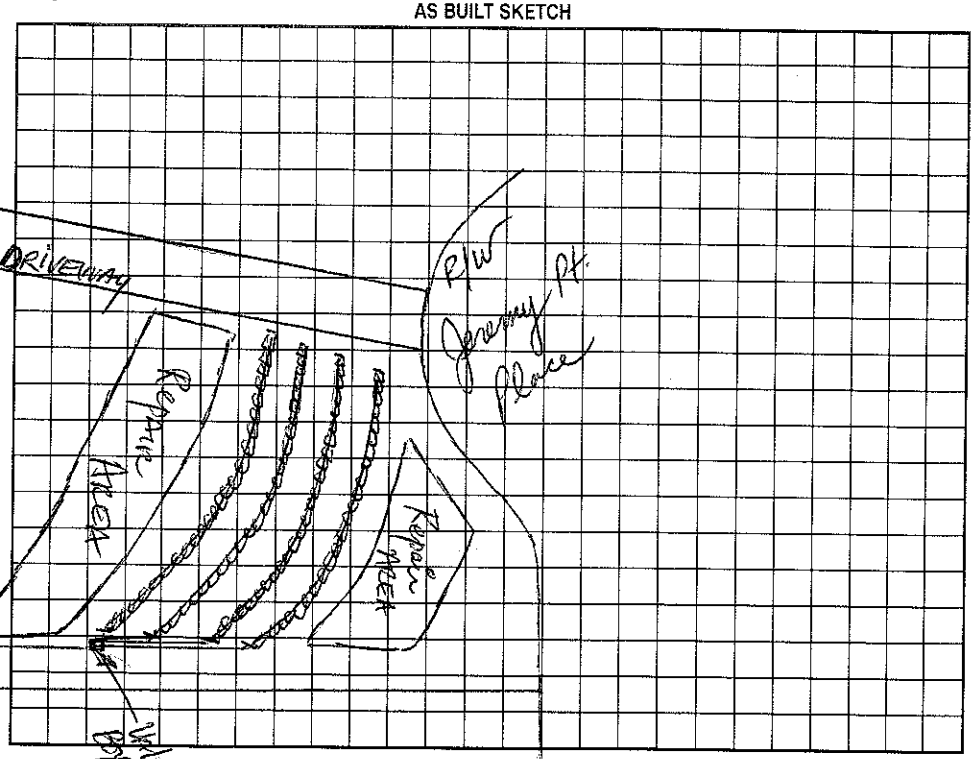

Permit can be suspended or revoked if any false information is supplied toward securing the permit/any unauthorized changes are made to the site/any unauthorized changes are made in the installation of the system. Improvement Permit with plat valid without expiration. Improvement Permit with site plan valid for sixty months. Authorization to Construct is valid for a period equal to that of Improvement Permit – not to exceed sixty months.

Signed: date 9-10-99

Improvement Permit by: date 9-9-99

Authorization to Construct by: date 5/6/03

Installed by: R & H Inc

Operation Permit by: date 4/15/04

Existing System Inspection by: date

HEALTH DEPT. COPY: WHITE OWNER COPY (FINAL): YELLOW OWNER COPY (INITIAL): PINK