IREDELL COUNTY HEALTH DEPARTMENT

$125

STATESVILLE 704-878-5305 MOORESVILLE 704-664-5281

IMPROVEMENT PERMIT / AUTHORIZATION TO CONSTRUCT / OPERATION PERMIT / EXISTING SYSTEM INSPECTION

PERMIT# 081390 / 28422 PIN# 4625941684 (pt.) David D. Hill 4625-75-9809 DATE Sept 9, 99

OWNER OR CONTRACTOR Crescent Resources Inc. // The Point on Norman / PHONE: Business 660-1185 Home

ADDRESS 2214 Brawley Sch Rd. Mooresville

LOCATION Brawley Sch Rd. TR Polpis TL Jeremy Pt. TR Brick Kiln on left

SUBDIVISION The Point BLOCK / SECTION 5 LOT 554 LOT AREA 34,351 ft² SITE CLASS. PS DESIGN FLOW 460gpd L.T.A.R. .025

Septic Tank: 1500 Gallons; STB 338 Date 9/24/99

Pump Tank: 1000 Gallons; PT 27 Date 9/27/04

Pump Make: Goulds Model WE0-512HH Serial No. 6/05

Nitrification Field: No Fields 1 Square Feet 1500 Linear Feet 500

No Lines 5@100' Trench Width 36" Trench Bottom Depth 36"

☑ New System ☐ Repair System Type: I, II, (III) IV, V, VI

System Description: PM - Innovative - 25% Reduction

Repair System Description: LP Innovative - 25% Red.

Maintenance Agreement Required: ☐ Yes ☑ No

Gravel Depth NA ☑ Slab ☑ Crawl Space ☐ Basement w/plumbing ☐ Basement wo/plumbing

☑ House/Mod. Home No. Bedrooms 4

☐ Mobile Home No. Bathrooms 4

☐ Business No. Employees

☐ Other


Water Supply: ☐ Individual ☑ Public ☐ Community

Comments:/Conditions: install trenches 36" to depth.
* ONE INSPECTION PORT PER LATERAL

Comments:/Conditions:

1" = 50'

INITIAL SITE SKETCH 232.3'

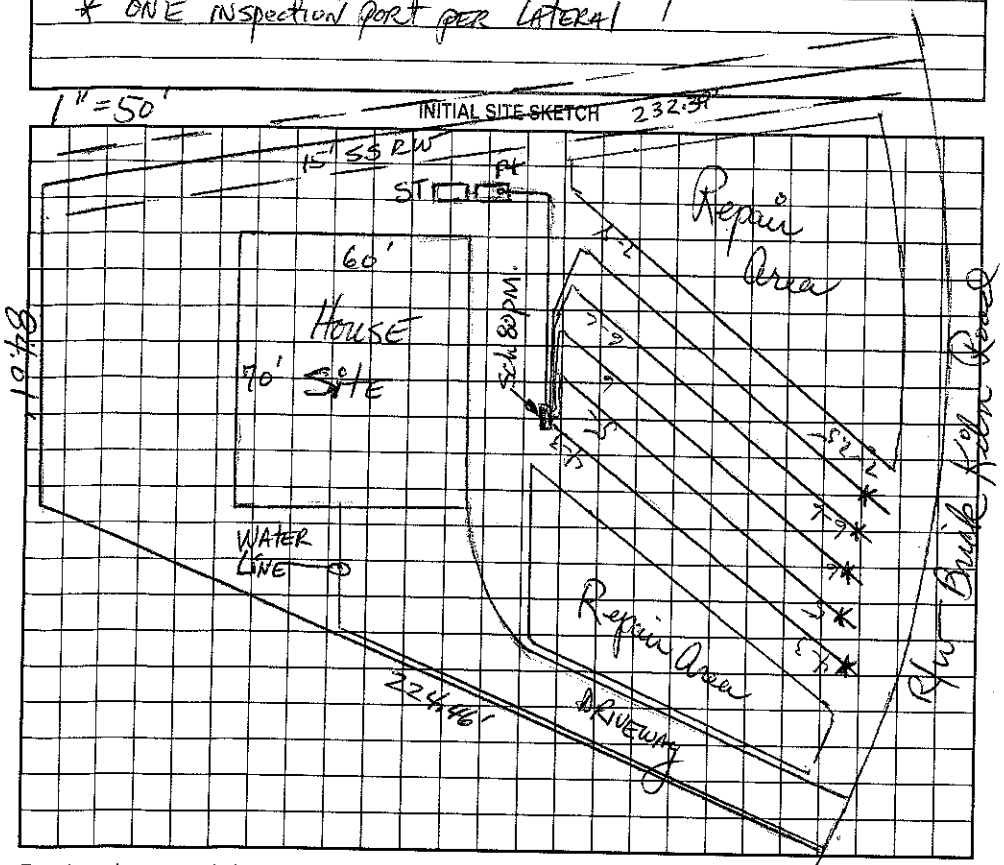

AS BUILT SKETCH

Permit can be suspended or revoked if any false information is supplied toward securing the permit/any unauthorized changes are made to the site/any unauthorized changes are made in the installation of the system. Improvement Permit with plat valid without expiration. Improvement Permit with site plan valid for sixty months. Authorization to Construct is valid for a period equal to that of Improvement Permit – not to exceed sixty months.

Signed: date 9-10-99 Installed by: G. Wayne Dalton & Sons

Improvement Permit by: RS date 9-9-99 Operation Permit by: RS date 10/18/05

Authorization to Construct by: RS date 4/29/05 Existing System Inspection by: date

HEALTH DEPT. COPY: WHITE OWNER COPY (FINAL): YELLOW OWNER COPY (INITIAL): PINK