IREDELL COUNTY HEALTH DEPARTMENT

STATESVILLE 704-878-5305 $325 MOORESVILLE 704-664-5281

IMPROVEMENT PERMIT / AUTHORIZATION TO CONSTRUCT / OPERATION PERMIT / EXISTING SYSTEM INSPECT.

PERMIT# 081257 PIN# 4625-76-1052 DATE Sept 27, '99

OWNER OR CONTRACTOR Crescent Resources dba The Point on Norman / Augusta Homes PHONE: Business 662-1185 Home

ADDRESS 2214 Brawley School Rd. Mooresville

LOCATION Brawley School Rd TR Bridges Tr Jeremy Pt. TR Brick Kiln AT/NEAR END on Right

SUBDIVISION The Point BLOCK / SECTION 5 LOT 526 LOT AREA 38,818 sf SITE CLASS. 2S DESIGN FLOW 480gpd L.T.A.R. ~.3

Septic Tank: 1000+ Gallons; STB Date

Pump Tank: 1000 Gallons; PT Date

Pump Make: Model Serial No.

Nitrification Field: No Fields 1 Square Feet 960+ Linear Feet 300+

No Lines 4 Trench Width 36" Max Trench Bottom Depth 36" Gravel Depth NA

☑ New System ☐ Repair System Type: I, II, III, IV, V, VI

System Description: LPP Partial Block

Repair System Description: Same

Maintenance Agreement Required: ☑ Yes ☐ No

☐ House/Mod. Home No. Bedrooms 4

☐ Mobile Home No. Bathrooms 4

☐ Business No. Employees

☐ Other


☑ Slab ☐ Crawl Space ☑ Basement w/plumbing ☐ Basement wo/plumbing

Water Supply: ☐ Individual ☑ Public ☑ Community

Comments:/Conditions:

Comments:/Conditions: (pre-Hall)
Plans Reviewed 7/24/02
Pool to go in where tanks are shown
Tanks need to be moved to opposite side

INITIAL SITE SKETCH 1" = 50'

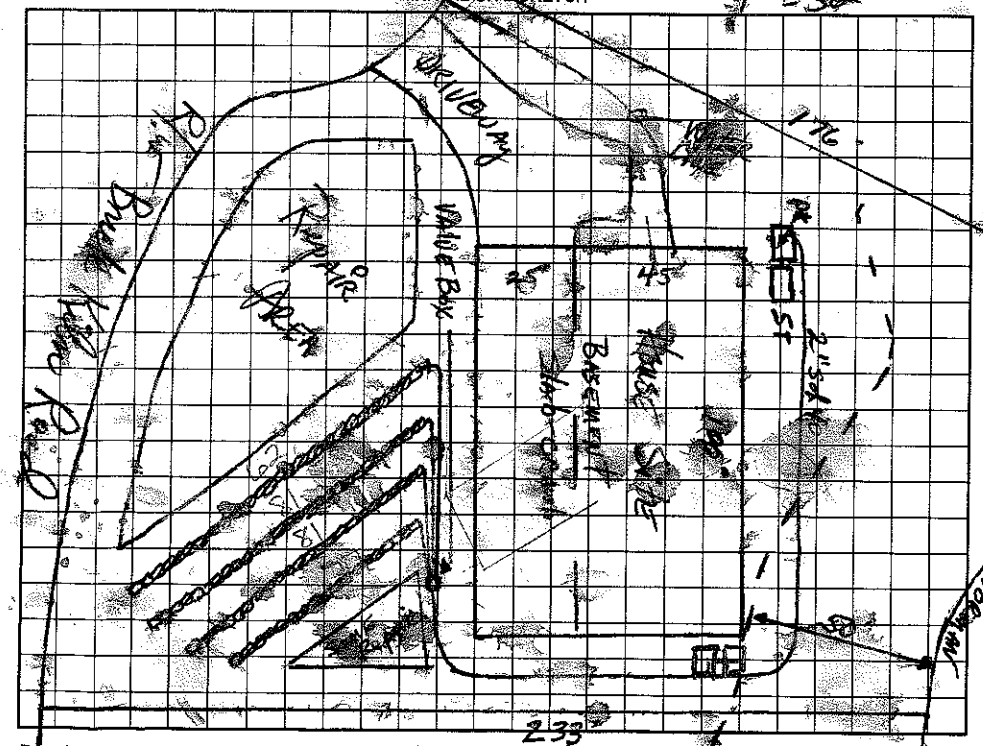

AS BUILT SKETCH

Press, elect & alarm

Permit can be suspended or revoked if any false information is supplied toward securing the permit/any unauthorized changes are made to the site/any unauthorized changes are made in the installation of the system. Improvement Permit with plat valid without ~~expiration~~. Improvement Permit with site plan valid for sixty months. Authorization to Construct is valid for a period equal to that of Improvement Permit – not to exceed sixty months.

Signed: date 9-24-99

Improvement Permit by: RS date 9-23-99

Authorization to Construct by: RS date 7/24/02

Installed by: R & H Inc

Operation Permit by: RS date 7/7/03

Existing System Inspection by: date

HEALTH DEPT. COPY: WHITE OWNER COPY (FINAL): YELLOW OWNER COPY (INITIAL): PINK