IREDELL COUNTY HEALTH DEPARTMENT

STATESVILLE 704-878-5305 MOORESVILLE 704-664-5281

IMPROVEMENT PERMIT / AUTHORIZATION TO CONSTRUCT / OPERATION PERMIT / EXISTING SYSTEM INSPECTION

2nd pm $325 (E)

PERMIT# 081256 PIN# 4625441684 (pt.) David Dibble Custom Homes A625-76-3003 DATE August 25, '99

OWNER OR CONTRACTOR Crescent Resources Dev // The Point on Norman // PHONE: Business 660-7185 Home

ADDRESS 2214 Brawley Sch Rd. Mooresville

LOCATION Brawley Sch Rd. TR Polpis TL Jeremy Point TR Brick Kiln on Right

SUBDIVISION The Point BLOCK / SECTION 5 LOT 525 LOT AREA 32,464 ft² SITE CLASS. PS DESIGN FLOW 460 gpd L.T.A.R. #025-03

Septic Tank: ~~1000~~ 1500 Gallons; STB 338 Date 4-9-01

Pump Tank: 1000 Gallons; PT ~~338~~ 327 Date 2-28-01

Pump Make: Model Serial No.

Nitrification Field: No Fields 1 Square Feet 960 Linear Feet 320

No Lines 4 Trench Width 36" Max Trench Bottom Depth 36" Gravel Depth NA

☑ New System ☐ Repair System Type: I, II, III, IV, V, VI

System Description: LP Panel Block

Repair System Description: SAME

Maintenance Agreement Required: ☑ Yes ☐ No

☑ House/Mod. Home No. Bedrooms 4

☐ Mobile Home No. Bathrooms 4

☐ Business No. Employees

☐ Other

☑ Slab ☑ Crawl Space ☑ Basement w/plumbing ☐ Basement wo/plumbing


Water Supply: ☐ Individual ☑ Public ☑ Community

Comments:/Conditions:


Comments:/Conditions: (partial) Checked tanks, lines & pressure

1"=50'

INITIAL SITE SKETCH

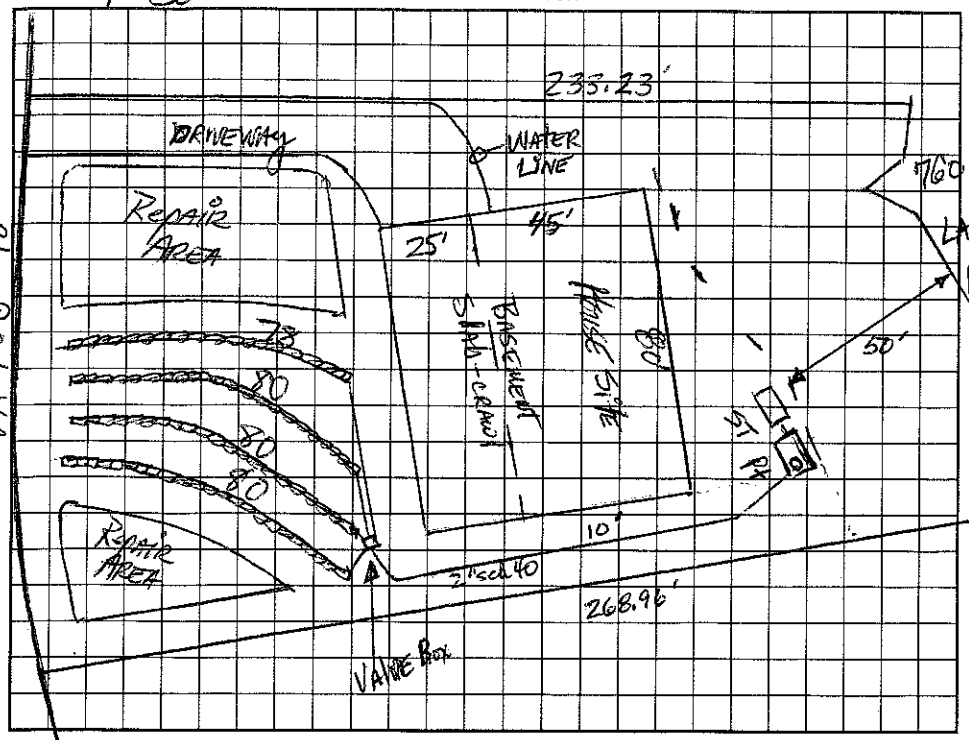

AS BUILT SKETCH

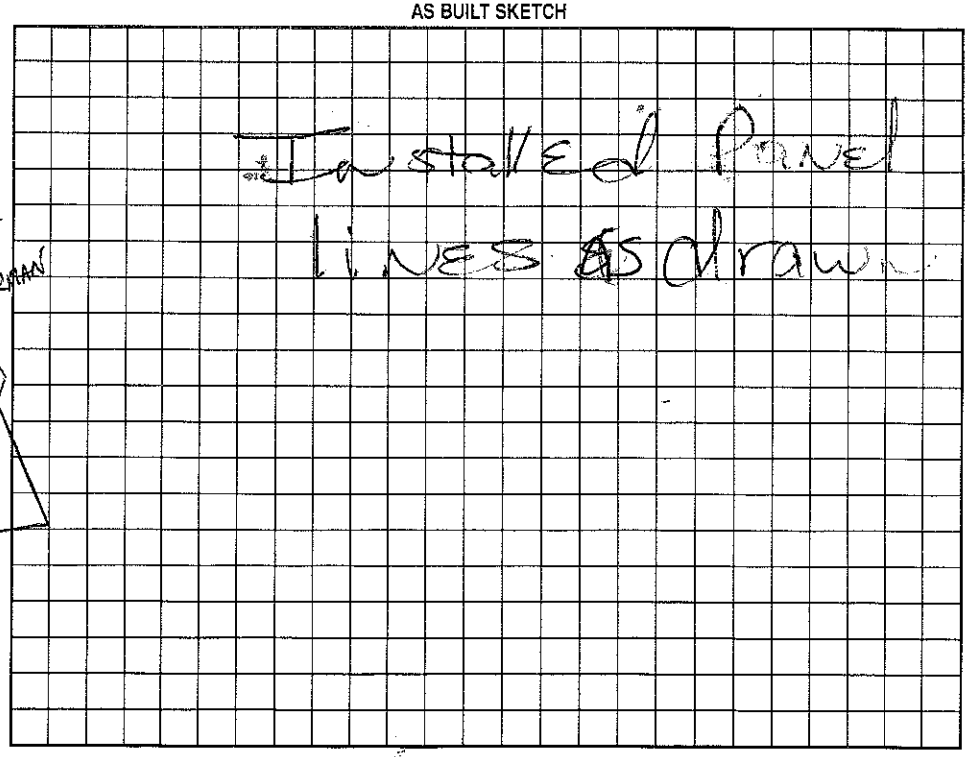

Permit can be suspended or revoked if any false information is supplied toward securing the permit/any unauthorized changes are made to the site/any unauthorized changes are made in the installation of the system. Improvement Permit with plat valid without expiration. Improvement Permit with site plan valid for sixty months. Authorization to Construct is valid for a period equal to that of Improvement Permit – not to exceed sixty months.

Signed: K.R. Polpis date 8-10-99

Improvement Permit by: David Lehman RS date 8-25-99

Authorization to Construct by: David Lehman RS date 10-6-00

Installed by: Wayne Orbinson

Operation Permit by: Wesley Sparks RS. date 9/11/01

Existing System Inspection by: date

HEALTH DEPT. COPY: WHITE OWNER COPY (FINAL): YELLOW OWNER COPY (INITIAL): PINK