IREDELL COUNTY HEALTH DEPARTMENT

STATESVILLE 704-878-5305 MOORESVILLE 704-664-5281

IMPROVEMENT PERMIT / AUTHORIZATION TO CONSTRUCT / OPERATION PERMIT / EXISTING SYSTEM INSPECTION

PERMIT# 137441 PIN# 4652517640 35 DATE 9-5-06

OWNER OR APPLICANT Paul & April Reeve PHONE: Business _____ Home 662-9563

ADDRESS 138 Brick Kiln Way Mooresville NC 28117

LOCATION Brawley School Rd TR Pelpis TL Jeremy Pt. TR Brick Kiln on right

SUBDIVISION The Pointe BLOCK / SECTION _____ LOT 524 LOT AREA .809 Acre SITE CLASS PS DESIGN FLOW 600gpd L.T.A.R. .3U

Septic Tank: 1500 Gallons; STB 3385 Date 11-15-06

Pump Tank: 1500 Gallons; PT 4511 Date 6-28-06

Pump Make: Myers Model MF50 Serial No. _____

Nitrification Field: No Fields 1 Square Feet 1500' Linear Feet 500'

No Lines 5 @ 100 Trench Width 36" Max Trench Bottom Depth 36" Gravel Depth N/A ☐ Gravity ☒ Pressure

☐ New System ☐ Repair ☐ Expansion System Type: I II III IV V VI

System Description: Existing pm-25% Reduction

Repair System Description: LP Panel Blk

Maintenance Agreement Required: ☐ Yes ☒ No

☒ House/Mod. ☐ Mobile Home ☐ Business ☐ Other

No. Bedrooms 5 No. Persons ___ No. Employees ___

Water Supply: ☐ Individual ☒ Public ☒ Community

☐ Slab ☐ Crawl Space ☒ Basement w/plumbing ☐ Basement wo/plumbing


Comments/Conditions: More tanks to accomodate Swimming pool. Install extra ST (1000g) then reinstall 1500 ST & 1500 PT

Comments/Conditions: Note: Sleeve Supply line under drive or bury > 30". ☆ Keep tanks 15Ft from stormdrain at least ~~5Ft~~ from house.

INITIAL SITE SKETCH

Checked 9/20/06 Settling tank 312 STB 7/1/06

AS BUILT SKETCH Original permit attached

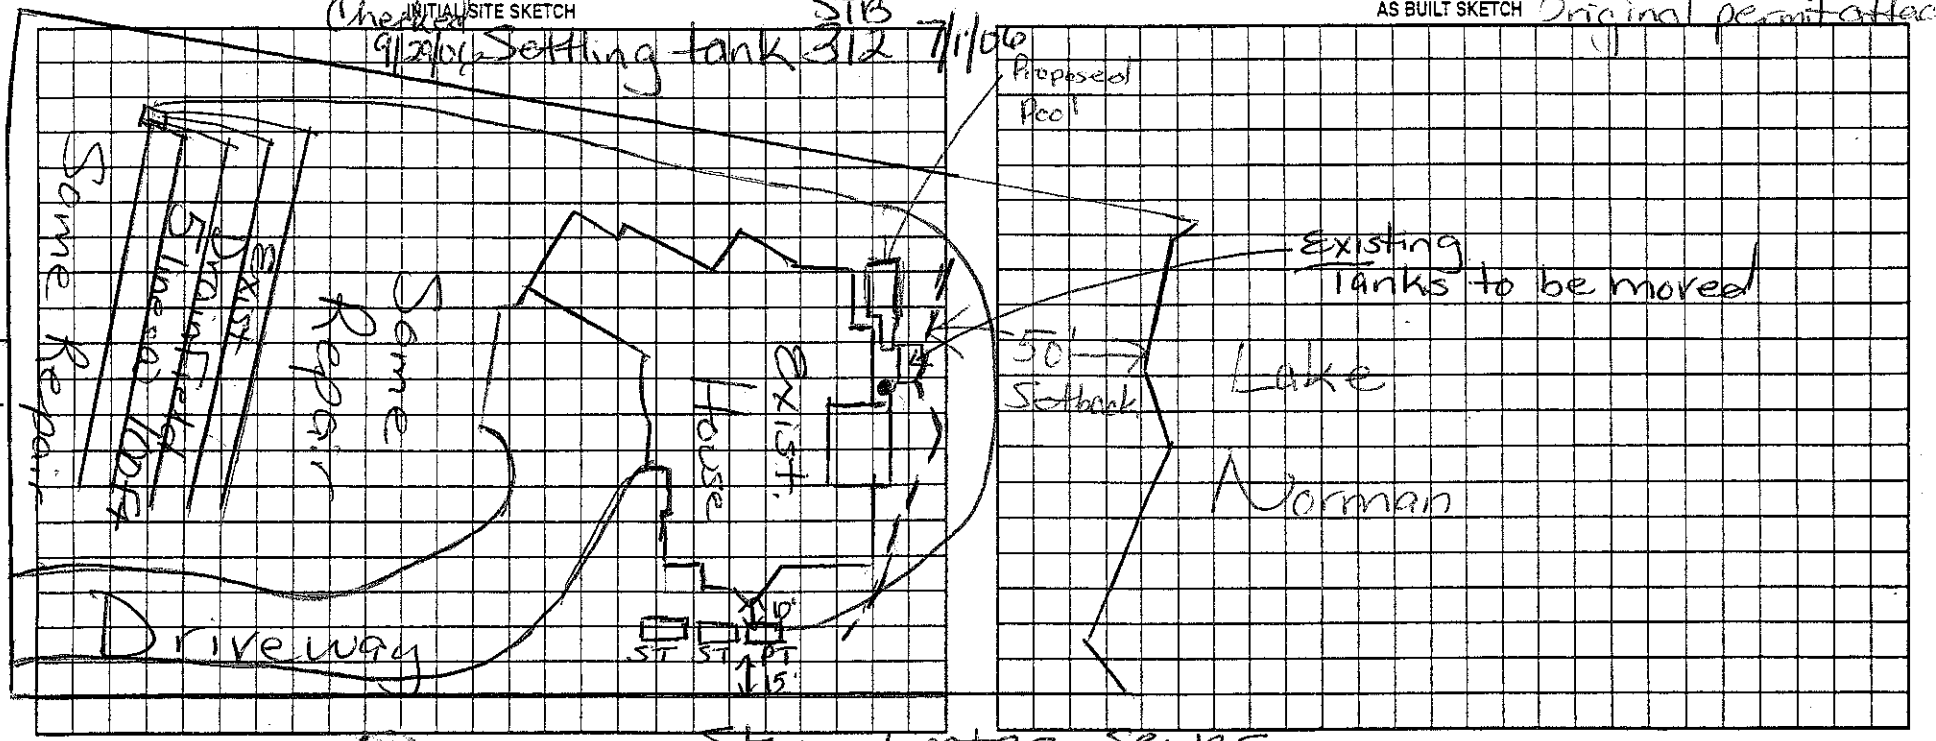

Permit can be suspended or revoked if any false information is supplied toward securing the permit/any unauthorized changes are made to the site/any unauthorized changes are made in the installation of the system. Improvement Permit with plat valid without expiration ☐ Improvement Permit with site plan valid for sixty months ☐ Authorization to Construct is valid for a period equal to that of Improvement Permit, not to exceed sixty months.

Signed: Paul Reeve date 9/7/06 Installed by: R&I Dotson RS

Improvement Permit by: Marvin H Dotson RS date 9/5/06 Operation Permit by: Marvin H Dotson date 10/9/06

Authorization to Construct by: Marvin H Dotson RS date 9/5/06 Existing System Inspection by: _____ date _____

HEALTH DEPT. COPY: WHITE OWNER COPY (FINAL): YELLOW OWNER COPY (INITIAL): PINK